


INSTRUCTIONS

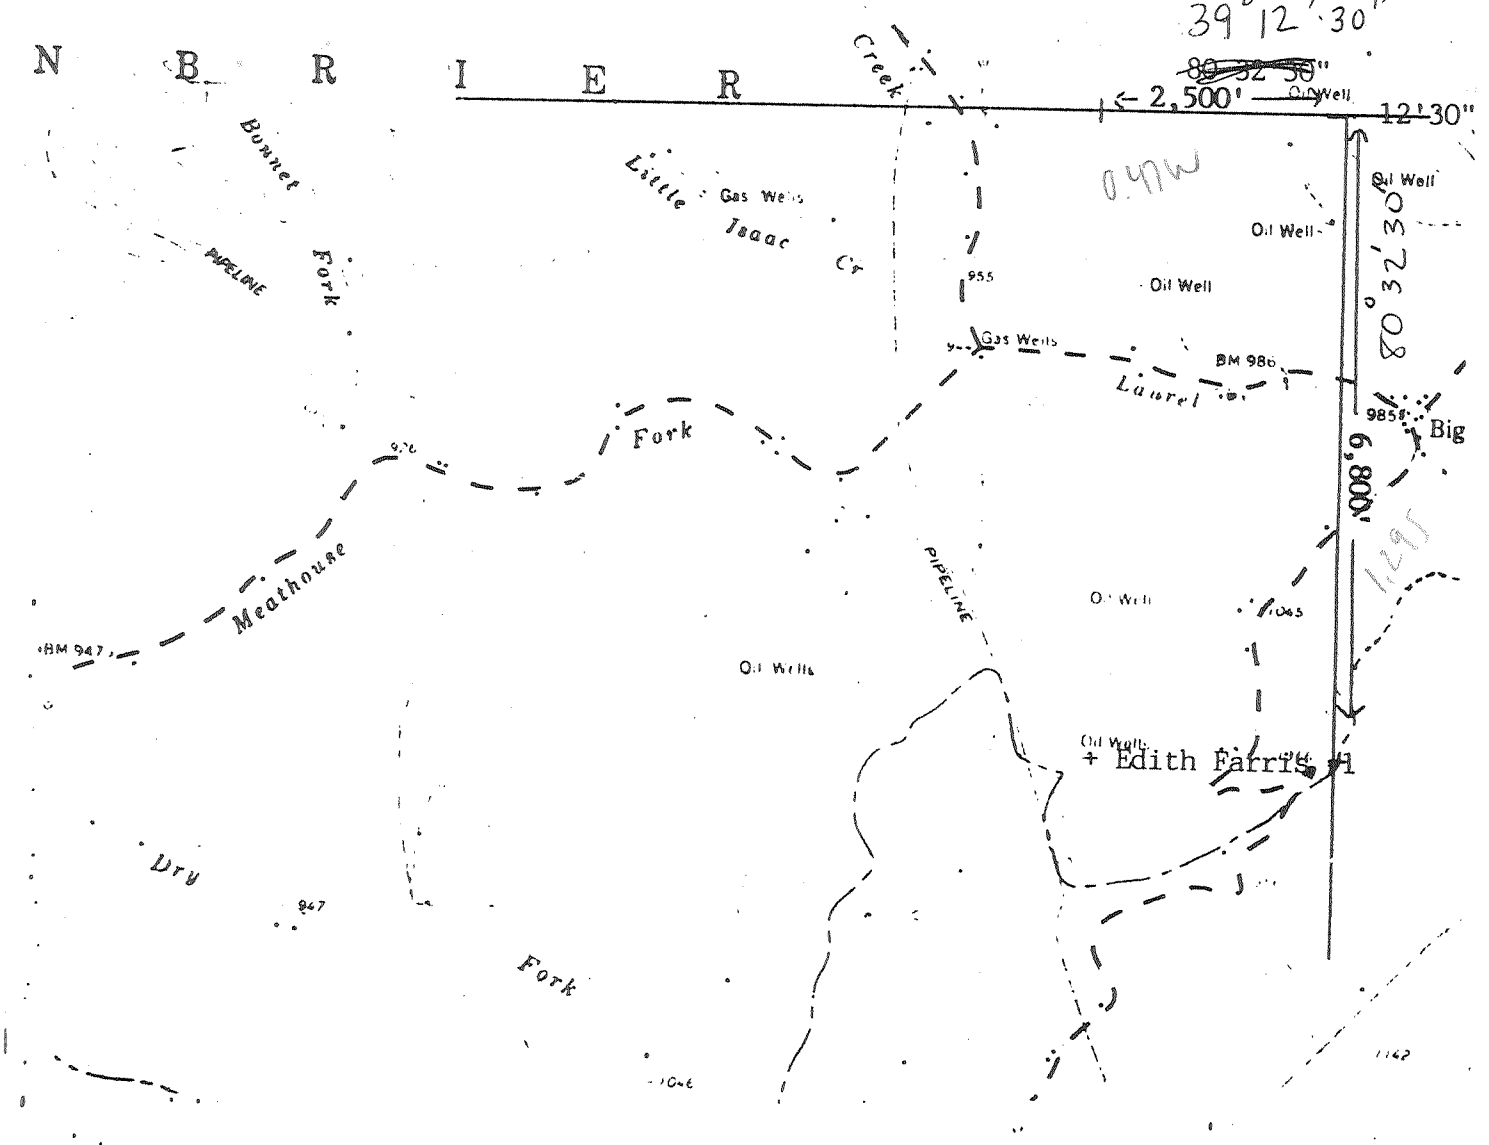

I, the undersigned, hereby certify that this plat is correct to the best of my knowledge and belief.

17515

RECEIVED
 W. Division of Environmental Protection
 JUN 29 1993
 Permitting Unit of Oil & Gas

SIGNED Thomas J. Fluharty
 TITLE President
 DATE June 21, 1993
 OPERATORS WELL NO. #1
 API WELL NO. 017-4090-N

STATE OF WEST VIRGINIA
 DEPARTMENT OF ENERGY
 OIL AND GAS DIVISION

WELL TYPE: OIL GAS LIQUID INJECTION _____ WASTE DISPOSAL _____
 (IE "GAS" PRODUCTION STORAGE _____ DEEP _____ SHALLOW

LOCATION: ELEVATION 1,440' WATER SHED Little Isaac Creek
 DISTRICT Greenbrier COUNTY Doddridge
 QUADRANGLE Big Isaac 252 Yashis (NE) 4.175 = 15'
2.700

SURFACE OWNER Unknown At This Time = UATT ACREAGE UATT

OIL & GAS ROYALTY OWNER Edith Farris LEASE ACREAGE UATT
 LEASE NO. UATT

PRODUCING FORMATION Big Injun TOTAL DEPTH UATT

WELL OPERATOR Fluharty Enterprises, Inc. DESIGNATED AGENT Thomas J. Fluharty

ADDRESS P. O. Box 226 ADDRESS P. O. Box 226
Salem, WV 26426 Salem, WV 26426

STATE OF WEST VIRGINIA
DIVISION OF ENVIRONMENTAL PROTECTION
SECTION OF OIL AND GAS

WELL REGISTER ASSIGNMENT

This API Number 47- 17-04090, issued to FLUHARTY ENTERPRISES, INC. is evidence of permission to operate the well that is referenced at the location described on the attached plat, subject to the provisions of Chapters 22 and 22B of the West Virginia Code of 1931, as amended, and all rules and regulations promulgated thereunder. The name and telephone number of the Oil and Gas Inspector for this well is MIKE UNDERWOOD -
304-782-1043.

Spills or emergency discharges must be reported to 1-800-654-3312.

Failure to abide by all statutory and regulatory provisions governing all duties and operations hereunder may result in suspension or revocation of your permits and in addition may result in civil and/or criminal penalties.

The enclosed WR-35 must be completed by you and returned to this office. In addition annual production reports must be submitted on this well and failure to do so may require you to plug the well.

Theodore M. Streit
Chief

By: 

Title: _____

Operator's Well No: EDITH FARRIS 1

Farm Name:

API Well Number : 47- 17-04090 N

Date Issued : 01/27/94