


80°32'30"

7,425'

Permitting
Office of Oil & Gas

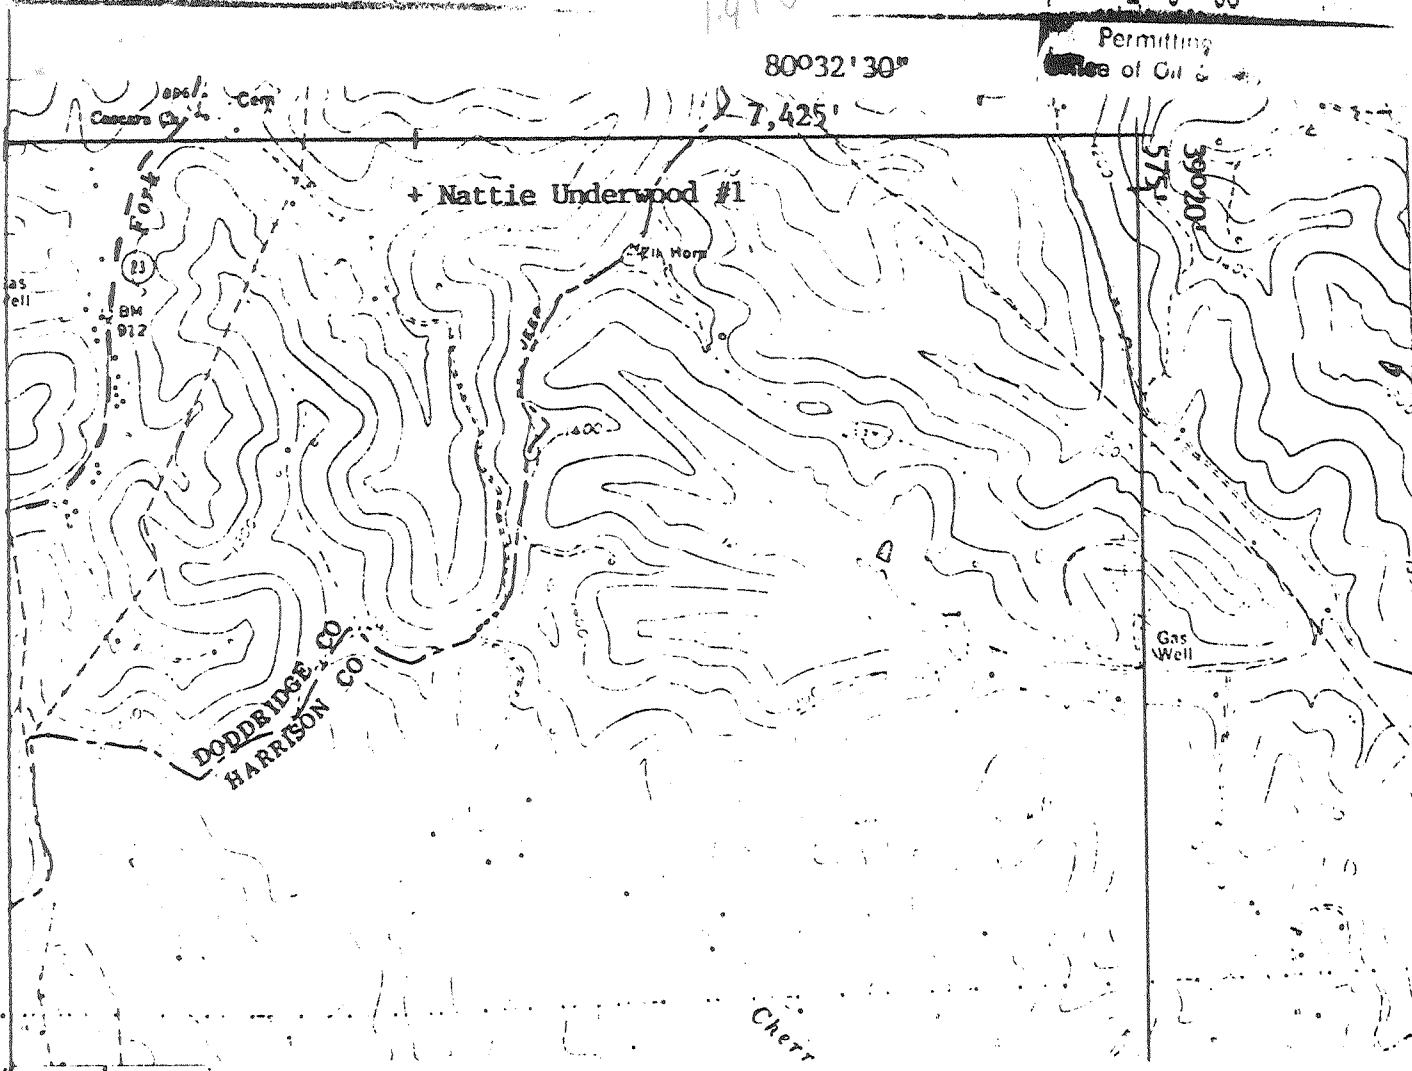

I, the undersigned, hereby certify that this plat is correct to the best of my knowledge and belief.

SIGNED Thomas J. Flubarty
TITLE President

17504

*Calc 15' loc
0.105
3.64W*

DATE June 21, 19 93
OPERATORS WELL NO. #1
API WELL NO. 017-4102-W

STATE OF WEST VIRGINIA
DEPARTMENT OF ENERGY
OIL AND GAS DIVISION

WELL TYPE: OIL GAS LIQUID INJECTION _____ WASTE DISPOSAL _____
IF "GAS" PRODUCTION STORAGE _____ DEEP _____ SHALLOW

LOCATION: ELEVATION 980' WATER SHED Trib. of Robinson Fork
DISTRICT McClelland COUNTY Doddridge
QUADRANGLE Salem 595 Centerpoint SE

SURFACE OWNER Unknown At This Time = UATT ACREAGE UATT

OIL & GAS ROYALTY OWNER Nattie Underwood LEASE ACREAGE UATT
LEASE NO. UATT

PRODUCING FORMATION Big Injun TOTAL DEPTH UATT

WELL OPERATOR Flubarty Enterprises, Inc. DESIGNATED AGENT Thomas J. Flubarty

ADDRESS P. O. Box 226 ADDRESS P. O. Box 226
Salem, WV 26426 Salem, WV 26426

STATE OF WEST VIRGINIA
DIVISION OF ENVIRONMENTAL PROTECTION
SECTION OF OIL AND GAS

WELL REGISTER ASSIGNMENT

This API Number 47- 17-04102, issued to FLUHARTY ENTERPRISES, INC. is evidence of permission to operate the well that is referenced at the location described on the attached plat, subject to the provisions of Chapters 22 and 22B of the West Virginia Code of 1931, as amended, and all rules and regulations promulgated thereunder. The name and telephone number of the Oil and Gas Inspector for this well is MIKE UNDERWOOD - 304-782-1043.

Spills or emergency discharges must be reported to 1-800-654-3312.

Failure to abide by all statutory and regulatory provisions governing all duties and operations hereunder may result in suspension or revocation of your permits and in addition may result in civil and/or criminal penalties.

The enclosed WR-35 must be completed by you and returned to this office. In addition annual production reports must be submitted on this well and failure to do so may require you to plug the well.

Theodore M. Streit
Chief

By: 

Title: _____

Operator's Well No: N. UNDERWOOD 1

Farm Name:

API Well Number : 47- 17-04102 N

Date Issued : 02/07/94