


LATITUDE 39° 15' 00"


LONGITUDE 80° 45' 00"

HENDERSON LEASE 1567.64 ACRES PALETTI # 1

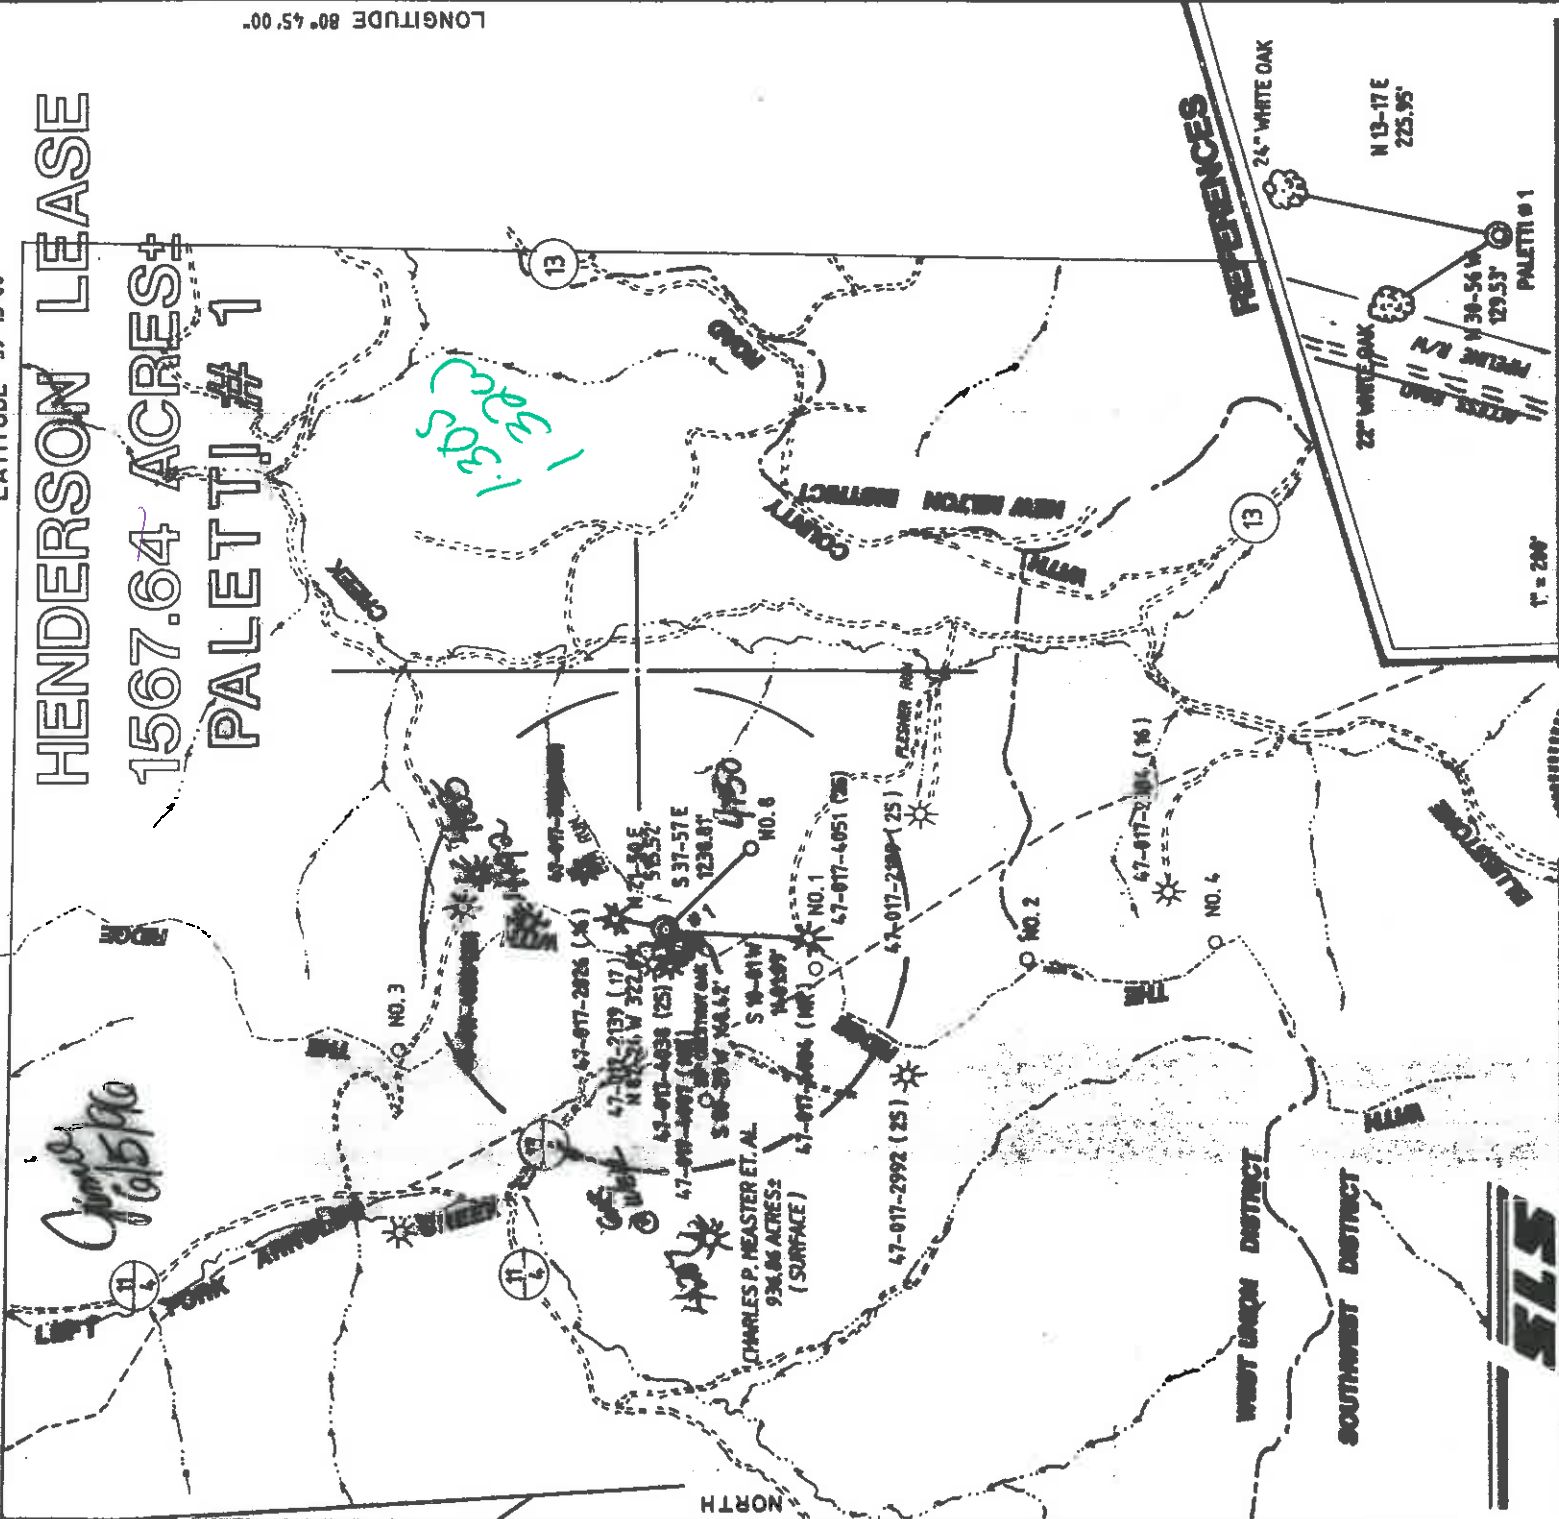

I THE UNDERSIGNED, HEREBY CERTIFY THAT THIS PLAT IS CORRECT TO THE BEST OF MY KNOWLEDGE AND BELIEF AND SHOWS ALL THE INFORMATION REQUIRED BY LAW AND THE REGULATIONS ISSUED AND PRESCRIBED BY THE DEPARTMENT OF ENERGY.

L.L.S. *Gregory A. Smith*
677

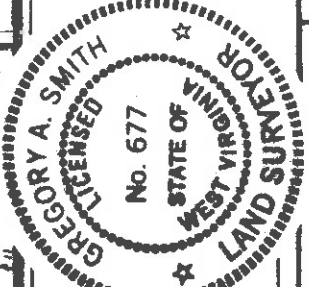

(+) DENOTES LOCATION OF WELL ON UNITED STATES TOPOGRAPHIC MAPS.
DATE MAY 16, 1994.
OPERATORS WELL NO. PALETTI # 1

API WELL NO. 47-017-041297
STATE COUNTY PERMIT

STATE OF WEST VIRGINIA
DEPARTMENT OF ENERGY
OIL AND GAS DIVISION

MINIMUM DEGREE OF ACCURACY 1/200
PROVEN SOURCE OF ELEVATION U.S.G.S. STA. MAXWELL ELEVATION 1395'
SCALE 1" = 2000'

WELL TYPE: OIL GAS LIQUID INJECTION WASTE DISPOSAL IF "GAS" PRODUCTION STORAGE DEEP SHALLOW

LOCATION: ELEVATION 1117' WATERSHED ELM RUN OF BURLSTONE CREEK
DISTRICT WEST UNION COUNTY DOUGHERSSIE

SURFACE OWNER JUSTIN M. HENDERSON
ROYALTY OWNER JUSTIN M. HENDERSON ET AL.

PROPOSED WORK:
DRILL CONVERT DRILL DEEPER REDRILL FRACTURE OR STIMULATE PLUG OFF OLD FORMATION PERFORATE NEW FORMATION PLUG AND ABANDON CLEAN OUT AND REPLUG OTHER

PHYSICAL CHANGE IN WELL (SPECIFY)
Face splitting with Stone separator

WELL OPERATOR ANVIL OIL CO. INC. DESIGNATED AGENT JUSTIN L. HENDERSON
ADDRESS P.O. BOX 1230 FAIRMONT, WY. 26554-1230

County Name D000
Permit 4129