


NOTES ON SURVEY

1. TIES TO WELLS AND CORNERS ARE BASED ON STATE PLANE GRID NORTH WV NORTH ZONE NAD '83.
2. LEASE BOUNDARY SHOWN HEREON TAKEN FROM A TITLE REPORT DATED 9/2/98 PREPARED BY RICHARD M. REDDECLIFF.
3. SURFACE OWNERS AND ADJOINER INFORMATION OBTAINED FROM THE ASSESSOR AND COUNTY CLERK RECORDS OF DODDRIE COUNTY IN SEPTEMBER 1998.
4. WELL LAT. LONG. ESTABLISHED BY DGPS (SUBMETER MAPPING GRADE).
5. TIES TO REFERENCES ARE BASED ON MAGNETIC NORTH 9/11/88.

REFERENCES

1. DENOTES LOCATION OF WELL ON UNITED STATES TOPOGRAPHIC MAPS.
- DATE SEPTEMBER 16, 19 98
- OPERATORS WELL NO. STATLER NO. 1
- API WELL NO. 47-017-0749

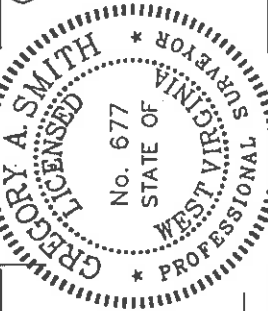

I THE UNDERSIGNED, HEREBY CERTIFY THAT THIS PLAT IS CORRECT TO THE BEST OF MY KNOWLEDGE AND BELIEF AND SHOWS ALL THE INFORMATION REQUIRED BY LAW AND THE REGULATIONS ISSUED AND PRESCRIBED BY: THE DEPARTMENT OF ENERGY.

P.S. *Gregory A. Smith*
677

MINIMUM DEGREE OF ACCURACY 1 / 200 FILE NO. 4061P1 (69-33)
PROVEN SOURCE SCALE 1" = 500'
OF ELEVATION JUNCTION OF ROADS ELEVATION 839'

WELL TYPE : OIL ___ GAS INJECTION ___ WASTE ___ LIQUID ___
IF "GAS" PRODUCTION STORAGE ___ DEEP ___ SHALLOW ___ X

LOCATION : ELEVATION 972' WATERSHED LONG RUN
DISTRICT CENTRAL COUNTY DODDRIE

SURFACE OWNER CAROL L. VINCENT
ROYALTY OWNER ROSALEE S. WILSON ET AL

PROPOSED WORK :
DRILL ___ X ___ CONVERT ___ DRILL DEEPER ___ REDRILL ___ FRACTURE OR STIMULATE ___ X ___ PLUG OFF OLD
FORMATION ___ PERFORATE NEW FORMATION ___ PLUG AND ABANDON ___ CLEAN OUT AND REPLUG ___ OTHER ___
PHYSICAL CHANGE IN WELL (SPECIFY) TARGET FORMATION ALEXANDER
ESTIMATED DEPTH 5600'


WELL OPERATOR KEY OIL COMPANY DESIGNATED AGENT JAN CHAPMAN
ADDRESS 22 GARTON PLAZA WESTON, WV 26452 ADDRESS 22 GARTON PLAZA WESTON, WV 26452



STATE OF WEST VIRGINIA
DIVISION OF ENVIRONMENTAL PROTECTION
OFFICE OF OIL AND GAS

COUNTY NAME DODD PERMIT 14791

WR-35

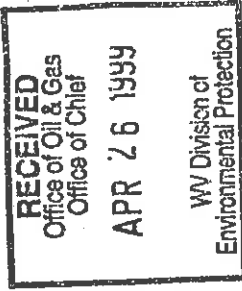

State of West Virginia
Division of Environmental Protection
Section of Oil and Gas

06 - Nov - 98
API # 47 - 17 - 4491

Reviewed [Signature]

Well Operator's Report of Well Work

Farm name: VINCENT, CAROLL

Operator Well No. : STATLER #1

LOCATION: Elevation: 972.00

Quadrangle: WEST UNION

District: CENTRAL

County: DODDRIDGE

Latitude: 14900 Feet South of 39 Deg. 20 Min. 00 Sec.

Longitude: 8790 Feet West of 80 Deg. 50 Min. 00 Sec.

Company: KEY OIL COMPANY
22 GARTON PLAZA
WESTON, WV 26452-0000

Agent: JAN E. CHAPMAN

Inspector: MIKE UNDERWOOD
Permit Issued: 11/06/98
Well Work Commenced: 12/04/98
Well Work Completed: 12/08/98

Verbal Plugging

Permission granted on: _____
Rotary X Cable _____ Rig

Total Depth (feet) 5294'

Fresh water depths (ft) 100', 170'

Salt water depths (ft) NONE

Is coal being mined in area (Y / N)? N
Coal Depths (ft): 130' (4')

OPEN FLOW DATA

Producing formation	Alexander	Pay zone depth (ft)	5061' - 5147'
Gas: Initial open flow	33 MCF / d	Oil: Initial open flow	0 Bbl / d
Final open flow	1,532 MCF / d	Oil: Final open flow	show Bbl / d
Time of open flow between initial and final tests	N/A	Hours	Hours
Static rock pressure	1700 psig (surface pressure)	after	96 Hours

Second producing formation	Commingled	Pay zone depth (ft)	_____
Gas: Initial open flow	_____ MCF / d	Oil: Initial open flow	_____ Bbl / d
Final open flow	_____ MCF / d	Oil: Final open flow	_____ Bbl / d
Time of open flow between initial and final tests	_____	Hours	Hours
Static rock pressure	_____ psig (surface pressure)	after	_____ Hours

NOTE: ON BACK OF THIS FORM PUT THE FOLLOWING: 1). DETAILS OF PERFORATED INTERVALS, FRACTURING OR STIMULATING, PHYSICAL CHANGE, ETC. 2). THE WELL LOG WHICH IS A SYSTEMATIC DETAILED GEOLOGICAL RECORD OF ALL FORMATIONS, INCLUDING COAL ENCOUNTERED BY THE WELLBORE.

For: KEY OIL COMPANY

By: [Signature]
Date: April 21, 1999

PRESIDENT

MAY 3 1999

D000 4491

