

4701704540P

WW-7  
8-30-06



West Virginia Department of Environmental Protection  
Office of Oil and Gas  
**WELL LOCATION FORM: GPS**

API: 47-017-04540 WELL NO.: 8

FARM NAME: Cunningham

RESPONSIBLE PARTY NAME: Diversified Production LLC

COUNTY: Doddridge DISTRICT: Central

QUADRANGLE: Oxford

SURFACE OWNER: Judy A. Horton/ Peter A. Gregori

ROYALTY OWNER: Diversified Production, LLC

UTM GPS NORTHING: 4,342,850

UTM GPS EASTING: 513,462 GPS ELEVATION: 1124'

The Responsible Party named above has chosen to submit GPS coordinates in lieu of preparing a new well location plat for a plugging permit or assigned API number on the above well. The Office of Oil and Gas will not accept GPS coordinates that do not meet the following requirements:

1. Datum: NAD 1983, Zone: 17 North, Coordinate Units: meters, Altitude: height above mean sea level (MSL) – meters.
2. Accuracy to Datum – 3.05 meters
3. Data Collection Method:

Survey grade GPS  : Post Processed Differential

Real-Time Differential

Mapping Grade GPS  : Post Processed Differential

Real-Time Differential

4. Letter size copy of the topography map showing the well location.

I the undersigned, hereby certify this data is correct to the best of my knowledge and belief and shows all the information required by law and the regulations issued and prescribed by the Office of Oil and Gas.

	Director Production	11/5/2021
Signature	Title	Date

RECEIVED  
Office of Oil and Gas  
NOV 15 2021  
WV Department of  
Environmental Protection

12/03/2021




Diversified Gas & Oil  
Corporation  
100 Diversified Way  
Pikeville KY, 41051

47-017-04540

Plugging Map

### Legend

-  Well
-  Access Road
-  Pits
-  Pad
-  Public Roads

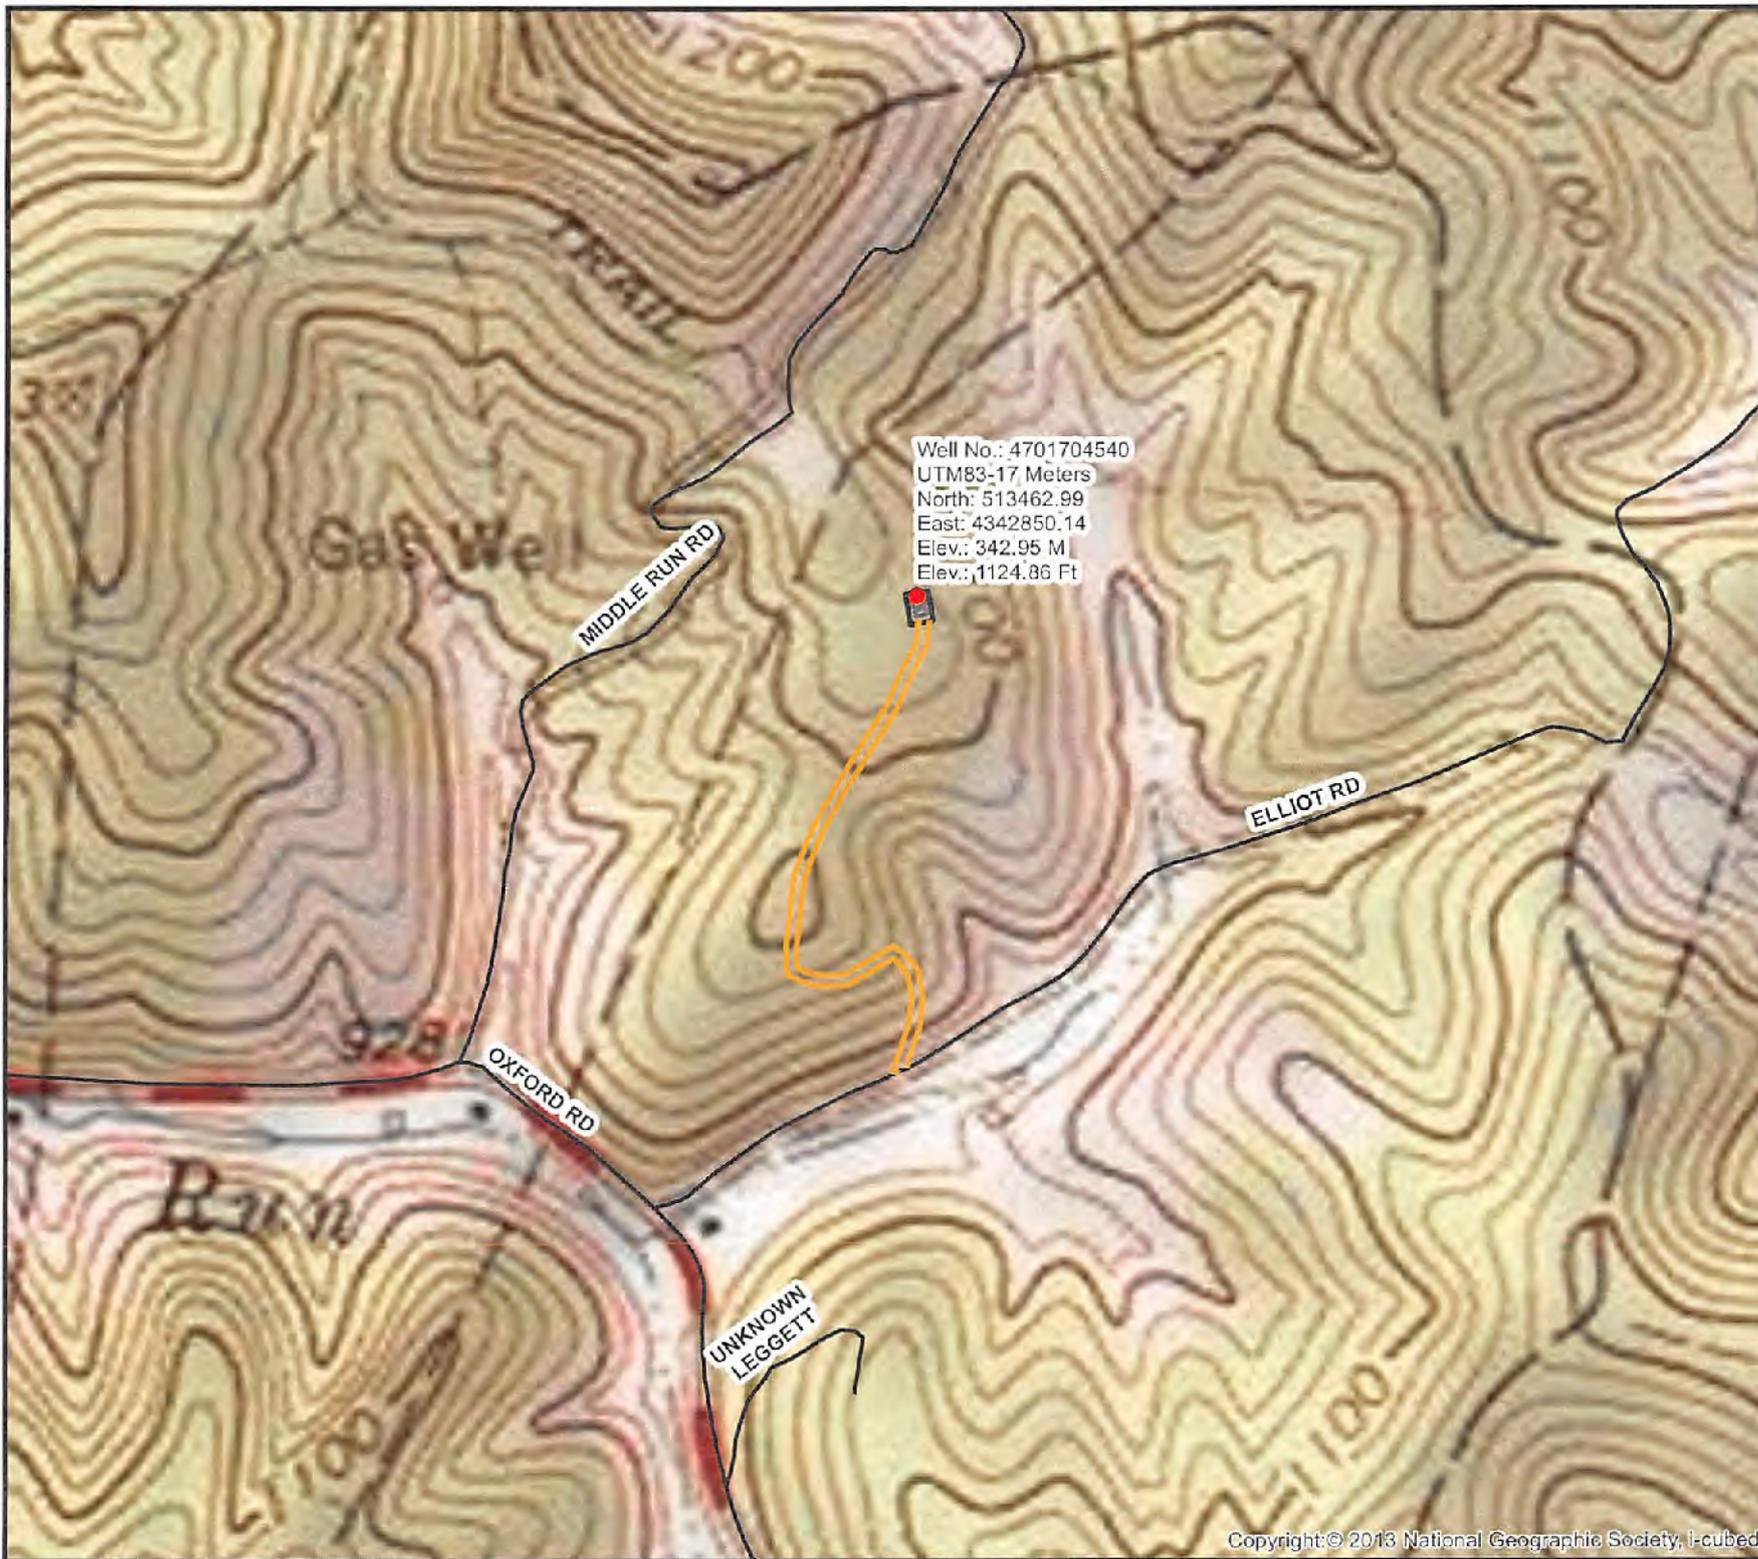

Well No.: 4701704540  
UTM83-17, Meters  
North: 513462.99  
East: 4342850.14  
Elev.: 342.95 M  
Elev.: 1124.86 Ft

