

WW-7
8-30-06



West Virginia Department of Environmental Protection
Office of Oil and Gas
WELL LOCATION FORM: GPS

API: 17-04579 WELL NO.: Flodak #3

FARM NAME: Powell, Dennis

RESPONSIBLE PARTY NAME: Powell, Dennis

COUNTY: Doddridge DISTRICT: Grant 3

QUADRANGLE: Smithburg, WV 611

SURFACE OWNER: Powell, Dennis

ROYALTY OWNER: Powell, Dennis

UTM GPS NORTHING: 4347385.2

UTM GPS EASTING: 527084.5 GPS ELEVATION: 278.89

The Responsible Party named above has chosen to submit GPS coordinates in lieu of preparing a new well location plat for a plugging permit or assigned API number on the above well. The Office of Oil and Gas will not accept GPS coordinates that do not meet the following requirements:

1. Datum: NAD 1983, Zone: 17 North, Coordinate Units: meters, Altitude: height above mean sea level (MSL) – meters.
2. Accuracy to Datum – 3.05 meters
3. Data Collection Method:

Survey grade GPS : Post Processed Differential

Real-Time Differential

Mapping Grade GPS : Post Processed Differential

Real-Time Differential

4. Letter size copy of the topography map showing the well location.

I the undersigned, hereby certify this data is correct to the best of my knowledge and belief and shows all the information required by law and the regulations issued and prescribed by the Office of Oil and Gas.

Dennis Powell
Signature

owner
Title


Received
Office of Oil & Gas
10 OCT 1 2014
Date

17-04579

FORM WW-9

page 6 of 7

FLODAK LEASE WELL NO. 3

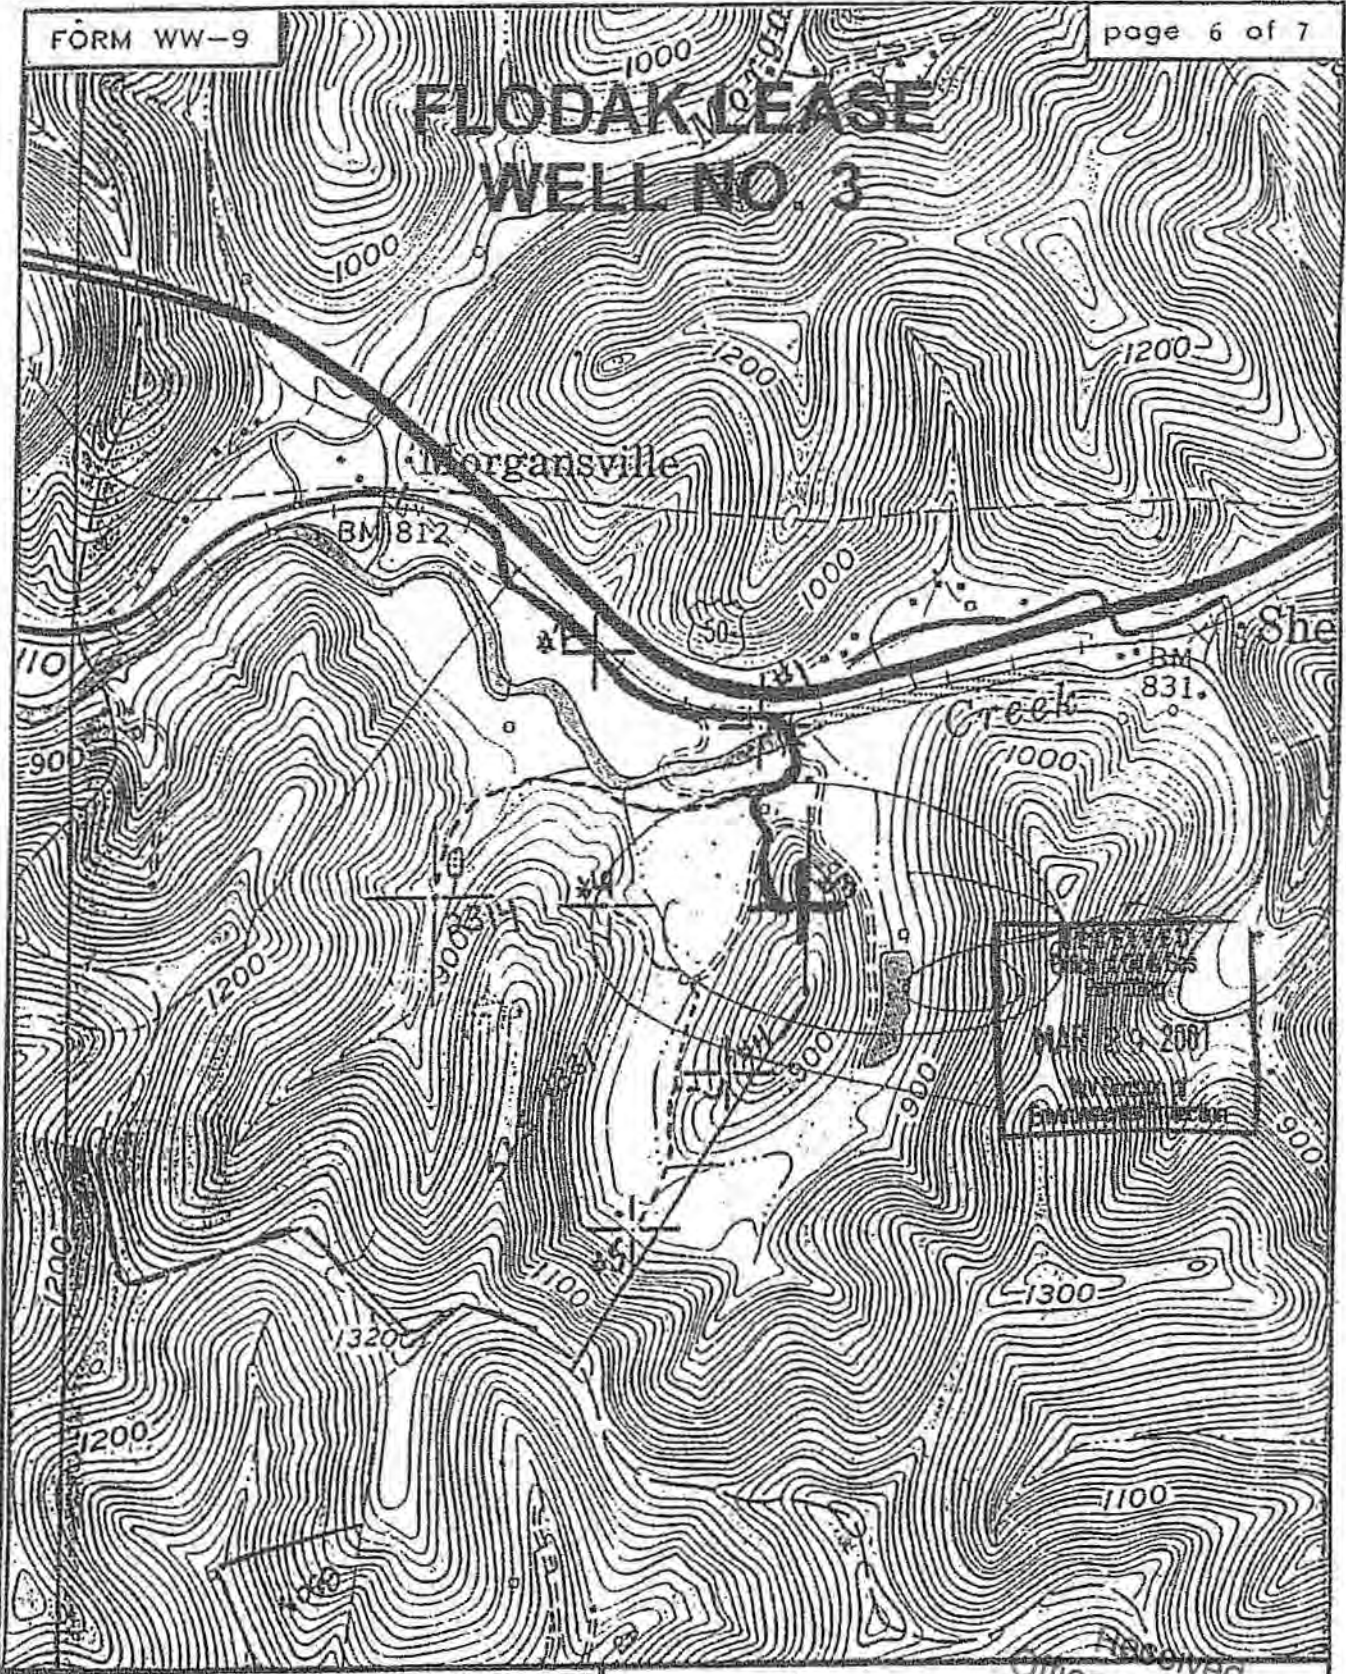

RECEIVED
 OCT 20 2001
 OFFICE OF
 OIL & GAS

Received
 Office of Oil & Gas
 OCT 06 2001
 SCALE 1"=1000'



SMITH LAND SURVEYING
 P.O. BOX 150 GLENVILLE, WV. 26351

TOPO SECTION OF

Smithburg 7.5'

FILE NO. 4331

DATE 1/02/01

SCALE 1"=1000'