

West Virginia Department of Environmental Protection
Office of Oil & Gas
WELL LOCATION FORM: GPS

API: 47- 017 -04846 WELL NO: 18

FARM NAME: Dorsey Baker Hrs. 18

RESPONSIBLE PARTY NAME: H.G. Energy, LLC

COUNTY: Doddridge DISTRICT: McClellan

QUADRANGLE: Centerpoint 7.5'

SURFACE OWNER: Dorsey Baker Estate

ROYALTY OWNER: Ascent Resources

UTM GPS NORTHING: 4,364,633 (NAD 83)

UTM GPS EASTING: 526,246 (NAD 83) GPS ELEVATION: 395 m. (1296')

The Responsible Party named above has chosen to submit GPS coordinates in lieu of preparing a new well location plat for a plugging permit on the above well. The Office of Oil & Gas will not accept GPS coordinates that do not meet the following requirements:

1. Datum: NAD 1983, Zone: 17 North, Coordinate Units: meters, Altitude: height above mean sea level (MSL) - meters.
2. Accuracy to Datum - 3.05 meters
3. Data Collection Method:

Survey Grade GPS	<input type="checkbox"/>	Post Processed Differential	<input type="checkbox"/>
		Real-Time Differential	<input type="checkbox"/>
Mapping Grade GPS	<input checked="" type="checkbox"/>	Post Processed Differential	<input checked="" type="checkbox"/>
		Real-Time Differential	<input type="checkbox"/>

I the undersigned, hereby certify this data is correct to the best of my knowledge and belief and shows all the information required by law and the regulations issued and prescribed by the Office of Oil and Gas.


Received
Office of Oil & Gas
JUN 16 2016

Diane White Diane C. White
Signature

Designated Agent
Title

May 4, 2016
Date

SUBJECT WELL
Dorsey Baker Hrs. No. 18
47-017-4846

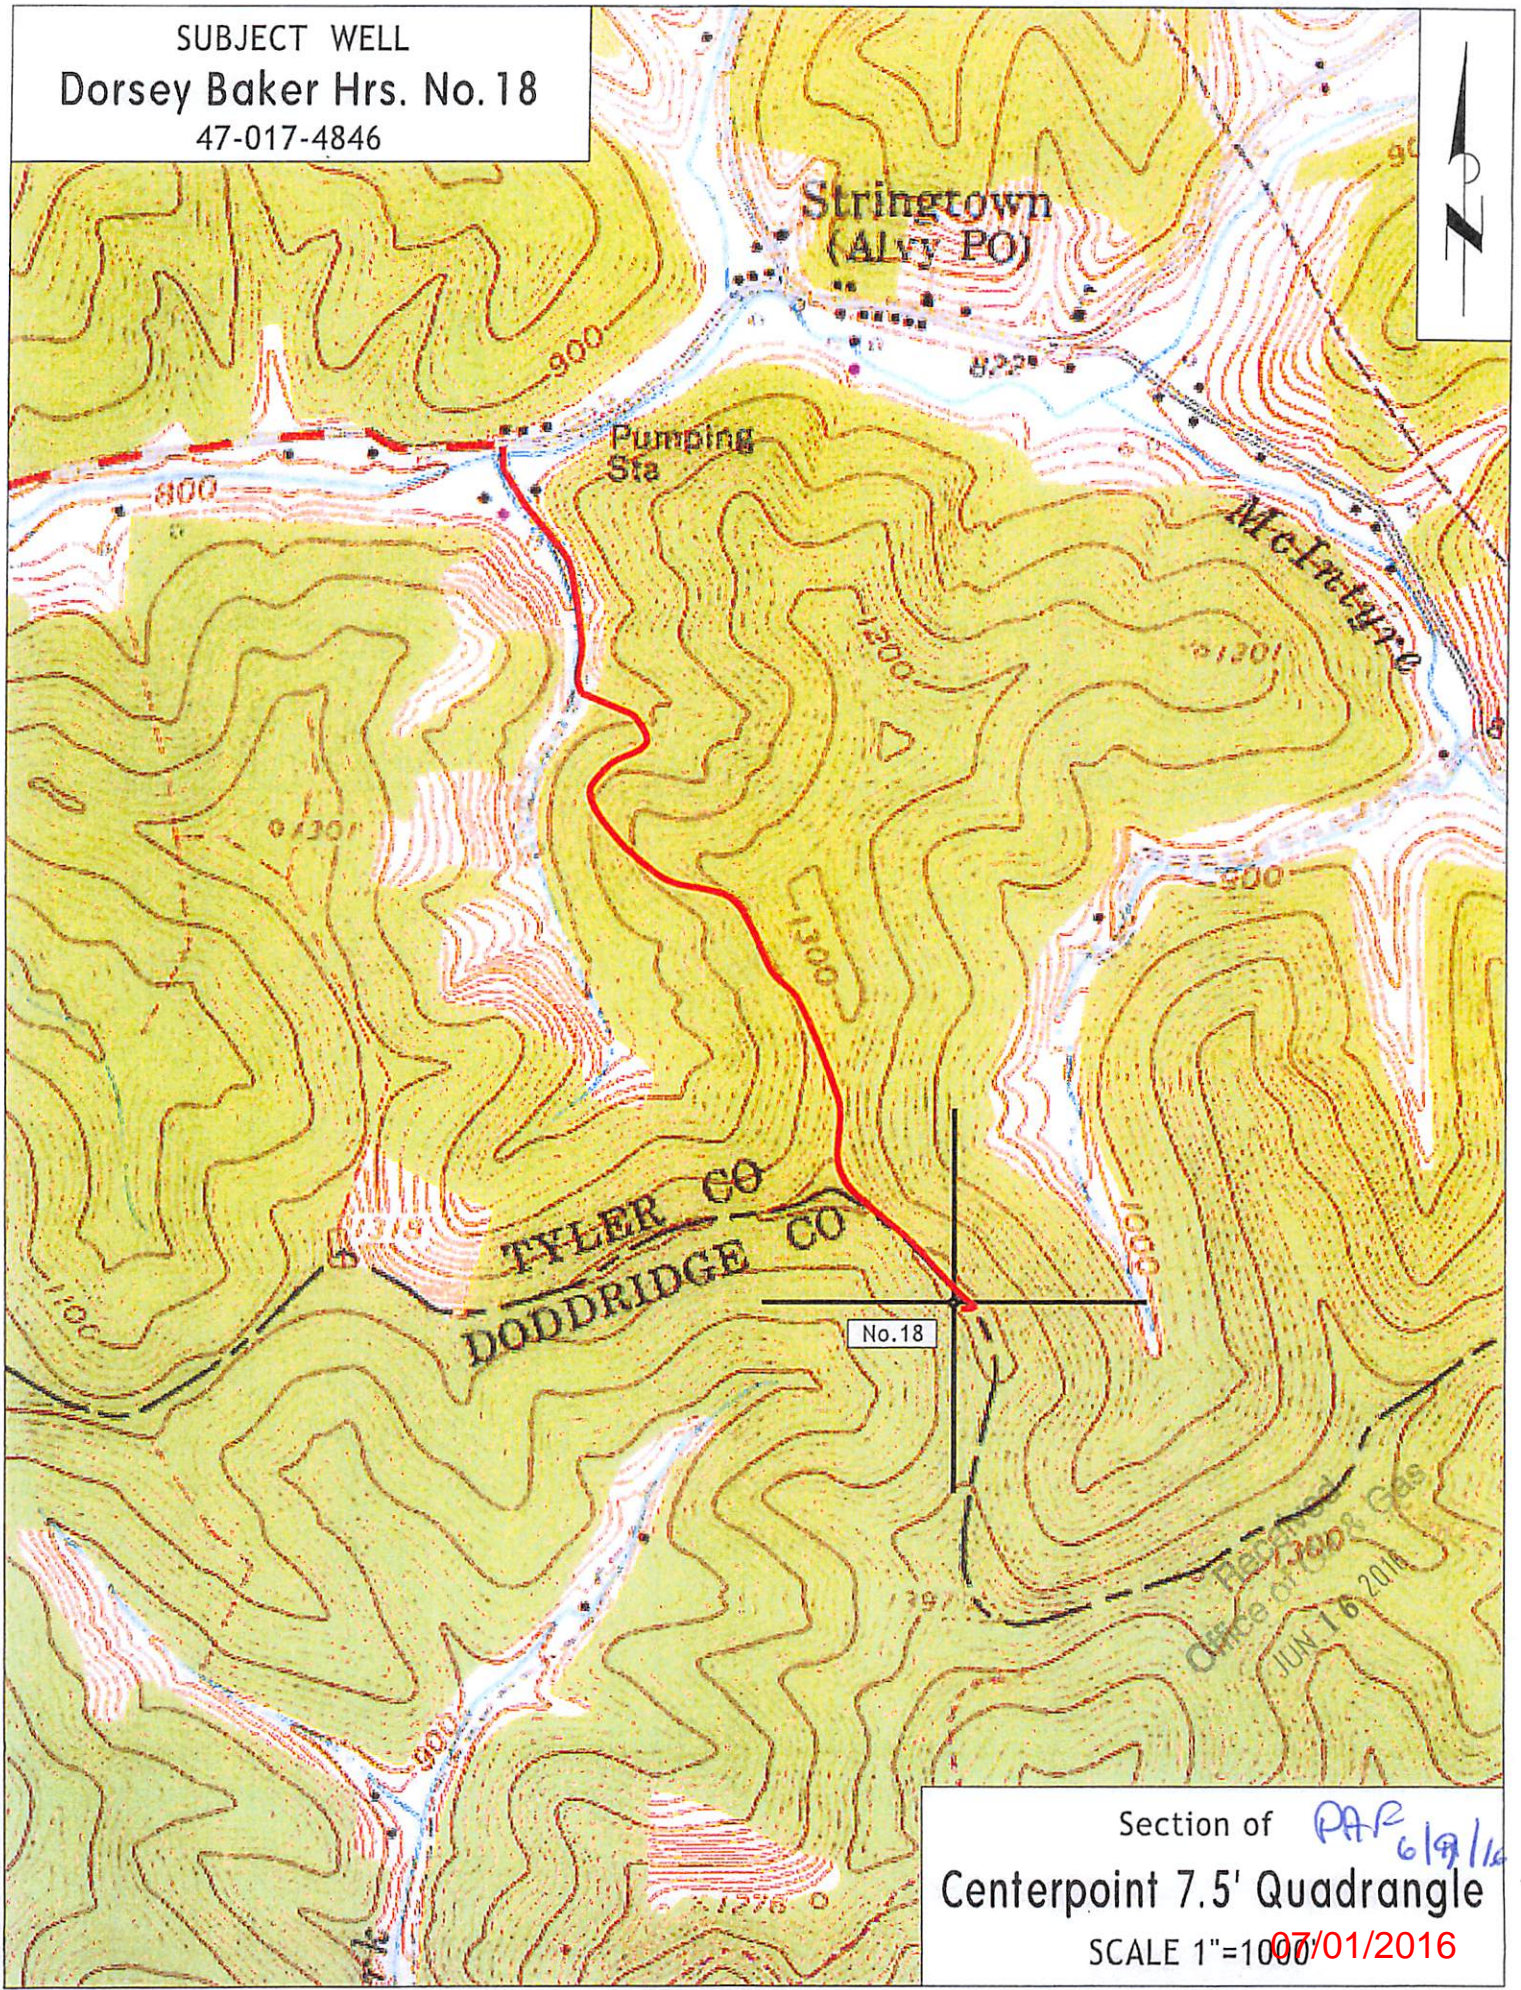

RECEIVED
Office of Gas
JUN 16 2016

Section of *PAR 6/9/16*
Centerpoint 7.5' Quadrangle
SCALE 1"=1000 *07/01/2016*