

West Virginia Department of Environmental Protection
Office of Oil & Gas

WELL LOCATION FORM: GPS

API: 47- 017 - 5552 WELL NO: 3

FARM NAME: Pike Lease

RESPONSIBLE PARTY NAME: DAC Energy, LLC

COUNTY: Doddridge DISTRICT: McClellan

QUADRANGLE: Folsom 7.5'

SURFACE OWNER: Statoil

ROYALTY OWNER: C. Jack Lemasters Hrs.

UTM GPS NORTHING: 4,359,906 (NAD 83)


UTM GPS EASTING: 538,017 (NAD 83) GPS ELEVATION: 287 m. (942')

The Responsible Party named above has chosen to submit GPS coordinates in lieu of preparing a new well location plat for a plugging permit on the above well. The Office of Oil & Gas will not accept GPS coordinates that do not meet the following requirements:

1. Datum: NAD 1983, Zone:17 North, Coordinate Units: meters, Altitude: height above mean sea level (MSL) - meters.
2. Accuracy to Datum - 3.05 meters
3. Data Collection Method:

Survey Grade GPS	<input type="checkbox"/>	Post Processed Differential	<input type="checkbox"/>
		Real-Time Differential	<input type="checkbox"/>
Mapping Grade GPS	<input checked="" type="checkbox"/>	Post Processed Differential	<input checked="" type="checkbox"/>
		Real-Time Differential	<input type="checkbox"/>

I the undersigned, hereby certify this data is correct to the best of my knowledge and belief and shows all the information required by law and the regulations issued and prescribed by the Office of Oil and Gas.

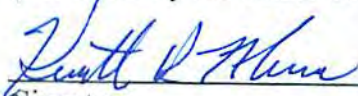
Signature Kenneth R. Mason


May 11, 2015
Date

President RECEIVED
Title Office of Oil and Gas

AUG 20 2015

WV Department of Environmental Protection
10/09/2015

SUBJECT WELL
Pike No.3
47-017-05552

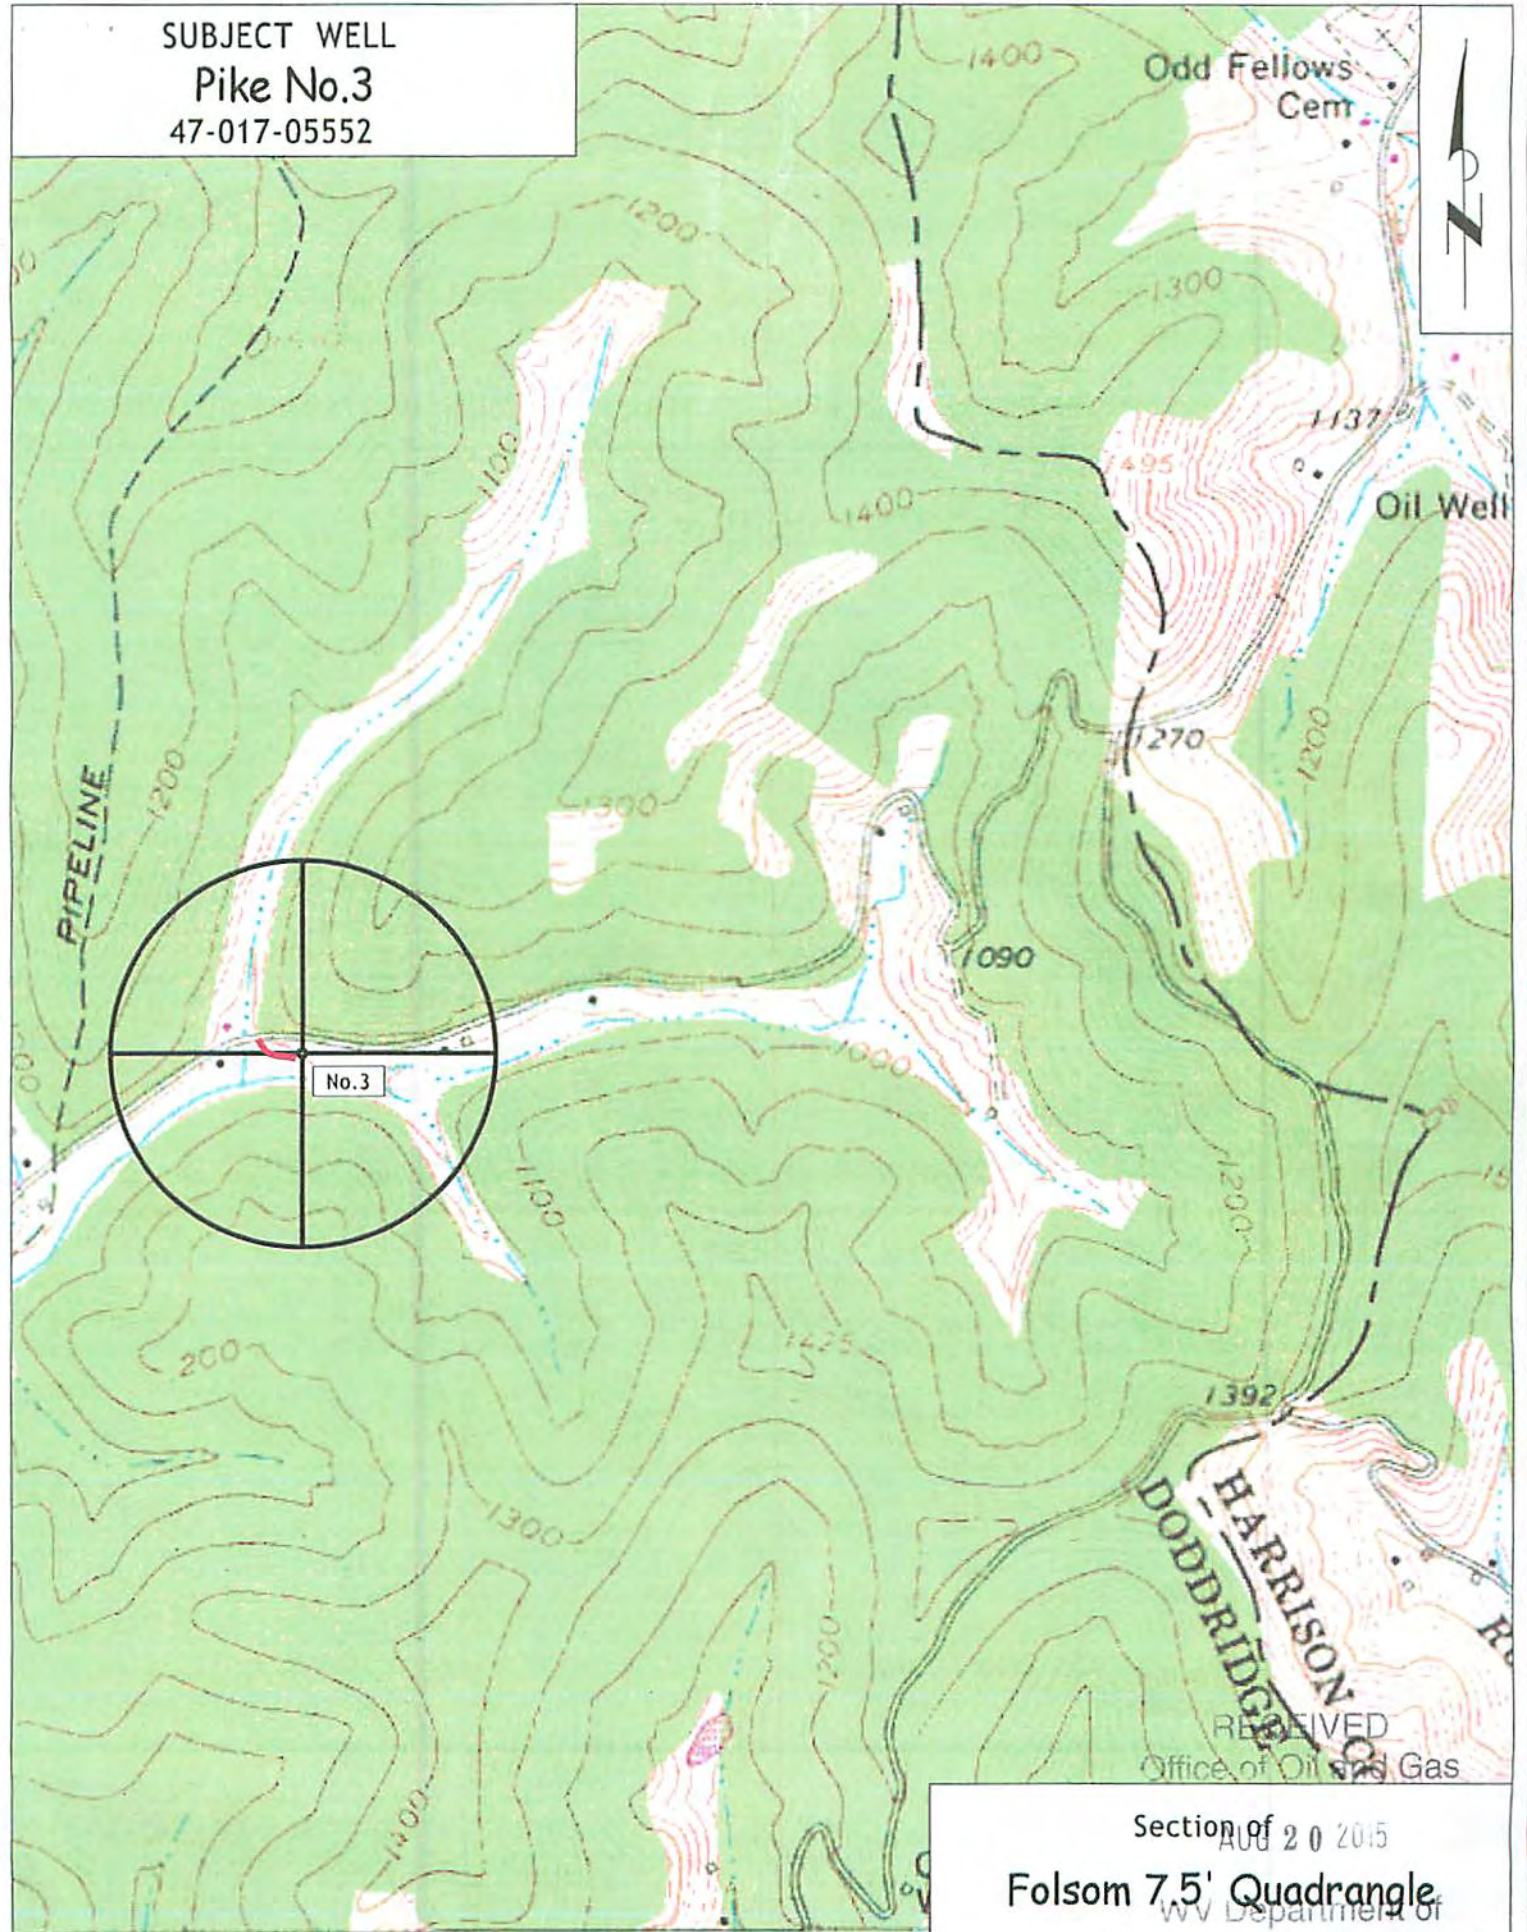

(SALEM) 538

Section of 20 2015
 Folsom 7.5' Quadrangle
 WV Department of
 SCALE 1"=1000' 10/09/2015