

WW-7  
8-30-06

4701705664

RECEIVED  
Office of Oil & Gas  
OCT 12 2022  
WV Department of Environmental Protection



West Virginia Department of Environmental Protection  
Office of Oil and Gas

**WELL LOCATION FORM: GPS**

API: 47-017-05664 WELL NO.: L-005689 (William Adams OXF 47)

FARM NAME: William Adams

RESPONSIBLE PARTY NAME: EQT Production Company

COUNTY: Doddridge DISTRICT: Southwest

QUADRANGLE: Oxford 7.5'

SURFACE OWNER: Marvin Edwards Jr

ROYALTY OWNER: NA

UTM GPS NORTHING: 4331029

UTM GPS EASTING: 515913 GPS ELEVATION: 270 m (887 ft)

The Responsible Party named above has chosen to submit GPS coordinates in lieu of preparing a new well location plat for a plugging permit or assigned API number on the above well. The Office of Oil and Gas will not accept GPS coordinates that do not meet the following requirements:

- Datum: NAD 1983, Zone: 17 North, Coordinate Units: meters, Altitude: height above mean sea level (MSL) – meters.
- Accuracy to Datum – 3.05 meters
- Data Collection Method:

Survey grade GPS \_\_\_\_\_ : Post Processed Differential \_\_\_\_\_  
 Real-Time Differential \_\_\_\_\_  
 Mapping Grade GPS X : Post Processed Differential X  
 Real-Time Differential \_\_\_\_\_

- Letter size copy of the topography map showing the well location.**

I the undersigned, hereby certify this data is correct to the best of my knowledge and belief and shows all the information required by law and the regulations issued and prescribed by the Office of Oil and Gas.

[Signature]  
Signature

BS 2092  
Title

9-27-22  
Date

Topo Quad: Oxford 7.5'

Scale: 1" = 2000' **47 0 17 0 5 6 6 4**

County: Doddridge


Date: October 21, 2021

District: Southwest

Project No: 67-30-00-08

# 47-017-05664 (William Adams OXF 47)

Topo

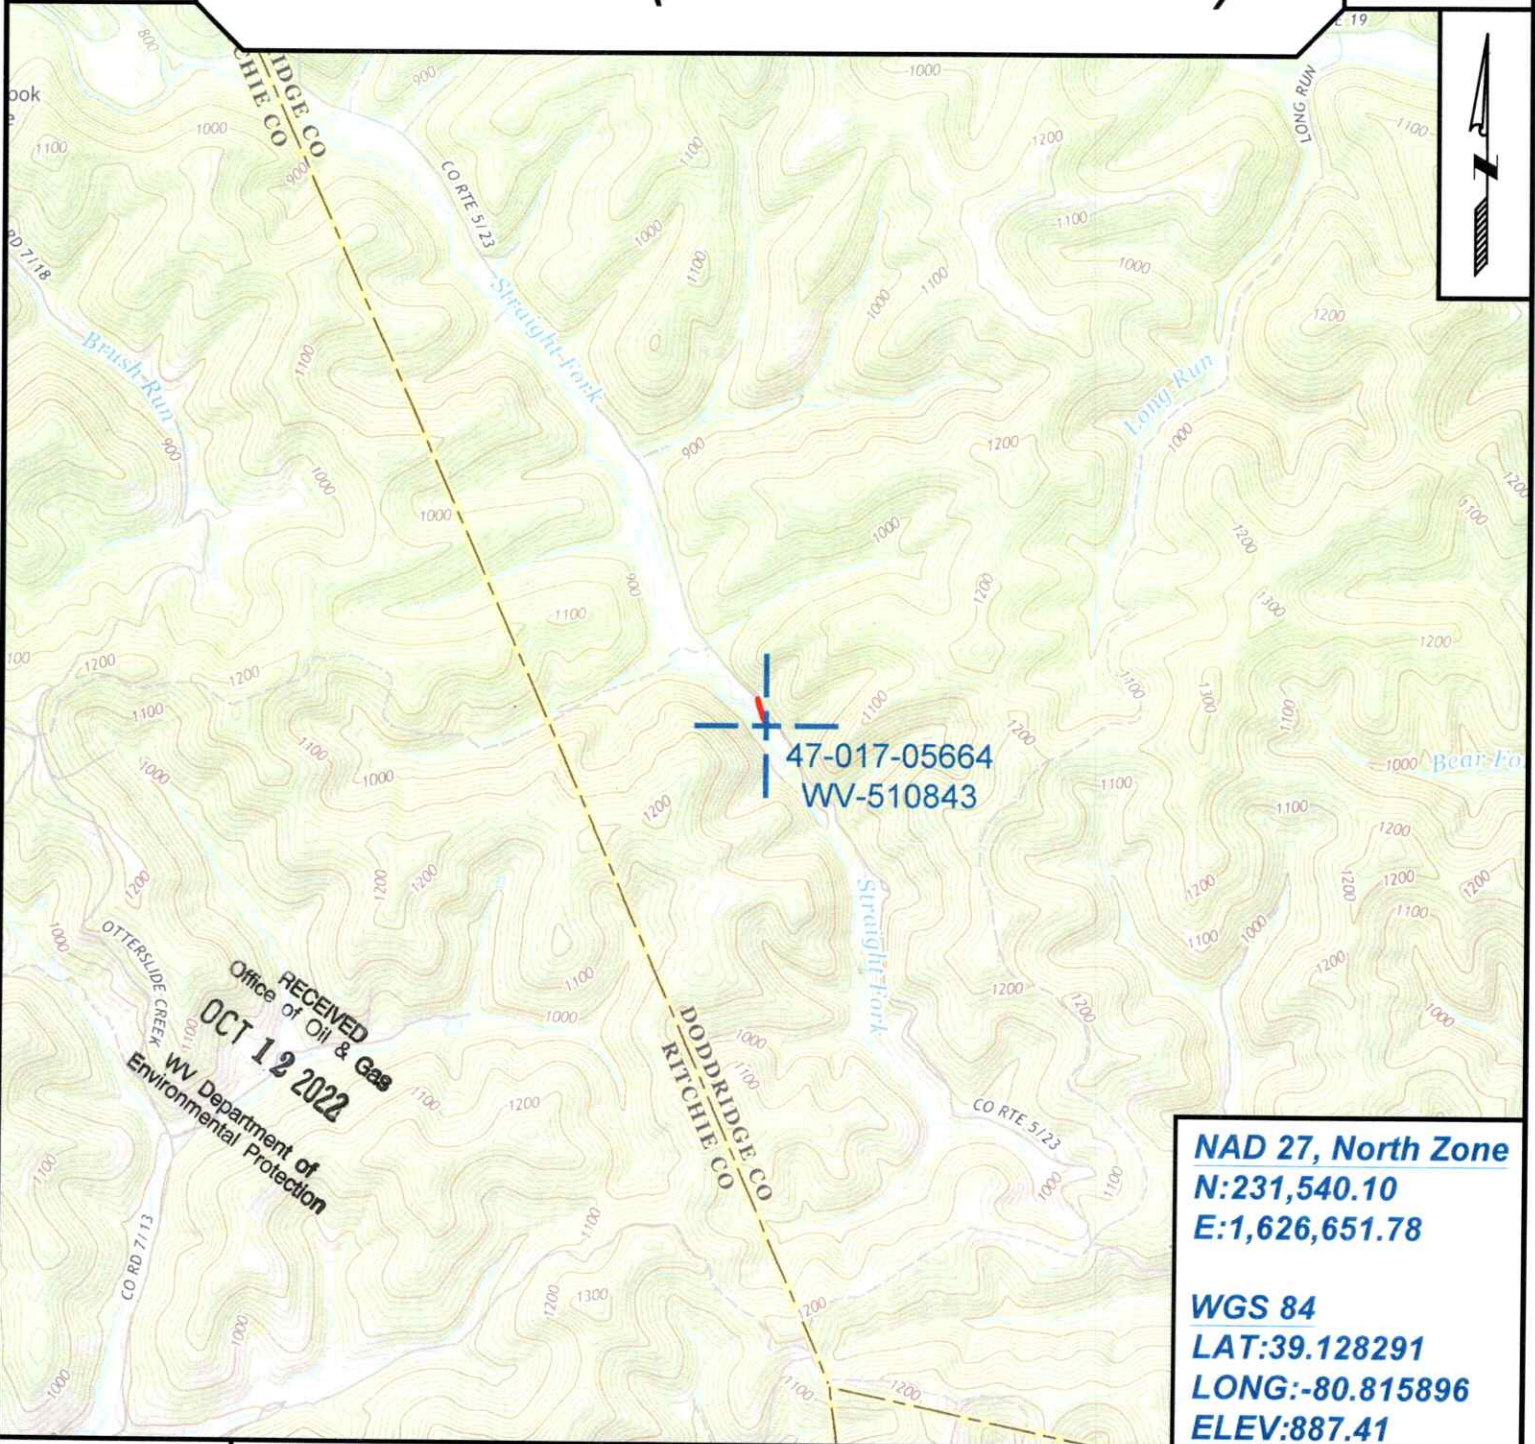

47-017-05664  
WV-510843

RECEIVED  
Office of Oil & Gas  
OCT 12 2022  
WV Department of  
Environmental Protection

**NAD 27, North Zone**  
N:231,540.10  
E:1,626,651.78

**WGS 84**  
LAT:39.128291  
LONG:-80.815896  
ELEV:887.41



SURVEYING AND MAPPING SERVICES PERFORMED BY:  
**ALLEGHENY SURVEYS, INC.**  
1-800-482-8606  
237 Birch River Road  
Birch River, WV 26610  
PH: (304) 649-8606  
FAX: (304) 649-8608

PREPARED FOR:  
**EQT Production Company**  
400 Woodcliff Drive  
Canonsburg, PA 15317  
**12/16/2022**