

WW-7  
8-30-06

4701705746



West Virginia Department of Environmental Protection  
Office of Oil and Gas  
**WELL LOCATION FORM: GPS**

API: 47-017-05746 WELL NO.: L-005681 (W.B. Maxwell OXF 17)

FARM NAME: Maxwell Heirs

RESPONSIBLE PARTY NAME: EQT Production Company

COUNTY: Doddridge DISTRICT: Southwest

QUADRANGLE: Oxford 7.5'

SURFACE OWNER: I. L. Morris

ROYALTY OWNER: NA

UTM GPS NORTHING: 4338317

UTM GPS EASTING: 519471 GPS ELEVATION: 372 m (1221 ft)

The Responsible Party named above has chosen to submit GPS coordinates in lieu of preparing a new well location plat for a plugging permit or assigned API number on the above well. The Office of Oil and Gas will not accept GPS coordinates that do not meet the following requirements:

1. Datum: NAD 1983, Zone: 17 North, Coordinate Units: meters, Altitude: height above mean sea level (MSL) – meters.
2. Accuracy to Datum – 3.05 meters
3. Data Collection Method:  
 Survey grade GPS \_\_\_\_\_ : Post Processed Differential \_\_\_\_\_  
 \_\_\_\_\_ : Real-Time Differential \_\_\_\_\_  
 Mapping Grade GPS X : Post Processed Differential X  
 \_\_\_\_\_ : Real-Time Differential \_\_\_\_\_
4. **Letter size copy of the topography map showing the well location.**

I the undersigned, hereby certify this data is correct to the best of my knowledge and belief and shows all the information required by law and the regulations issued and prescribed by the Office of Oil and Gas.

*Ben K. Stutz*  
Signature

P.S. 2092  
Title

6-1-2022  
Date

RECEIVED  
Office of Oil & Gas  
OCT 12 2022  
WV Department of  
Environmental Protection

Topo Quad: Oxford 7.5'

Scale: 1" = 2000'

County: Doddridge

Date: June 01, 2022


District: Southwest

Project No: 67-30-00-08

47 0 17 0 5 7 4 6

47-017-05746 L-005681 (W.B. Maxwell OXF17)

Topo

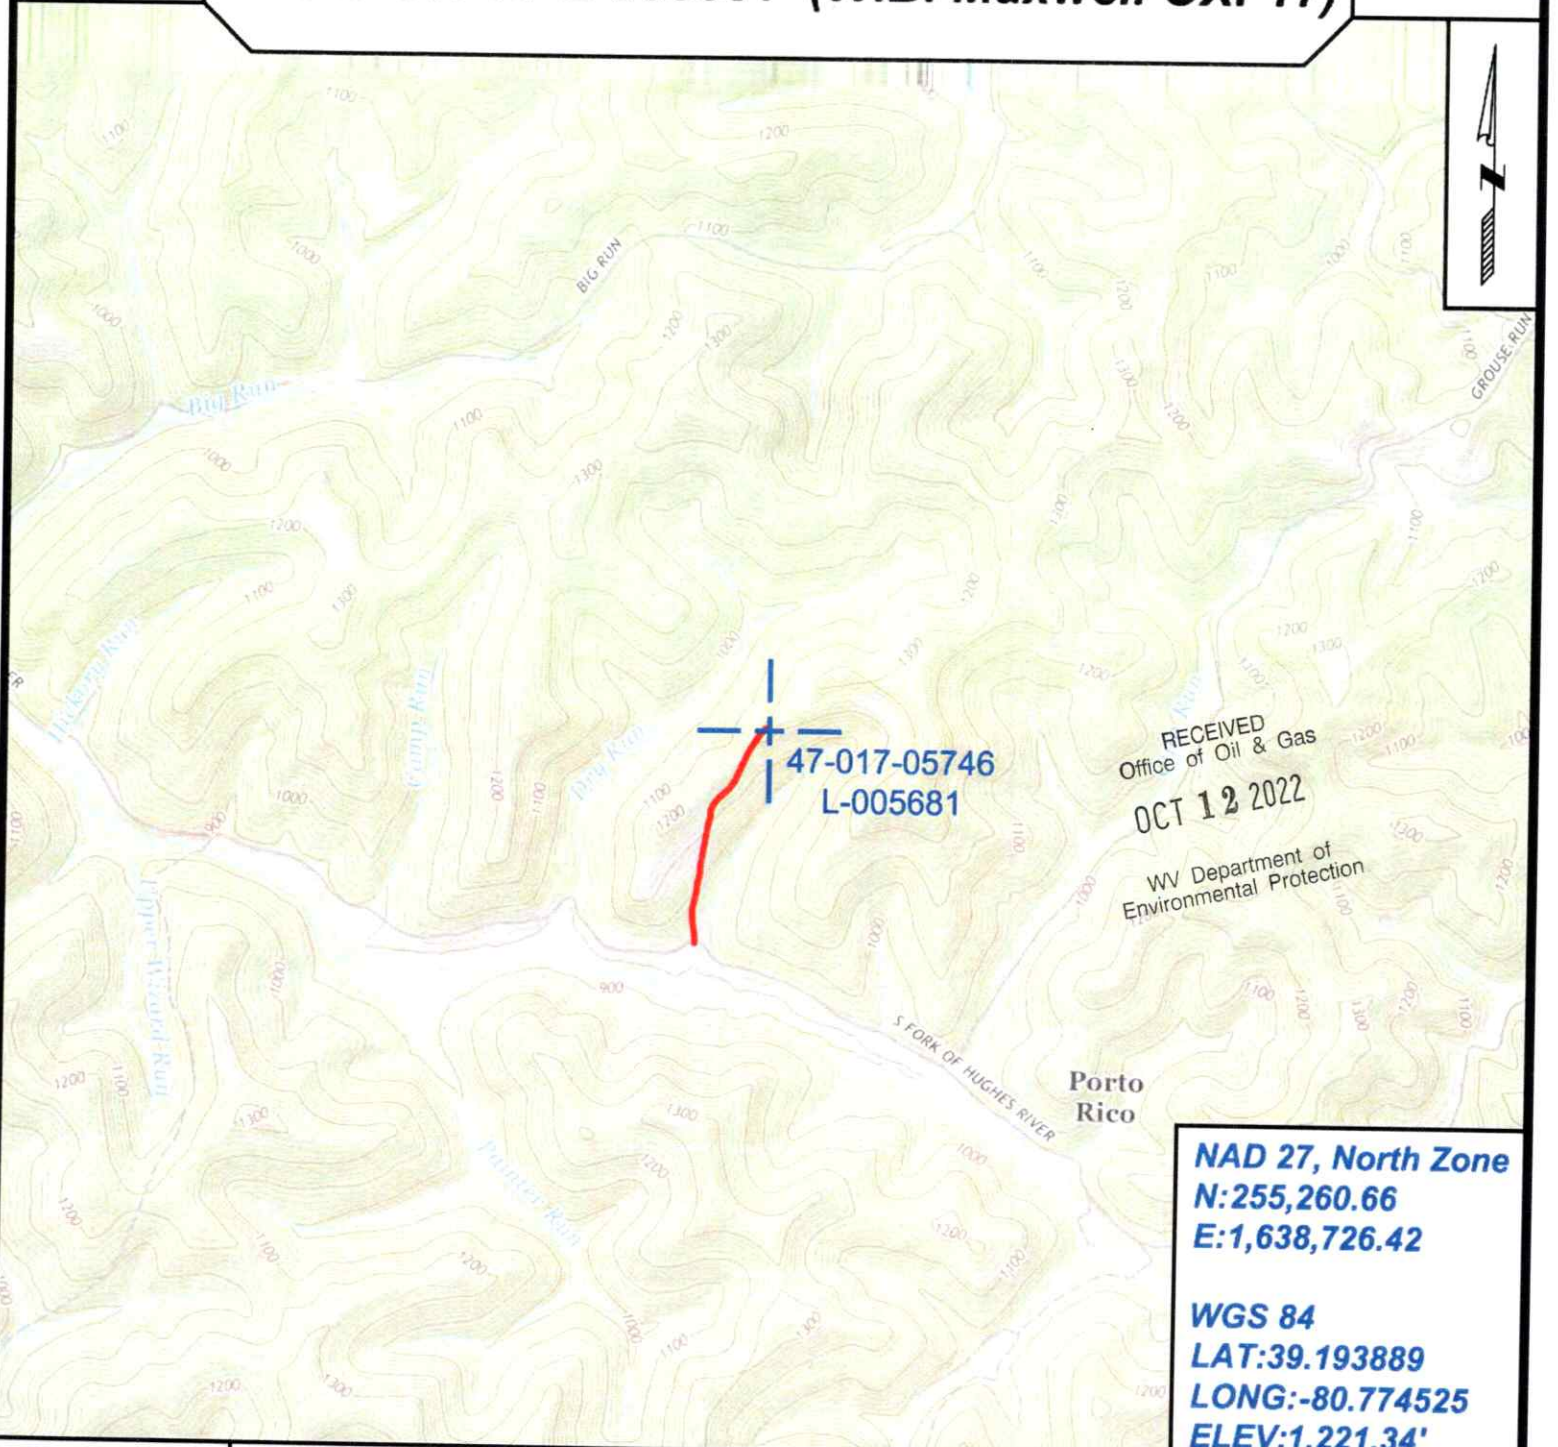

SURVEYING AND MAPPING SERVICES PERFORMED BY:  
**ALLEGHENY SURVEYS, INC.**

1-800-482-8606  
237 Birch River Road  
Birch River, WV 26610  
PH: (304) 649-8606  
FAX: (304) 649-8608

PREPARED FOR:

**EQT Production Company**

400 Woodcliff Drive  
Canonsburg, PA 15317

12/16/2022