

WW-7
8-30-06



West Virginia Department of Environmental Protection
Office of Oil and Gas
WELL LOCATION FORM: GPS

API: 47-017-06101 WELL NO.: Heirs 3H

FARM NAME: Coastal Hilltop

RESPONSIBLE PARTY NAME: Antero Resources Corporation

COUNTY: Doddridge DISTRICT: New Milton

QUADRANGLE: New Milton

SURFACE OWNER: Coastal Forest Resources Co.

ROYALTY OWNER: _____

UTM GPS NORTHING: 4339276.73 m

UTM GPS EASTING: 526137.94 m GPS ELEVATION: 1106.6 ft

The Responsible Party named above has chosen to submit GPS coordinates in lieu of preparing a new well location plat for a plugging permit or assigned API number on the above well. The Office of Oil and Gas will not accept GPS coordinates that do not meet the following requirements:

1. Datum: NAD 1983, Zone: 17 North, Coordinate Units: meters, Altitude: height above mean sea level (MSL) – meters.
2. Accuracy to Datum – 3.05 meters
3. Data Collection Method:

Survey grade GPS : Post Processed Differential _____
Real-Time Differential

Mapping Grade GPS : Post Processed Differential _____
Real-Time Differential

RECEIVED
Office of Oil and Gas

JUN 13 2022

WV Department of
Environmental Protection

4. Letter size copy of the topography map showing the well location.


I the undersigned, hereby certify this data is correct to the best of my knowledge and belief and shows all the information required by law and the regulations issued and prescribed by the Office of Oil and Gas.

[Signature]
Signature

Permitting Manager
Title

5/10/22
Date

47-017-06101 P

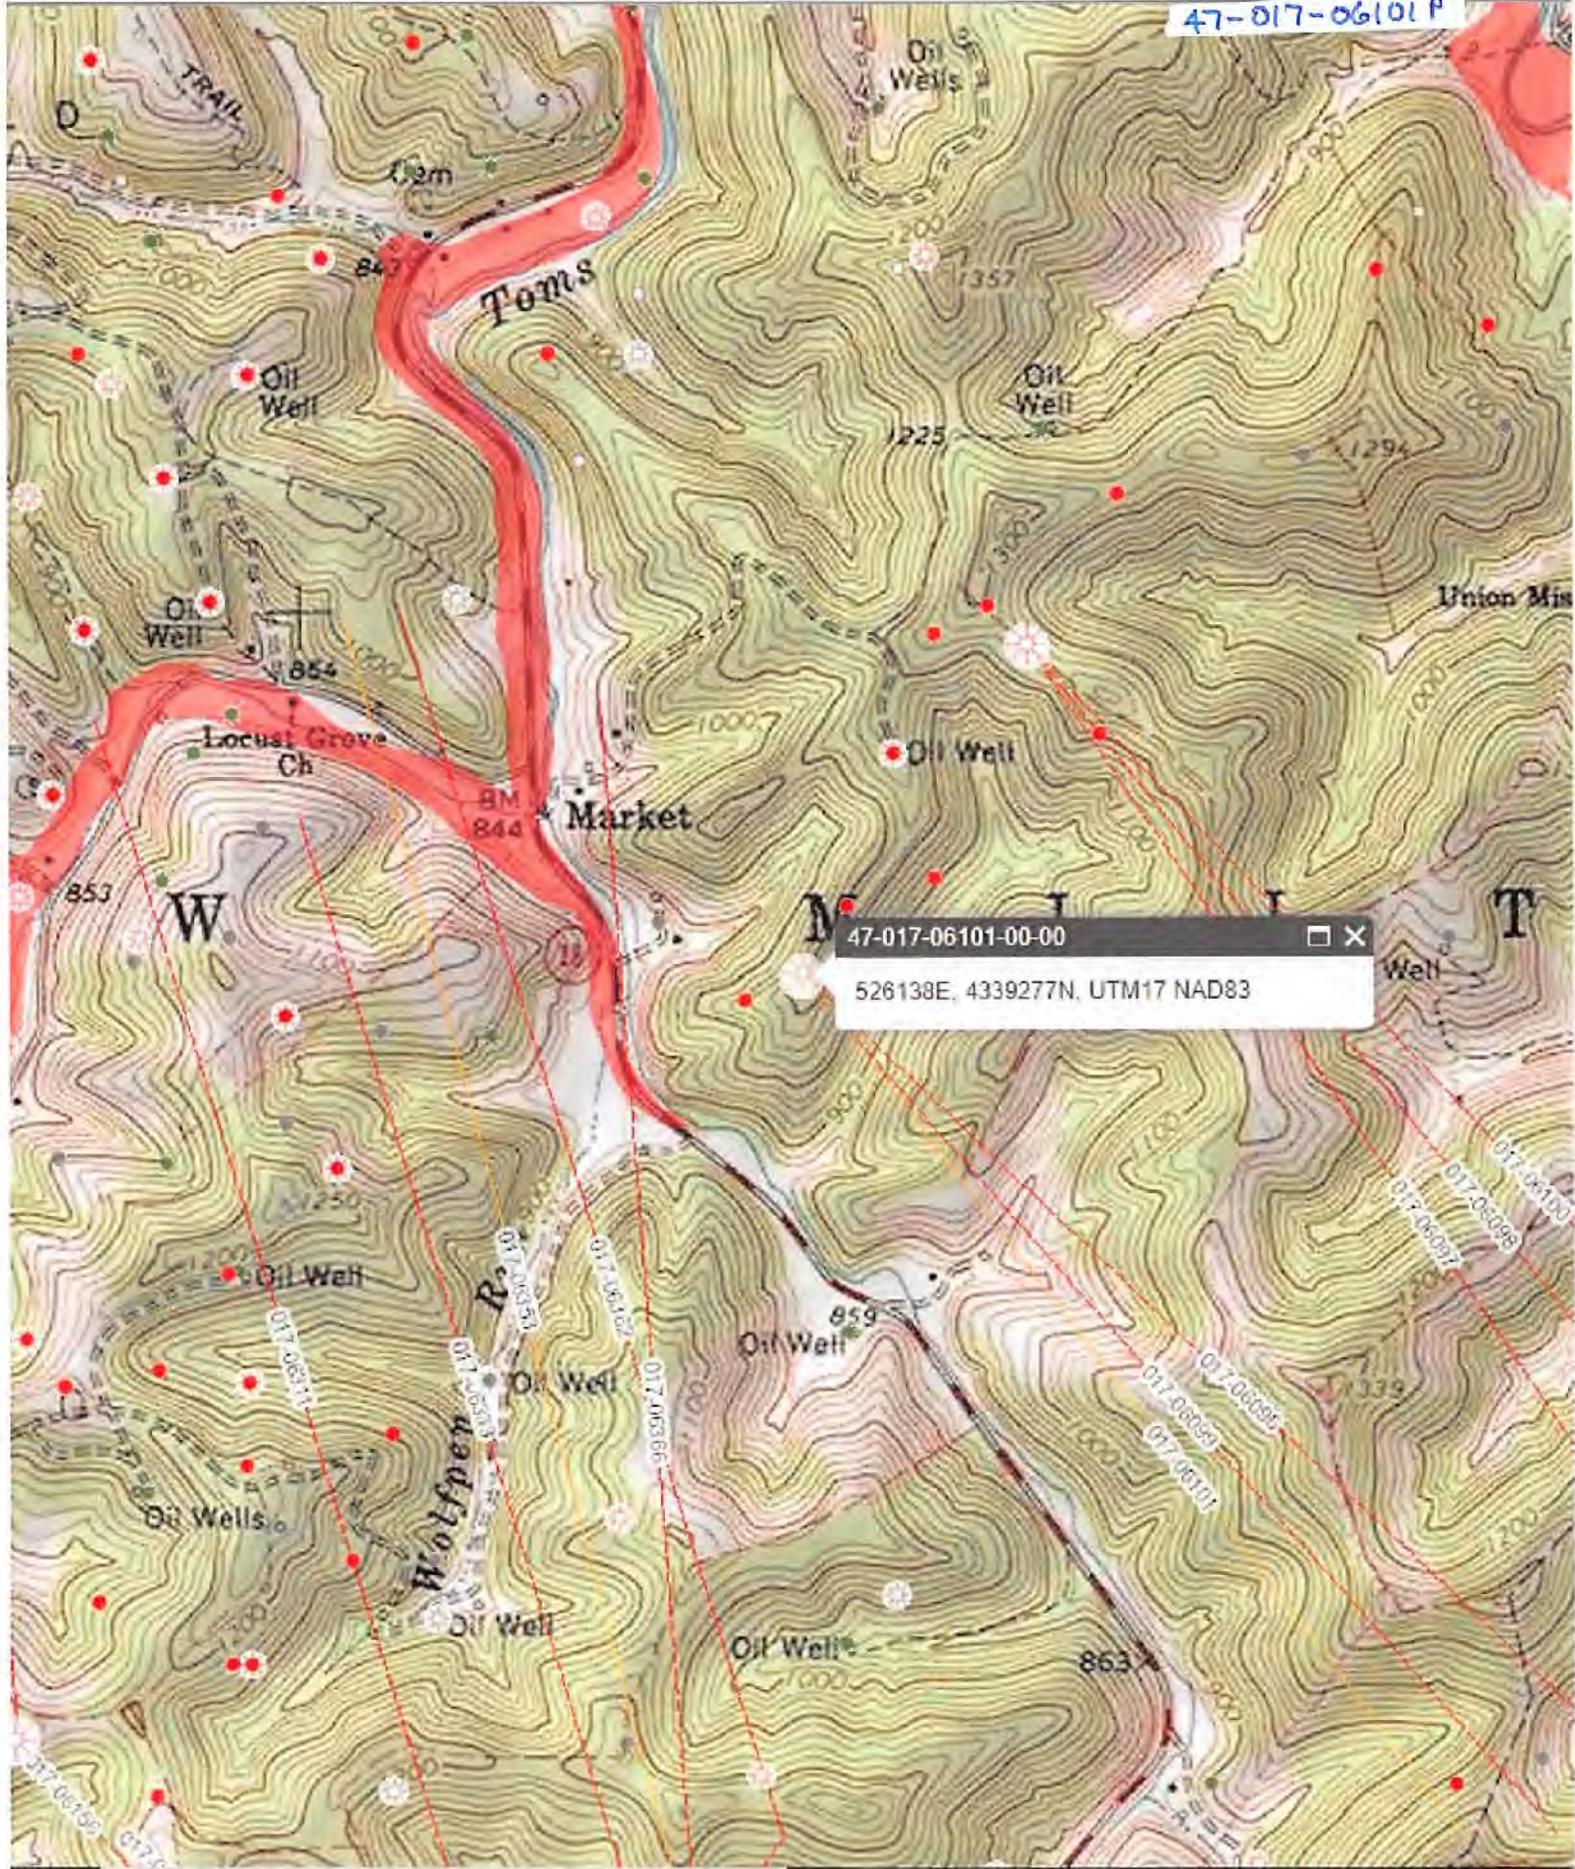

Windows taskbar showing the search bar with the text 'Type here to search' and several application icons including File Explorer, Microsoft Store, and Google Chrome.

06/24/2022