

WR-35  
Rev (9-11)

State of West Virginia  
Department of Environmental Protection  
Office of Oil and Gas  
Well Operator's Report of Well Work

DATE: 5/28/13  
API #: 47-017-06103

Farm name: Erwin, John F. Operator Well No.: Ruckman Unit 3H

LOCATION: Elevation: 1,218' Quadrangle: New Milton 7.5'

District: New Milton County: Doddridge  
Latitude: 8.130' Feet South of 39 Deg. 10 Min. 00 Sec.  
Longitude 5.264' Feet West of 80 Deg. 40 Min. 00 Sec.

Company: Antero Resources Appalachian

Address:	Casing & Tubing	Used in drilling	Left in well	Cement fill up Cu. Ft.
1625 17th Street Denver, CO 80202	20" 94#	43'	43'	41 Cu. Ft. Class A
Agent: CT Corporation System	13-3/8" 48#	350'	350'	486 Cu. Ft. Class A
Inspector: Douglas Newlon	9-5/8" 36#	2,492'	2,492'	1,015 Cu. Ft. Class A
Date Permit Issued: 8/14/2012	5-1/2" 20#	13,108'	13,108'	3,197 Cu. Ft. Class H
Date Well Work Commenced: 10/18/2012				
Date Well Work Completed: 3/20/2013	2-3/8" 4.7#	7,357'		
Verbal Plugging: N/A				
Date Permission granted on: N/A				
Rotary <input checked="" type="checkbox"/> Cable <input type="checkbox"/> Rig <input type="checkbox"/>				
Total Vertical Depth (ft): 7250' TVD (deepest point drilled)				
Total Measured Depth (ft): 13,108' MD, 7185' TVD (BHL)				
Fresh Water Depth (ft.): 295'				
Salt Water Depth (ft.): 1054'				
Is coal being mined in area (N/Y)? No				
Coal Depths (ft.): 240', 455', 765'				
Void(s) encountered (N/Y) Depth(s) None				

OPEN FLOW DATA (If more than two producing formations please include additional data on separate sheet)

Producing formation Marcellus Pay zone depth (ft) 7,228' TVD (Top)

Gas: Initial open flow --- MCF/d Oil: Initial open flow --- B  
Final open flow 5,009 MCF/d Final open flow --- Bbl/d  
Time of open flow between initial and final tests --- Hours  
Static rock Pressure 3950 psig (surface pressure) after --- Hours

Second producing formation \_\_\_\_\_ Pay zone depth (ft) \_\_\_\_\_  
Gas: Initial open flow \_\_\_\_\_ MCF/d Oil: Initial open flow \_\_\_\_\_ Bbl/d  
Final open flow \_\_\_\_\_ MCF/d Final open flow \_\_\_\_\_ Bbl/d  
Time of open flow between initial and final tests \_\_\_\_\_ Hours  
Static rock Pressure \_\_\_\_\_ psig (surface pressure) after \_\_\_\_\_ Hours

I certify under penalty of law that I have personally examined and am familiar with the information submitted on this document and all the attachments and that, based on my inquiry of those individuals immediately responsible for obtaining the information I believe that the information is true, accurate, and complete.

Kaitlin Buck  
Signature

11/22/13 Date  
01/10/2014

17-06103

Were core samples taken? Yes \_\_\_\_\_ No

Were cuttings caught during drilling? Yes  No \_\_\_\_\_

Were Electrical, Mechanical or Geophysical logs recorded on this well? If yes, please list Yes- CBL

This is a subsequent well. Antero only runs wire-line logs on the first well on a multi-well pad (Ruckman Unit 2H AP#47-017-06095). Please reference the wire-line logs submitted with Form WR-35 for Ruckman Unit 2H.

**NOTE: IN THE AREA BELOW PUT THE FOLLOWING: 1). DETAILS OF PERFORATED INTERVALS, FRACTURING OR STIMULATING, PHYSICAL CHANGE, ETC. 2). THE WELL LOG WHICH IS A SYSTEMATIC DETAILED GEOLOGICAL RECORD OF THE TOPS AND BOTTOMS OF ALL FORMATIONS, INCLUDING COAL ENCOUNTERED BY THE WELLBORE FROM SURFACE TO TOTAL DEPTH.**

Perforated Intervals, Fracturing, or Stimulating:

Perforations: 7,410' - 13,053' MD (1,008 holes)

Frac'd w/ 7,500 gals 15% HCL Acid, 306,250 bbls Slick Water carrying 862,500# 100 mesh, 3,382,300# 40/70 sand and 1,780,300# 20/40 sand.

Plug Back Details Including Plug Type and Depth(s): N/A

<u>Formations Encountered:</u>	<u>Top Depth</u>	<u>Bottom Depth</u>
--------------------------------	------------------	---------------------

Surface:

Big Lime	2365'	2453'
Big Injun	2454'	2612'
Weir	2613'	2798'
Berea	2799'	2894'
Gantz	2895'	3011'
Gordon	3012'	3339'
Fifth Sandstone	3340'	3423'
Bayard	3424'	4098'
Balltown	4099'	4827'
Bradford	4828'	5274'
Benson	5275'	5523'
Alexander	5524'	5751'
Elk	5752'	6791'
Sycamore	6792'	6955'
Middlesex Shale	6956'	7110'
Burkett Shale	7111'	7146'
Tully	7147'	7220'
Hamilton	7221'	7227'
Marcellus	7228'	7250'

RECEIVED  
 NOV 25 2013  
 NOV 25 2013  
 T.V.D.

# Hydraulic Fracturing Fluid Product Component Information Disclosure

Job Start Date:	3/20/2013
Job End Date:	3/29/2013
State:	West Virginia
County:	Doddridge
API Number:	47-017-06095-00-00
Operator Name:	Antero Resources Corporation
Well Name and Number:	Ruckman 3H
Longitude:	-80.695177100
Latitude:	39.15228300
Datum:	NAD27
Federal/Tribal Well:	NO
Total Base Water Volume (gal):	5,478,774
Total Base Non Water Volume:	0

## Hydraulic Fracturing Fluid Composition:

Trade Name	Supplier	Purpose	Ingredients	Chemical Abstract Service Number (CAS #)	Maximum Ingredient Concentration in Additive (% by mass)**	Maximum Ingredient Concentration in HF Fluid (% by mass)**	Comments
Water	ANTERO RESOURCES	Water	Water	7732-18-5	100.00000	87.87166	
WV Specific 40/70 mesh Sand	Nabors Completion and Production Services	Sand - Bulk - West Virginia	Crystalline Silica, quartz	14808-60-7	99.90000	6.86932	
			Aluminum Oxide	1344-28-1	1.10000	0.07564	
			Iron Oxide	1309-37-1	0.10000	0.00688	
			Titanium Oxide	13463-67-7	0.10000	0.00688	
WV Specific 20/40 mesh Sand	Nabors Completion and Production Services	Sand - Bulk - West Virginia	Crystalline Silica, quartz	14808-60-7	99.90000	3.35071	
			Aluminum Oxide	1344-28-1	1.10000	0.03690	
			Iron Oxide	1309-37-1	0.10000	0.00335	
			Titanium Oxide	13463-67-7	0.10000	0.00335	
WV Specific 100 mesh Sand	Nabors Completion and Production Services	Sand - Bulk - West Virginia	Crystalline Silica, quartz	14808-60-7	99.90000	1.57190	
			Aluminum Oxide	1344-28-1	1.10000	0.01731	
			Titanium Oxide	13463-67-7	0.10000	0.00157	





17-06103

WFR-3B	Nabors Completion and Production Services	Friction Reducer	Iron Oxide	1309-37-1	0.10000	0.00157
			Hydro-treated light distillates, non-aromatic, BTEX free	64742-47-8	50.00000	0.03684
			Ethoxylated alcohols	68551-12-2	15.00000	0.01105
			Ethoxylated oleylamine	26635-93-8	5.00000	0.00368
LSG-100L	Nabors Completion and Production Services	Gelling Agents	Petroleum Distillates	64742-47-8	70.00000	0.04633
HCl Acid (12.5%-18.0%)	Nabors Completion and Production Services	Bulk Acid	Hydrogen Chloride	7647-01-0	18.00000	0.02274
OB-2	Nabors Completion and Production Services	Gel Breakers	Ammonium Persulfate	7727-54-0	100.00000	0.01476
			Silica, crystalline quartz	7631-86-9	10.00000	0.00148
Super GREEN SOLV	Nabors Completion and Production Services	Paraffin & Scale Additives	BTEX Free Aliphatic Hydrocarbon	64742-96-7	100.00000	0.01372
KR-153SL	Nabors Completion and Production Services	Biocides	Polyethylene-Glycol	25322-68-3	50.00000	0.00615
			2,2-dibromo-3-nitropropionamide	10222-01-2	20.00000	0.00246
EB-4L	Nabors Completion and Production Services	Gel Breakers	Breaker Component	Proprietary	100.00000	0.00090
			Water	7732-18-5	100.00000	0.00090
			Cellulase enzyme	Proprietary	100.00000	0.00090
			Sugar	57-50-1	100.00000	0.00090
			Demulsifier Base	Proprietary	100.00000	0.00090
			Ethylene Glycol	107-21-1	40.00000	0.00036
Acid Inhibitor 2 (AI-2)	Nabors Completion and Production Services	Acid Corrosion Inhibitors	Isopropyl Alcohol	67-63-0	40.00000	0.00010
			Propargyl Alcohol	107-19-7	40.00000	0.00010
			Glycol Ethers	111-46-6	40.00000	0.00010
			Ethoxylated Nonylphenol	68412-54-4	13.00000	0.00003
			Tar bases, quinoline derivs, benzyl chloride-qualified	72480-70-7	10.00000	0.00002

Ingredients shown above are subject to 29 CFR 1910.1200(f) and appear on Material Safety Data Sheets (MSDS). Ingredients shown below are Non-MSDS.

17-06103

Other Ingredients	Nabors Completion and Production Services	Other Ingredients					
		Water	7732-18-5	87.50000		0.11052	
		guar gum	9000-30-0	50.00000		0.03309	
		Polyacrylamide	57-55-6	40.00000		0.02947	
		Water	7732-18-5	40.00000		0.02947	
		Propylene glycol	57-55-6	15.00000		0.01105	
		Water	7732-18-5	60.00000		0.00992	
		Water	7732-18-5	80.00000		0.00985	
		Proprietary	Proprietary	50.00000		0.00827	
		vinylidene chloride-methyl acrylate copolymer	25038-72-6	20.00000		0.00295	
		Proprietary	Proprietary	15.00000		0.00248	
		Proprietary	Proprietary	15.00000		0.00248	
		Proprietary	Proprietary	15.00000		0.00248	
		Crystalline Silica (in the form of quartz)	14808-60-7	2.00000		0.00132	
		Surfactant	68439-51-0	2.00000		0.00132	
		Microparticle	Proprietary	1.00000		0.00074	
		Water	7732-18-5	48.00000		0.00011	
		2-Butoxyethanol	111-75-2	13.00000		0.00003	
		Dioxane	123-91-1	1.00000		0.00000	
		Organophilic Clay	68953-58-2				

\* Total Water Volume sources may include fresh water, produced water, and/or recycled water  
 \*\* Information is based on the maximum potential for concentration and thus the total may be over 100%

Note: For Field Development Products (products that begin with FDP), MSDS level only information has been provided.  
 Ingredient information for chemicals subject to 29 CFR 1910.1200(i) and Appendix D are obtained from suppliers Material Safety Data Sheets (MSDS)



17-06103



**Antero Resources**  
**Ruckman Unit 3H**  
**Doddridge County WV**  
**Northing: 14217504.51**  
**Easting: 1726786.83**  
**Original Wellpath**

**WELL DETAILS:** Ruckman Unit 3H

Ground Level:	1250.0
+N/-S	0.0
+E/-W	0.0
Northing	14217504.51
Eastings	1726786.83
Latitude	39° 07' 20" N 80° 41' 43.201" W
Longitude	
Spot	

**PROJECT DETAILS:** Doddridge County WV

Geodetic System: Universal Transverse Mercator (US Survey Feet)  
 Datum: NAD 1983 (NAD83 CONUS)  
 Ellipsoid: Clarke 1886  
 Zone: Zone 17N (64 W to 78 W)  
 System Datum: Mean Sea Level

**REFERENCE INFORMATION**

Coordinate (N/E) Reference: Well Ruckman Unit 3H, Grid North  
 Vertical (TVD) Reference: Surface of 201' from 8' 1200' OI - 24' from 8' 1214.04ft  
 Measured Depth Reference: Ruckman Unit 3H from 8' 1200' OI - 24' RIG @ 1214.04ft  
 Operation Method: Directional Drilling

**LEGEND**



- Ruckman Unit 3H, Original Wellpath, Original Wellpath VO
- Droppeman Unit 1H, Original Wellpath, Original Wellpath VO
- Ruckman Unit 1H, Original Wellpath, Original Wellpath VO
- Ruckman Unit 3H, Original Wellpath, Plan 4 VO
- Original Wellpath

**Scientific Drilling**  
 421 South Eagle Lane  
 Oklahoma City, OK

Gaite Lightfoot  
 14:38, September 08 2013

**DESIGN TARGET DETAILS**

Name	TVD	+N/-S	+E/-W	Northing	Easting	Latitude	Longitude
SHL Ruckman Unit 3H	0.0	4656.6	0.0	0.014217504	1726786.83	39° 07' 20" N 80° 41' 43.201" W	
Actual BHL Ruckman Unit 3H	8.8			-3778.114222161	07 1723008.71	39° 07' 54.136" N 80° 42' 30.988" W	
SHL (UTM meters)				4333.722m	625.340m		
BHL (UTM meters)				4335.136m	625.192m		

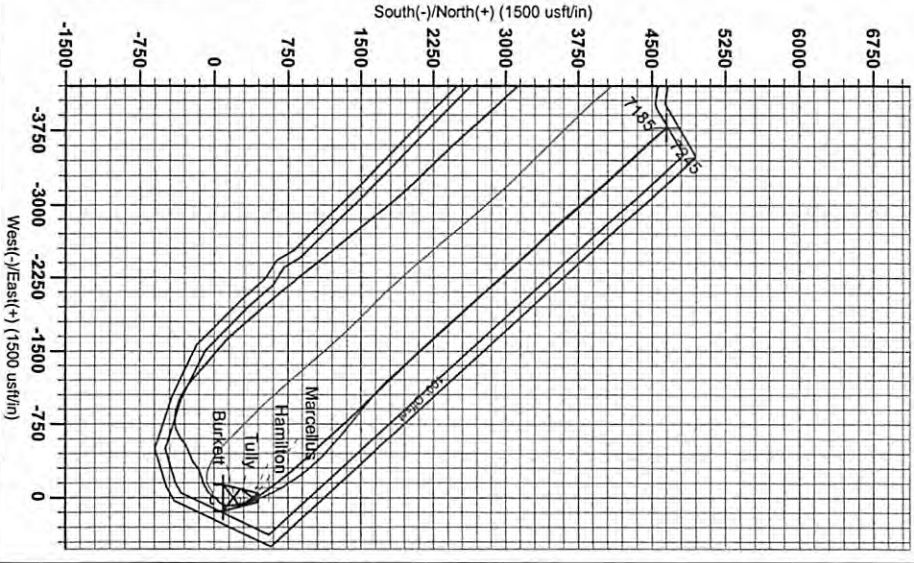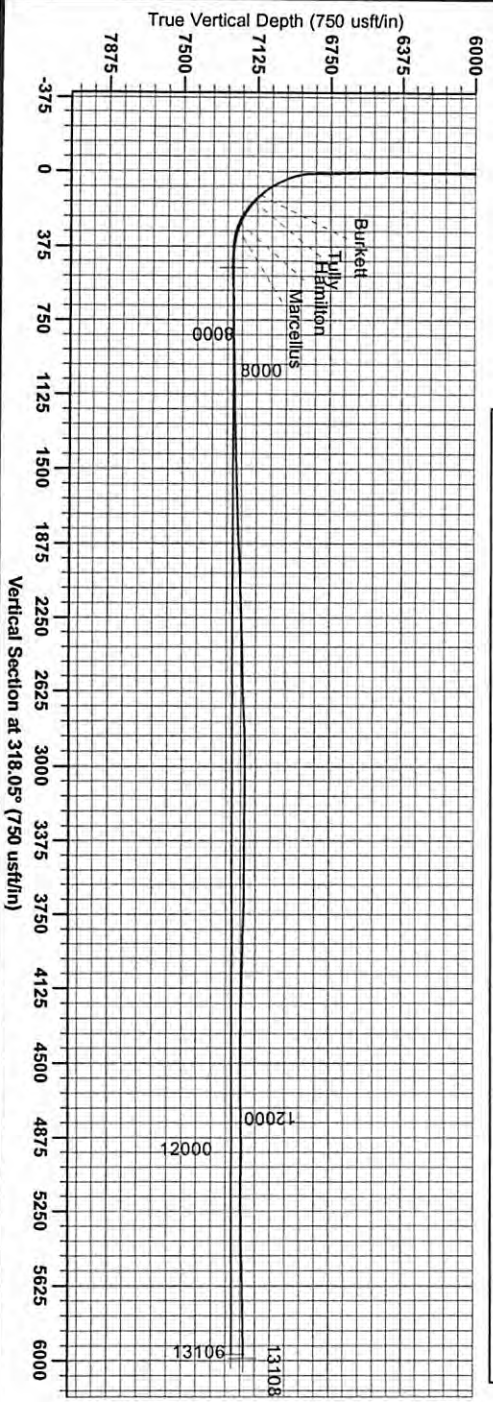

**Magnetic Field**  
 Strength: 52414.22nT  
 Dip Angle: 65.03°  
 Declination: 7.195°  
 Model: IGRF2010

**Azimuths to Grid North**  
 True North: -0.15°  
 Magnetic North: -8.03°

To convert Magnetic North to Grid, Subtract 8.03°  
 To convert True North to Grid, Subtract 0.15°

01/10/2014