

4701706155

WW-7
8-30-06



West Virginia Department of Environmental Protection
Office of Oil and Gas

WELL LOCATION FORM: GPS

API: 47-017-06155 WELL NO.: Johnson 2H

FARM NAME: Richard Garry

RESPONSIBLE PARTY NAME: Antero Resources Corporation

COUNTY: Doddridge DISTRICT: New Milton

QUADRANGLE: Oxford & West Milton

SURFACE OWNER: Antero Resources Corporation

ROYALTY OWNER: _____

UTM GPS NORTHING: 4337853.59 m

UTM GPS EASTING: 524676.30 m GPS ELEVATION: 1156.5 ft

The Responsible Party named above has chosen to submit GPS coordinates in lieu of preparing a new well location plat for a plugging permit or assigned API number on the above well. The Office of Oil and Gas will not accept GPS coordinates that do not meet the following requirements:

1. Datum: NAD 1983, Zone: 17 North, Coordinate Units: meters, Altitude: height above mean sea level (MSL) – meters.
2. Accuracy to Datum – 3.05 meters
3. Data Collection Method:

Survey grade GPS : Post Processed Differential _____

Real-Time Differential

Mapping Grade GPS : Post Processed Differential _____

Real-Time Differential


4. Letter size copy of the topography map showing the well location.

I the undersigned, hereby certify this data is correct to the best of my knowledge and belief and shows all the information required by law and the regulations issued and prescribed by the Office of Oil and Gas.

May Tull
Signature

Permitted Party
Title

4/5/23
Date

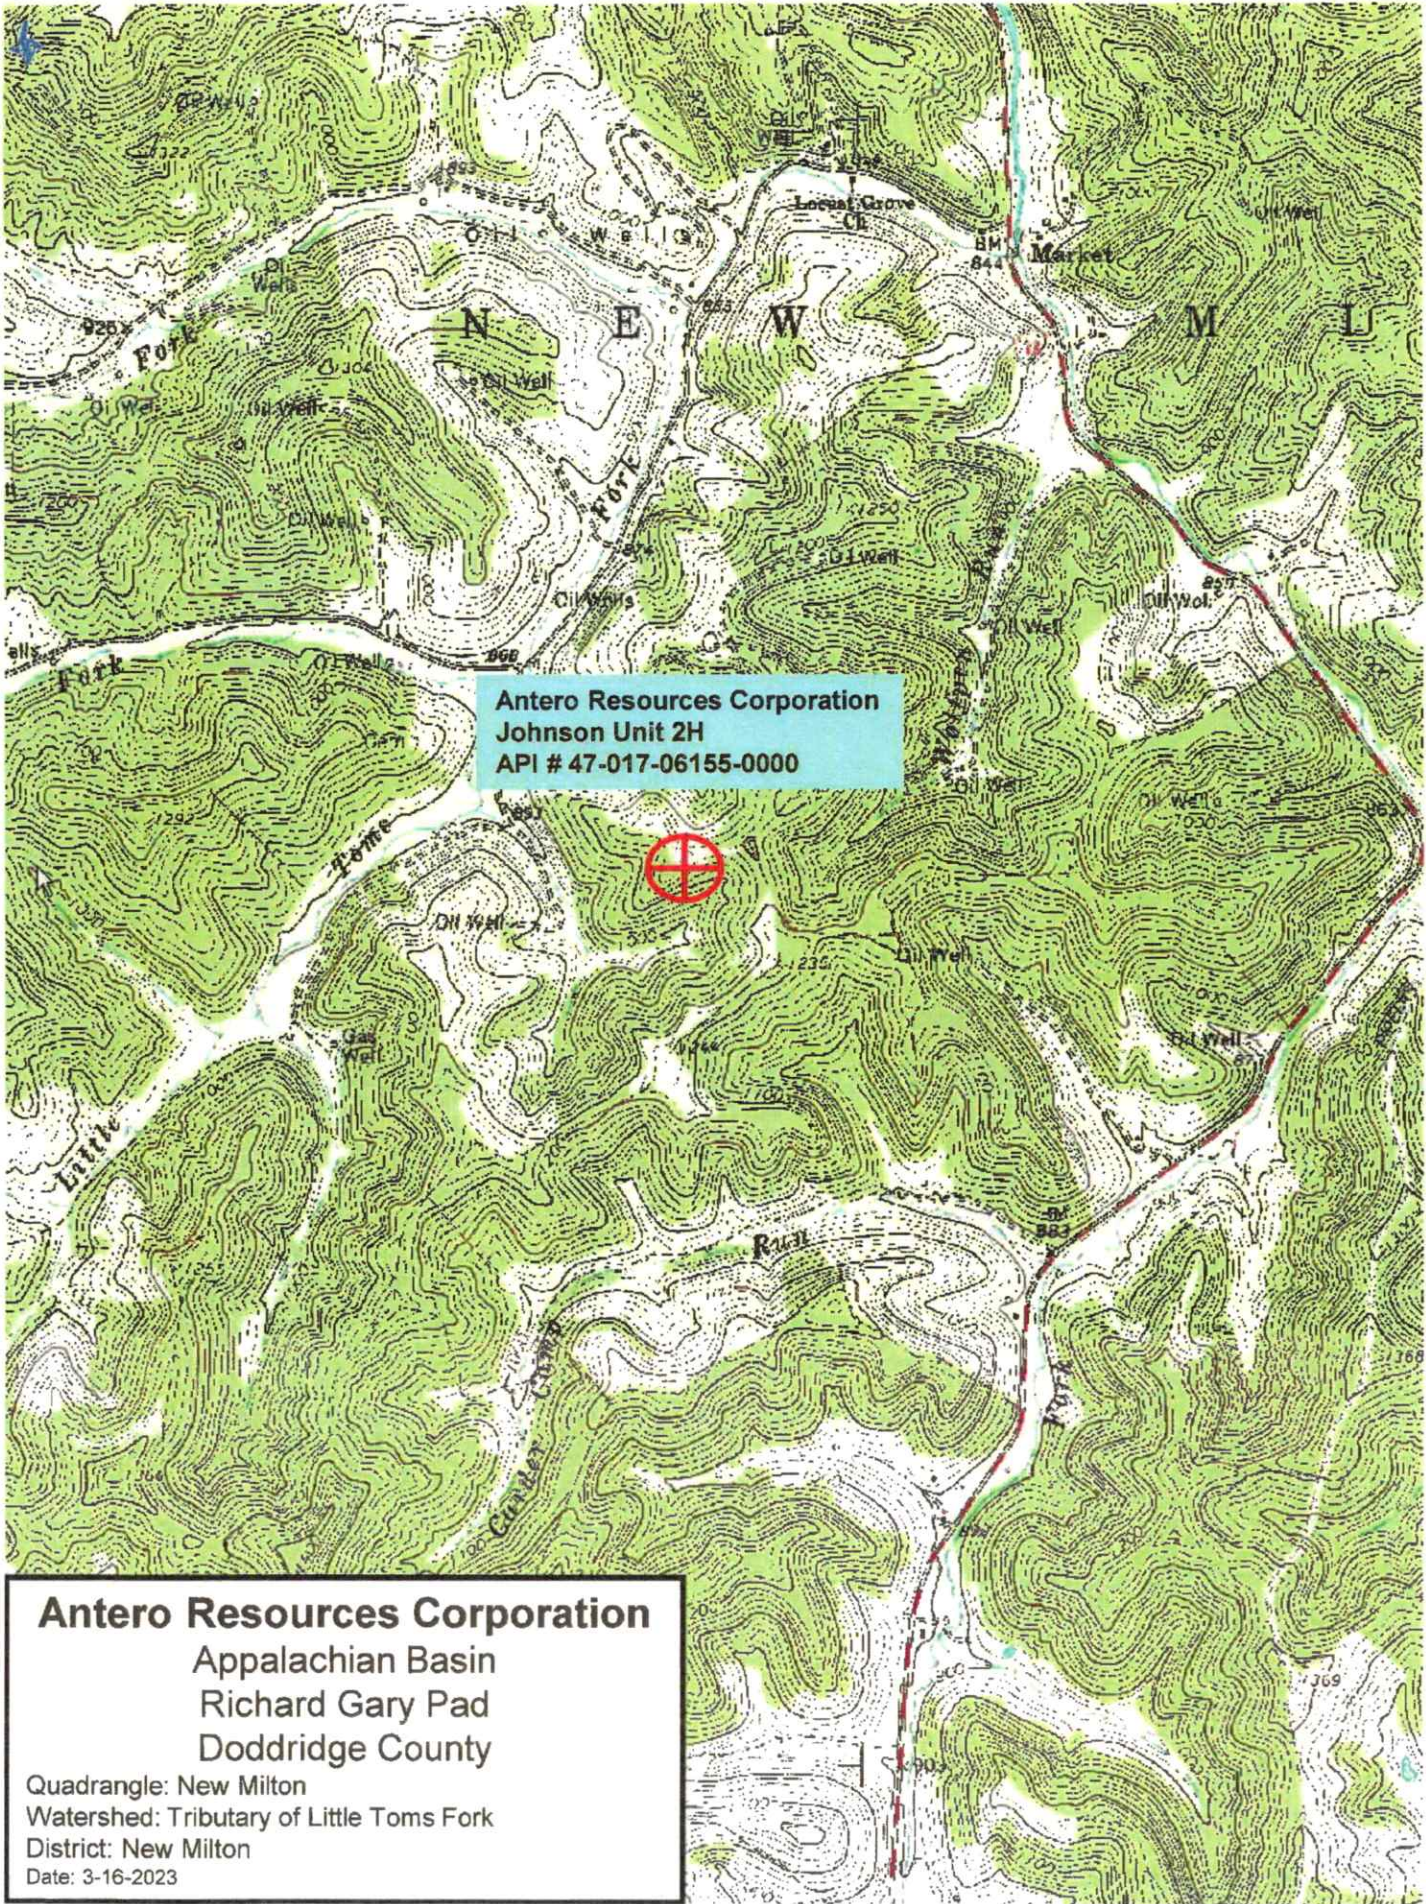

Antero Resources Corporation
Johnson Unit 2H
API # 47-017-06155-0000



Antero Resources Corporation
Appalachian Basin
Richard Gary Pad
Doddridge County
Quadrangle: New Milton
Watershed: Tributary of Little Toms Fork
District: New Milton
Date: 3-16-2023