



west virginia department of environmental protection

Office of Oil and Gas
601 57th Street SE
Charleston, WV 25304
(304) 926-0450
(304) 926-0452 fax

Earl Ray Tomblin, Governor
Randy C. Huffinan, Cabinet Secretary
www.dep.wv.gov

PERMIT MODIFICATION APPROVAL

March 28, 2014

EQT PRODUCTION COMPANY
POST OFFICE BOX 280
BRIDGEPORT, WV 26330

Re: Permit Modification Approval for API Number 1706324 , Well #: WV 513346

Modified Casing

Oil and Gas Operator:

The Office of Oil and Gas has reviewed the attached permit modification for the above referenced permit. The attached modification has been approved and well work may begin. Please be reminded that the oil and gas inspector is to be notified twenty-four (24) hours before permitted well work is commenced.

Please call James Martin at 304-926-0499, extension 1654 if you have any questions.

Sincerely,

Gene Smith
Regulatory/Compliance Manager
Office of Oil and Gas



December 17, 2013

Mr. Gene Smith
West Virginia Department of Environmental Protection
Office of Oil and Gas
601 57th Street SE
Charleston, WV 25304

Re: Modification of (WEU6) 47-017-06324

Dear Mr. Smith,

Attached is a modification to the casing program for the above well. A new WW-6B & schematics are enclosed for your review. Due to problems encountered drilling the WEU8 wells, we have decided to set the intermediate casing deeper.

If you have any questions, please do not hesitate to contact me at (304) 848-0076.

Sincerely,

A handwritten signature in blue ink, appearing to read 'Vicki Roark'.

Vicki Roark
Permitting Supervisor-WV

Enc.

cc: Douglas Newlon
4060 Dutchman Road
Macfarlan, WV 26148



STATE OF WEST VIRGINIA
DEPARTMENT OF ENVIRONMENTAL PROTECTION, OFFICE OF OIL AND GAS
W.VA. CODE §22-6A - WELL WORK PERMIT APPLICATION

Well Operator: EQT Production Company
Operator ID 017 County 8 District 671 Quadrangle

Operator's Well Number: 513346 Well Pad Name WEU6

Farm Name/Surface Owner: Maxwell Public Road Access: Rt. 50

Elevation, current ground: 1,266.0 Elevation, proposed post-construction: 1,261.0

Well Type: (a) Gas Oil Underground Storage
Other _____

(b) If Gas: Shallow Deep
Horizontal

Existing Pad? Yes or No: No

Proposed Target Formation(s), Depth(s), Anticipated Thicknesses and Associated Pressure(s):
Target formation is Marcellus at a depth of 6815' with the anticipated thickness to be 110 feet and anticipated target pressure of 4616 PSI

Proposed Total Vertical Depth: 6,990
Formation at Total Vertical Depth: Onondaga
Proposed Total Measured Depth: 13,759
Proposed Horizontal Leg Length: 6,690
Approximate Fresh Water Strata Depths: 352, 464, 507, 966, & 1030
Method to Determine Fresh Water Depth: By offset wells
Approximate Saltwater Depths: None Reported
Approximate Coal Seam Depths: 187
Approximate Depth to Possible Void (coal mine, karst, other): None reported

Does proposed well location contain coal seams directly overlying or adjacent to an active mine?

(a) If Yes, provide Mine Info: Name: _____
Depth: _____
Seam: _____
Owner: _____

Douglas Jewell
1-2-2014

CASING AND TUBING PROGRAM

18)

TYPE	Size	New or Used	Grade	Weight per ft.	FOOTAGE: for Drilling	INTERVALS: Left in Well	CEMENT: Fill- up (Cu.Ft.)
Conductor	20	New	MC-50	81	40	40	38
Fresh Water	13 3/8	New	MC-50	54	1,130	1,130	977
Coal	-	-	-	-	-	-	-
Intermediate	9 5/8	New	MC-50	40	5,426	5,426	2,128
Production	5 1/2	New	P-110	20	13,759	13,759	See Note 1
Tubing	2 3/8		J-55	4.6			May not be run, if run will be set 100' less than TD
Liners							

TYPE	Size	Wellbore Diameter	Wall Thickness	Burst Pressure	Cement Type	Cement Yield (cu. ft./k)
Conductor	20	24	0.635	-	Construction	1.18
Fresh Water	13 3/8	17 1/2	0.38	2,480	1	1.21
Coal	-	-	-	-	-	-
Intermediate	9 5/8	12 3/8	0.395	3,590	1	1.21
Production	5 1/2	8 1/2	0.361	12,640	-	1.27/1.86
Tubing						
Liners						

Packers

Kind:	N/A			
Sizes:	N/A			
Depths Set:	N/A			

Note 1: EQT plans to bring the TOC on the production casing cement job 1,000' above kick off point, which is at least 500' above the shallowest production zone, to avoid communication.

DCN
1-2-2014

RECEIVED
Office of Oil & Gas
JAN 18 2014

04/04/2014
WV Dept. of Environmental Protection

(3/13)

19) Describe proposed well work, including the drilling and plugging back of any pilot hole:

Drill and complete a new horizontal well in the marcellus formation. The vertical drill to go down to an approximate depth of 6990'. Tag the onondaga not more than 100', run logs, then plug back to approximately 6242. Then kick off the horizontal leg into the marcellus using a slick water frac.

20) Describe fracturing/stimulating methods in detail, including anticipated max pressure and max rate:

Hydraulic fracturing is completed in accordance with state regulations using water recycled from previously fractured wells and obtained from freshwater sources. This water is mixed with sand and a small percentage (less than 0.3%) of chemicals (including 15% Hydrochloric acid, gelling agent, gel breaker, friction reducer, biocide, and scale inhibitor), referred to in the industry as a "slickwater" completion. Maximum anticipated treating pressures are expected to average approximately 8500 psi, maximum anticipated treating rates are expected to average approximately 100 bpm. Stage lengths vary from 150 to 300 feet. Average approximately 200,000 barrels of water per stage. Sand sizes vary from 100 mesh to 20/40 mesh. Average approximately 200,000 pounds of sand per stage.

21) Total area to be disturbed, including roads, stockpile area, pits, etc. (acres): 49.7

22) Area to be disturbed for well pad only, less access road (acres): 17.5

23) Describe centralizer placement for each casing string.

- Surface: Bow spring centralizers – One at the shoe and one spaced every 500'.
- Intermediate: Bow spring centralizers– One cent at the shoe and one spaced every 500'.
- Production: One spaced every 1000' from KOP to Int csg shoe

24) Describe all cement additives associated with each cement type. Surface (Type 1 Cement): 0-3% Calcium Chloride
Used to speed the setting of cement slurries.

0.4% flake. Loss Circulation Material (LCM) is used to combat the loss of the cement slurry to a thief zone.
Intermediate (Type 1 Cement): 0-3% Calcium Chloride. Salt is used in shallow, low temperature formations to speed the setting of cement slurries. 0.4% flake. Loss Circulation Material (LCM) is used to combat the loss of whole drilling fluid or cement slurry (not filtrate) to a thief zone.

Production:

Lead (Type 1 Cement): 0.2-0.7% Lignosulfonate (Retarder). Lengthens thickening time.

0.3% CFR (dispersant). Makes cement easier to mix.

Tail (Type H Cement): 0.25-0.40% Lignosulfonate (Retarder). Lengthens thickening time.

0.2-0.3% CFR (dispersant). This is to make the cement easier to mix.

60 % Calcuim Carbonate. Acid solubility.

0.4-0.6% Halad (fluid loss). Reduces amount of water lost to formation.

25) Proposed borehole conditioning procedures. Surface: Circulate hole clean (Approximately 30-45 minutes) rotating & reciprocating

one full joint until cuttings diminish at surface. When cuttings returning to surface diminish, continue to circulate an additional 5 minutes. To ensure that there is no fill, short trip two stands with no circulation. If there is fill, bring compressors back on and circulate hole clean. A constant rate of higher than expected cuttings volume likely indicates washouts that will not clean up.

Intermediate: Circulate hole clean (Approximately 30-45 minutes) rotating & reciprocating one full joint until cuttings diminish at surface. When cuttings returning to surface diminish, continue to circulate an additional 5 minutes. If foam drilling, to enhance hole cleaning use a soap sweep or increase injection rate & foam concentration.

Production: Pump marker sweep with nut plug to determine actual hole washout. Calculate a gauge holes bottoms up volume.

Perform a cleanup cycle by pumping 3-5 bottoms up or until the shakers are clean. Check volume of cuttings coming across the shakers every 15 minutes.


*Note: Attach additional sheets as needed.

RECEIVED
Office of Oil & Gas
DEC 19 2013
Page 3 of 3
WV Department of
Environmental Protection

04/04/2014

Well 513346(WEU6H5)
 EQT Production
 West Union
 Doddridge West Virginia

Azimuth 189
 Vertical Section 6690

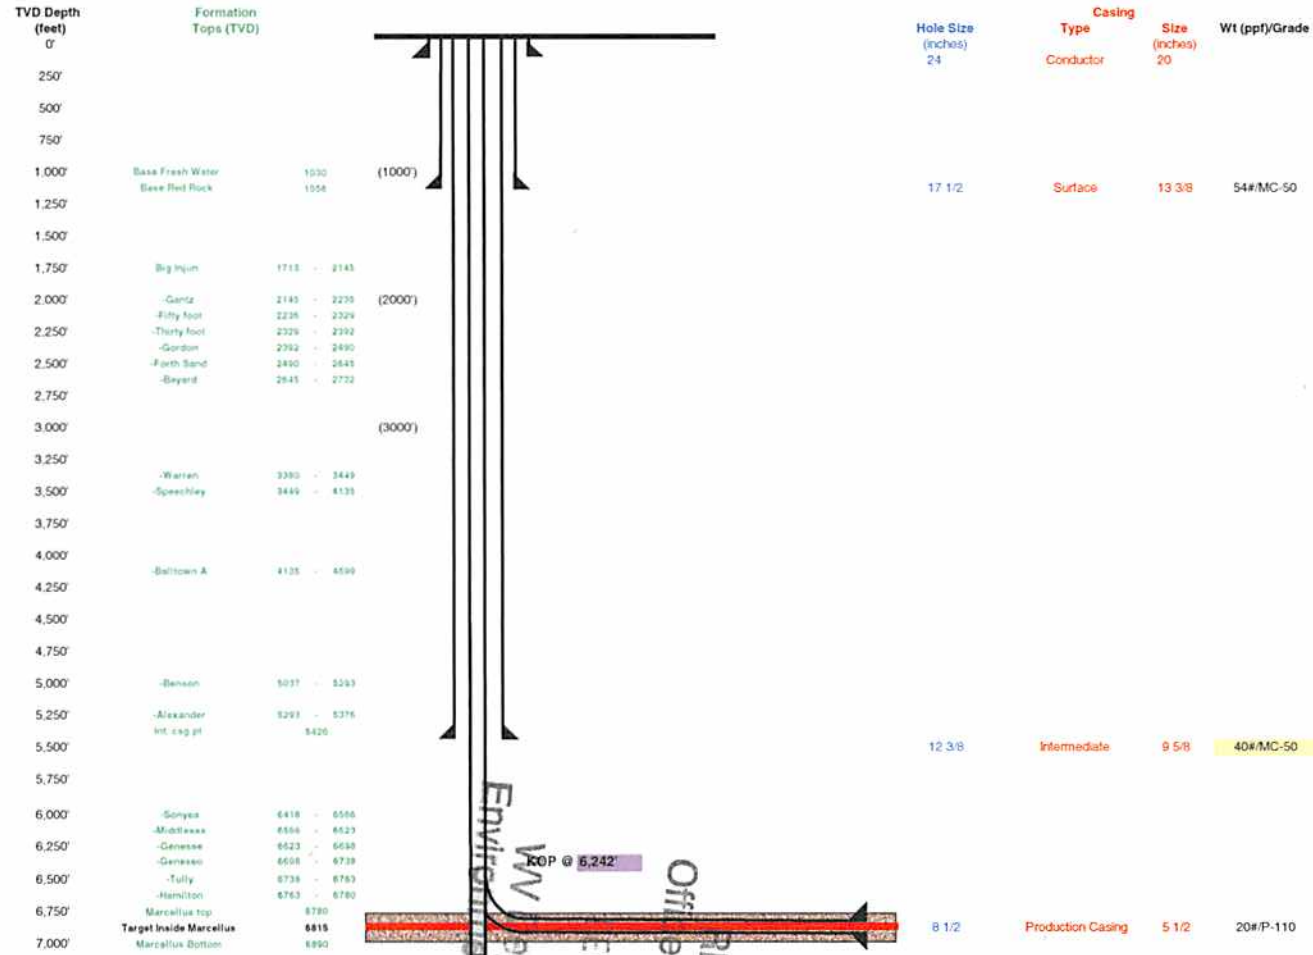

Proposed Well Work:
 Drill and complete a new horizontal well in the Marcellus formation.
 The vertical drill to go down to an approximate depth of 6990'.
 Tag the Onondaga not more than 100', run logs, then plug back to approximately 6242'.
 Then kick off the horizontal leg into the Marcellus formation using a slick water fracture.


Land curve @ 6,815' ft TVD
 7,142' ft MD
 Est. TD @ 6,815' ft TVD
 13,259' ft MD
 4,600' Lateral
 RECEIVED
 Office of Oil & Gas
 Department of Environmental Protection
 WV
 JUL 9 2013

4701706324
 MOD

Well Schematic
EQT Production

Well Name: 513346(WEU6H5)
County: Doddridge
State: West Virginia


Elevation KB: 1272
Target: Marcellus
Prospect: 165
Azimuth: 6690
Vertical Section:

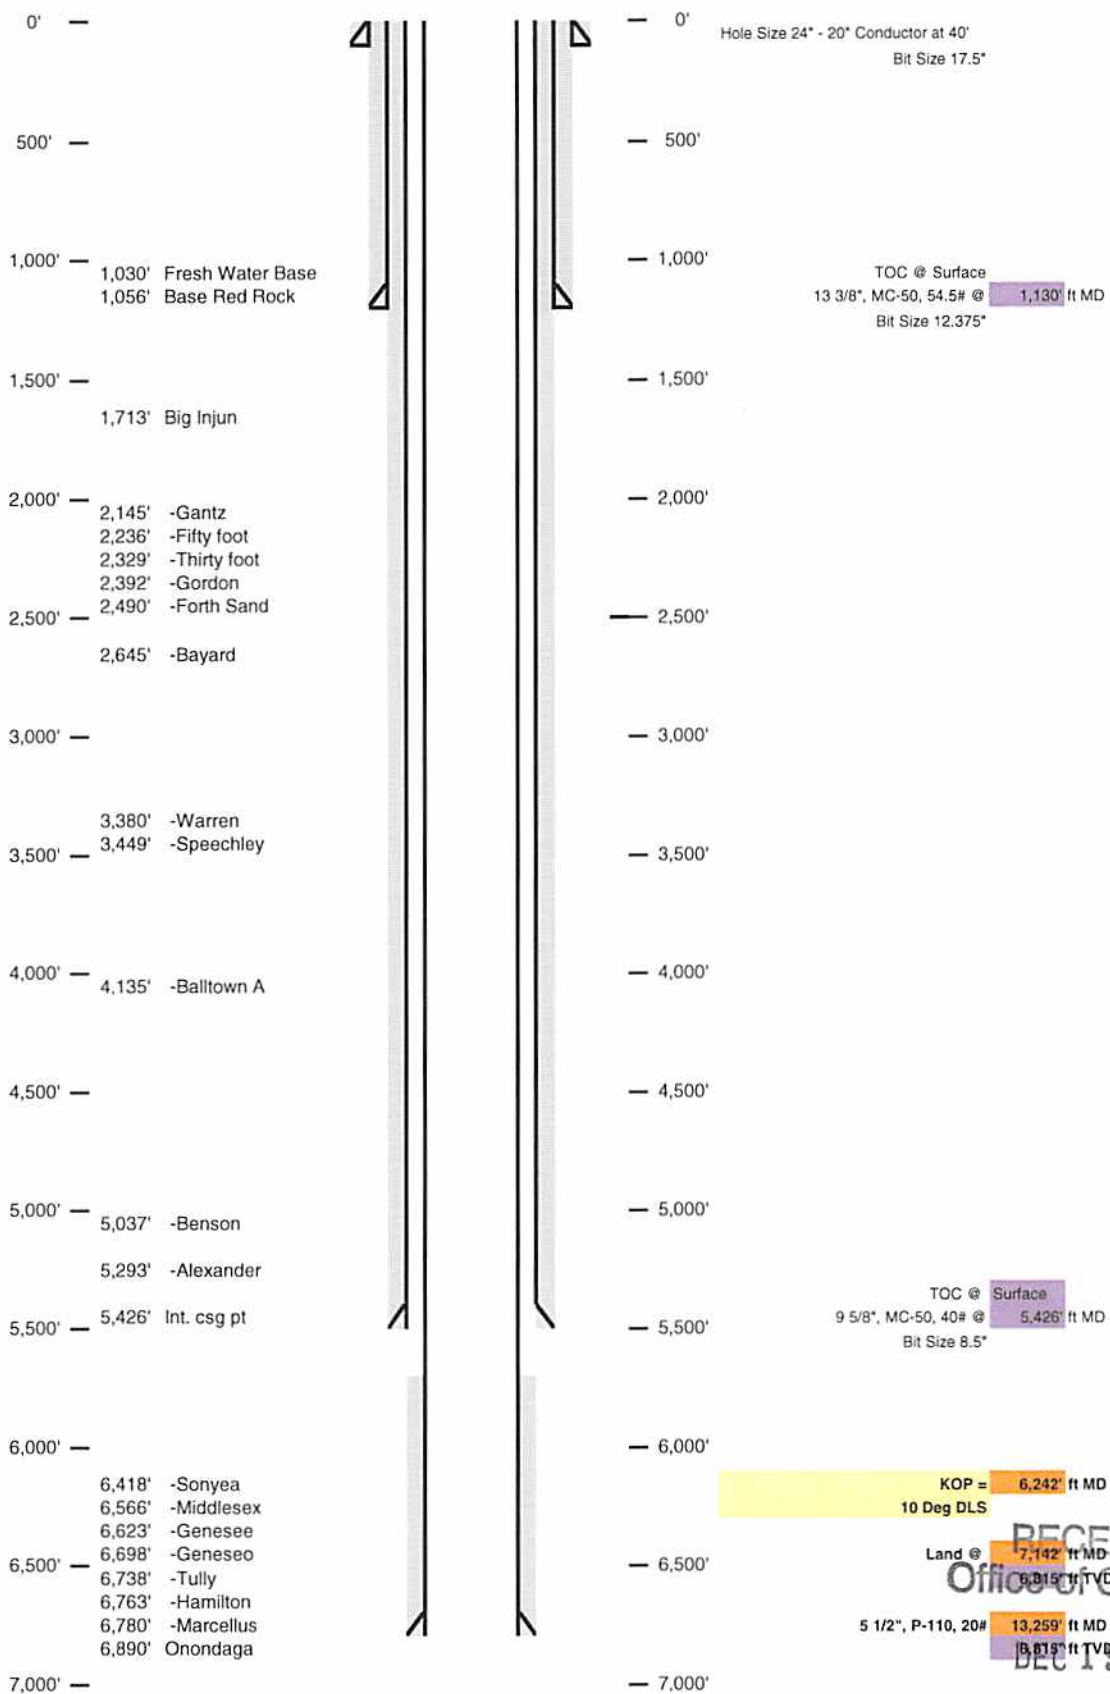


RECEIVED
Office of Oil & Gas
DEC 19 2013
WV Department of
Environmental Protection

EQT PRODUCTION CO. LEWIS MAXWELL LEASE WELL NO. WV 513346

WATER SAMPLES

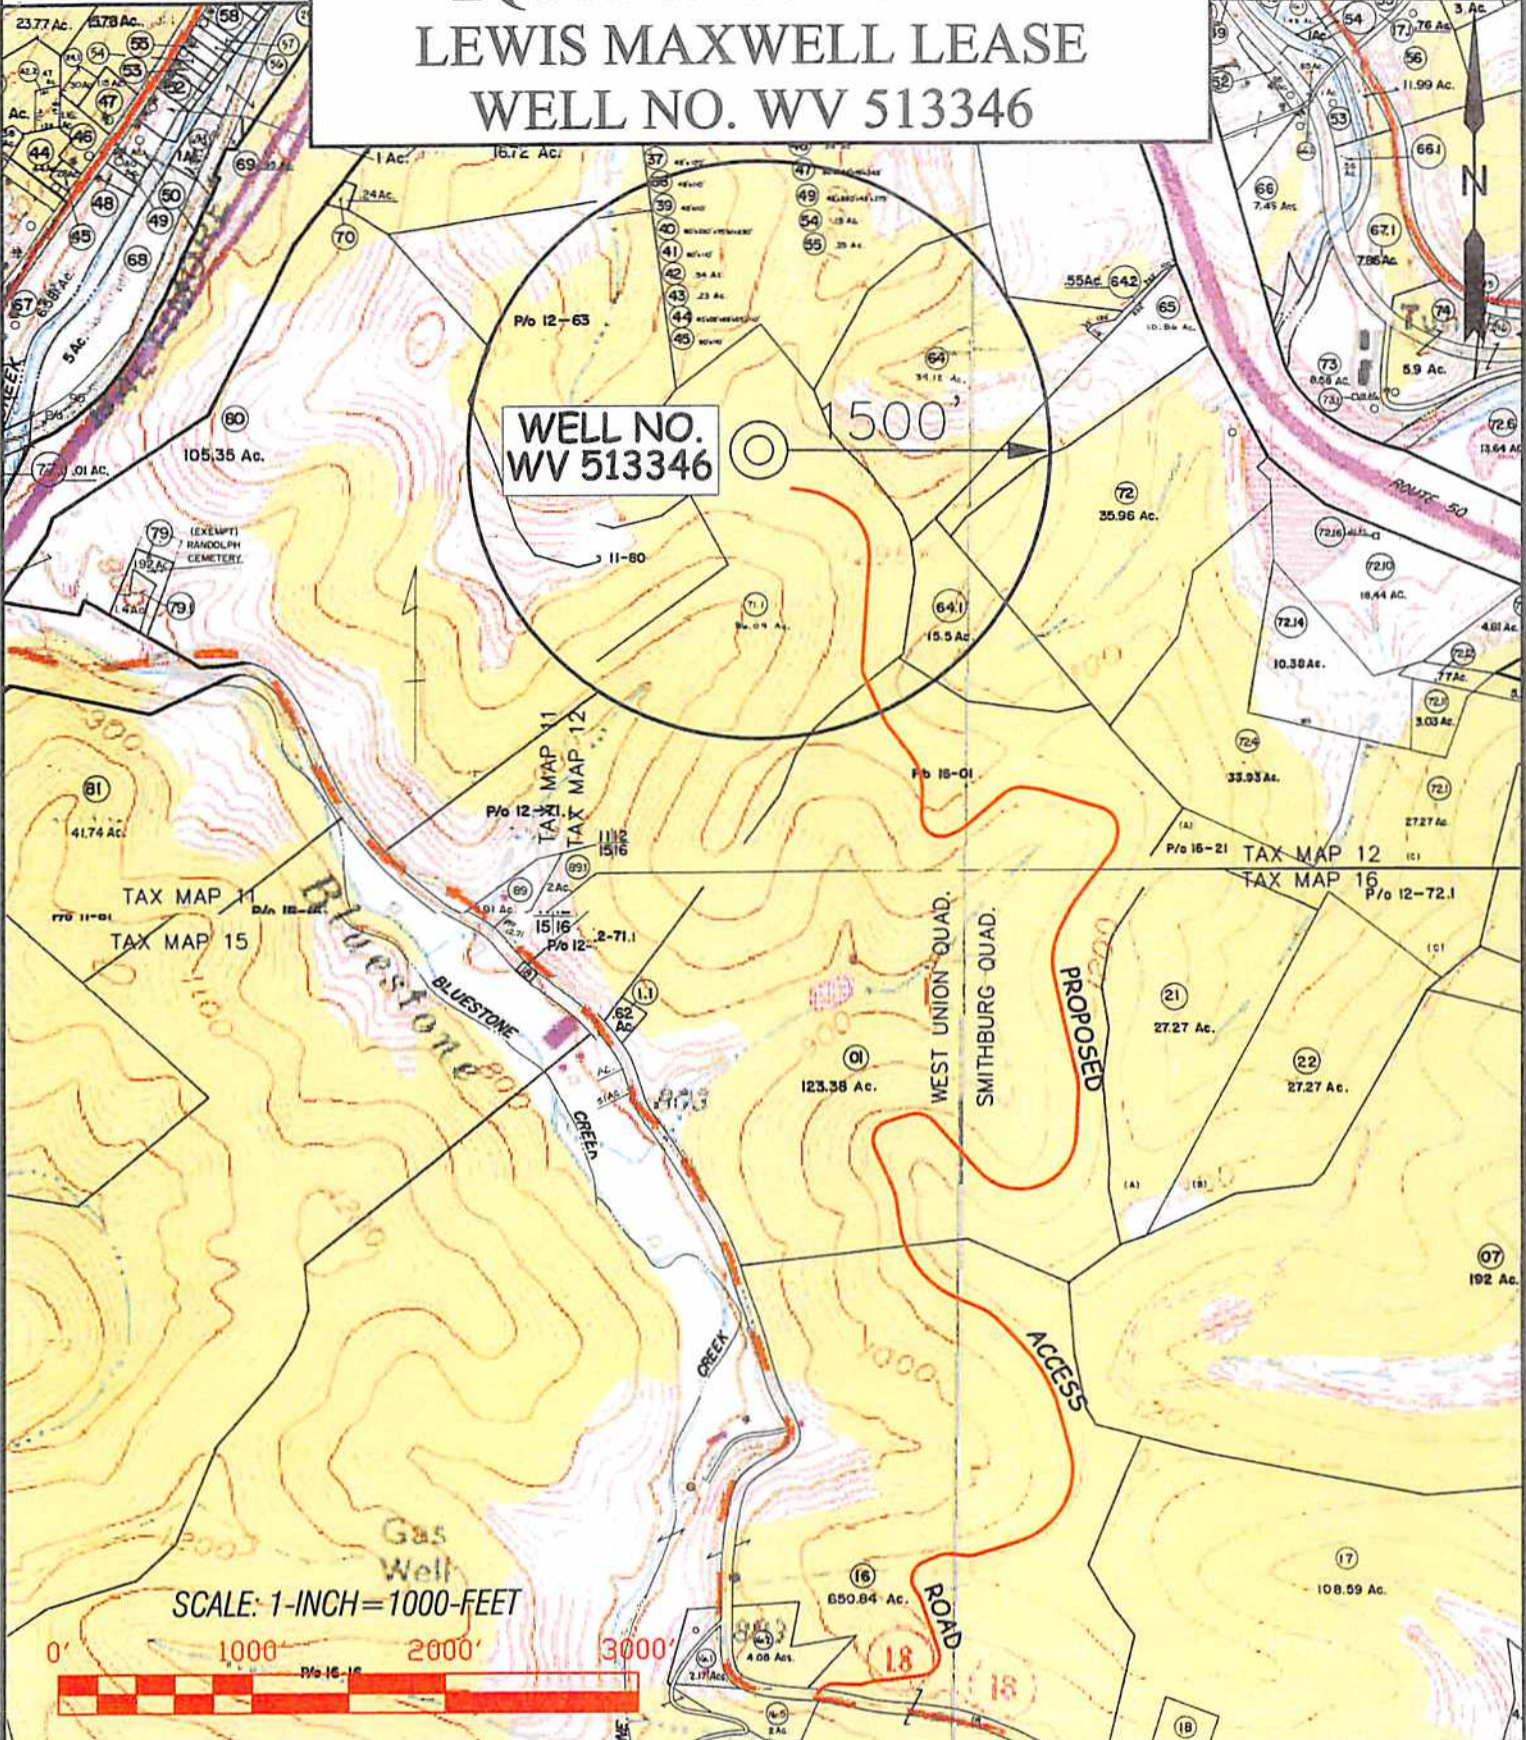

SCALE: 1-INCH=1000-FEET

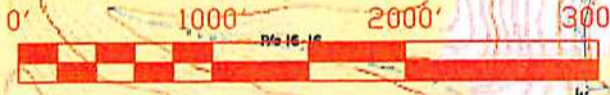

Professional Energy Consultants
A Division of SLS and Associates

SLS
SOLUTIONS
PRODUCTS
ENGINEERS
ENVIRONMENTAL

200 Union Street
P.O. Box 853
Bridgeport, WV 26305
(206) 632-2222

10000 Green Bottom Road
Huntington, WV 25701
(206) 371-7071

Professional Seal: K.D.W. 07/17/13


DRAWN BY: K.D.W. FILE NO.: 7831 DATE: 07/17/13 CADD FILE: 7831WV513346ROAD.DWG

TOPO SECTION OF:
WEST UNION, WV 7.5' QUAD.

DISTRICT	COUNTY	TAX MAP-PARCEL NO.
WEST UNION	DODDRIGE	12-71.1

OPERATOR:
EQT PRODUCTION CO.
115 PROFESSIONAL PLACE
P.O. BOX 280
BRIDGEPORT, WV. 26330

04/04/2014
RECEIVED
Office of Oil and Gas
JUL 26 2013
WV Department of
Environmental Protection

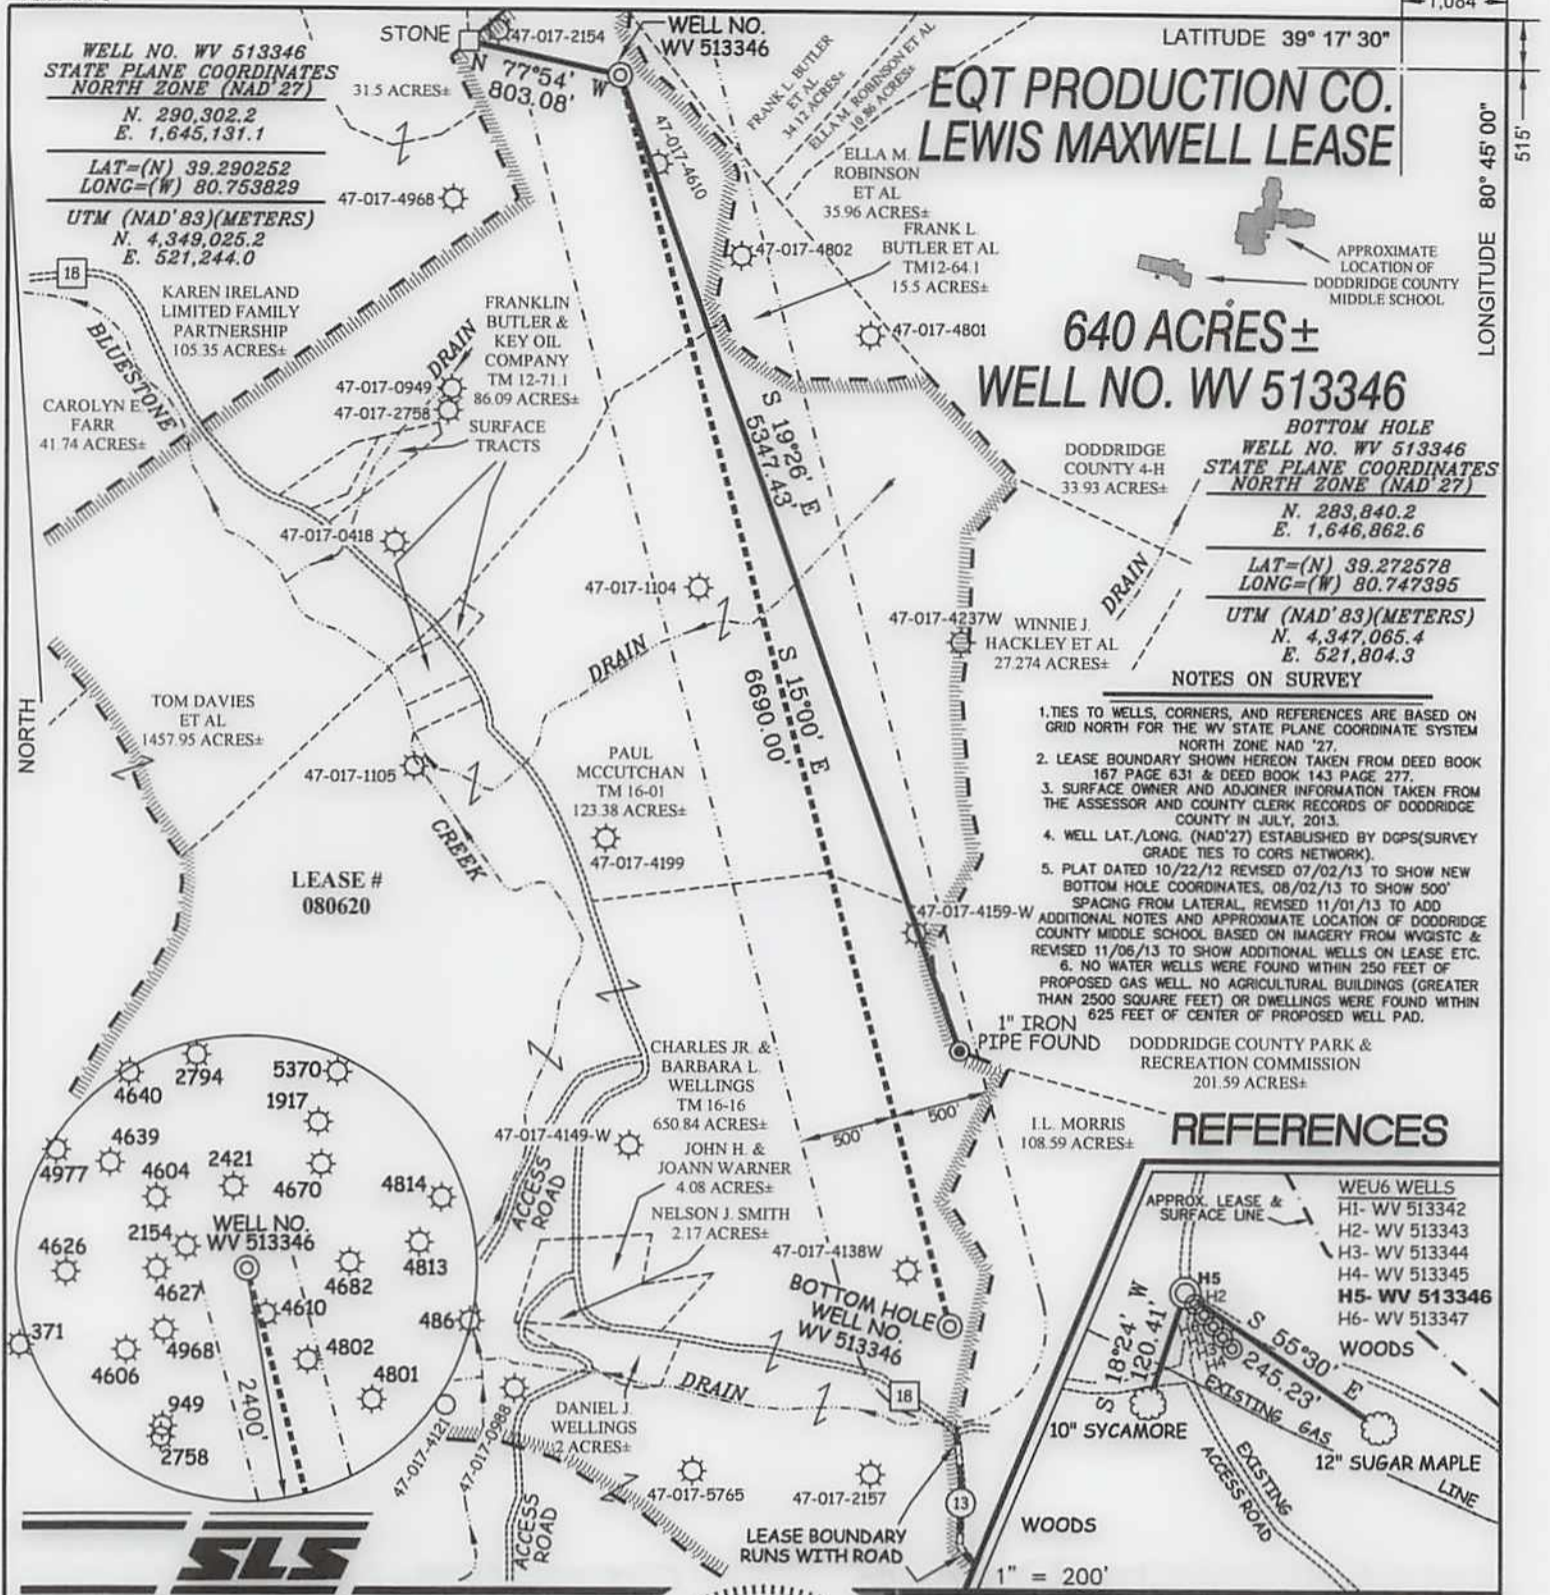

**EQT PRODUCTION CO.
LEWIS MAXWELL LEASE**

**640 ACRES±
WELL NO. WV 513346**


**BOTTOM HOLE
WELL NO. WV 513346
STATE PLANE COORDINATES
NORTH ZONE (NAD'27)**

N. 283,840.2
E. 1,646,862.6
LAT=(N) 39.272578
LONG=(W) 80.747395
UTM (NAD'83)(METERS)
N. 4,347,065.4
E. 521,804.3

NOTES ON SURVEY

1. TIES TO WELLS, CORNERS, AND REFERENCES ARE BASED ON GRID NORTH FOR THE WV STATE PLANE COORDINATE SYSTEM NORTH ZONE NAD '27.
2. LEASE BOUNDARY SHOWN HEREON TAKEN FROM DEED BOOK 167 PAGE 631 & DEED BOOK 143 PAGE 277.
3. SURFACE OWNER AND ADJOINER INFORMATION TAKEN FROM THE ASSESSOR AND COUNTY CLERK RECORDS OF DODDRIDGE COUNTY IN JULY, 2013.
4. WELL LAT./LONG. (NAD'27) ESTABLISHED BY DGPS(SURVEY GRADE TIES TO CORS NETWORK).
5. PLAT DATED 10/22/12 REVISED 07/02/13 TO SHOW NEW BOTTOM HOLE COORDINATES, 08/02/13 TO SHOW 500' SPACING FROM LATERAL, REVISED 11/01/13 TO ADD ADDITIONAL NOTES AND APPROXIMATE LOCATION OF DODDRIDGE COUNTY MIDDLE SCHOOL BASED ON IMAGERY FROM WVGIS & REVISED 11/06/13 TO SHOW ADDITIONAL WELLS ON LEASE ETC.
6. NO WATER WELLS WERE FOUND WITHIN 250 FEET OF PROPOSED GAS WELL. NO AGRICULTURAL BUILDINGS (GREATER THAN 2500 SQUARE FEET) OR DWELLINGS WERE FOUND WITHIN 625 FEET OF CENTER OF PROPOSED WELL PAD.

REFERENCES

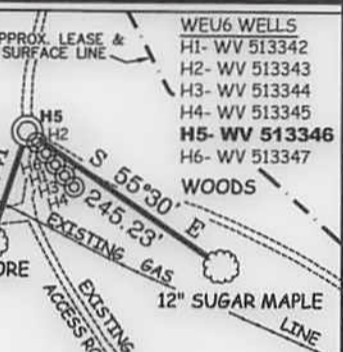

I THE UNDERSIGNED, HEREBY CERTIFY THAT THIS PLAT IS CORRECT TO THE BEST OF MY KNOWLEDGE AND BELIEF AND SHOWS ALL THE INFORMATION REQUIRED BY LAW AND THE REGULATIONS ISSUED AND PRESCRIBED BY THE DIVISION OF ENVIRONMENTAL PROTECTION.

P.S. 677 *Gregory A. Smith*



(+) DENOTES LOCATION OF WELL ON UNITED STATES TOPOGRAPHIC MAPS.
DATE NOVEMBER 6, 20 13
OPERATORS WELL NO. WV 513346
API WELL NO. 47 - 017 - 06324 HGA
STATE COUNTY PERMIT

MINIMUM DEGREE OF ACCURACY 1 / 200 FILE NO. 7831P513346R3 (390-47)
PROVEN SOURCE OF ELEVATION DGPS (SURVEY GRADE TIES TO CORS NETWORK) SCALE 1" = 1000'

STATE OF WEST VIRGINIA
DIVISION OF ENVIRONMENTAL PROTECTION
OFFICE OF OIL AND GAS

WELL TYPE: OIL GAS LIQUID INJECTION WASTE DISPOSAL IF "GAS" PRODUCTION STORAGE DEEP SHALLOW

LOCATION: ELEVATION 1,266 (GROUND) 1,261' (PROPOSED) WATERSHED BLUESTONE CREEK & MIDDLE ISLAND CREEK
DISTRICT WEST UNION COUNTY DODDRIDGE QUADRANGLE WEST UNION 7.5'
SURFACE OWNER FRANKLIN BUTLER & KEY OIL COMPANY ACREAGE 86.09±
ROYALTY OWNER LEWIS MAXWELL HEIRS ACREAGE 640± LEASE NO. 080620
PROPOSED WORK: DRILL CONVERT DRILL DEEPER REDRILL FRACTURE OR STIMULATE PLUG OFF OLD
FORMATION PERFORATE NEW FORMATION PLUG AND ABANDON CLEAN OUT AND REPLUG OTHER
PHYSICAL CHANGE IN WELL (SPECIFY) _____ TARGET FORMATION MARCELLUS
ESTIMATED DEPTH _____

WELL OPERATOR EQT PRODUCTION COMPANY DESIGNATED AGENT REX C. RAY
ADDRESS 115 PROFESSIONAL PLACE P.O. BOX 280 BRIDGEPORT, WV 26330 ADDRESS 115 PROFESSIONAL PLACE P.O. BOX 280 BRIDGEPORT, WV 26330

COUNTY NAME
PERMIT