






Plot spotted  
Geo ✓

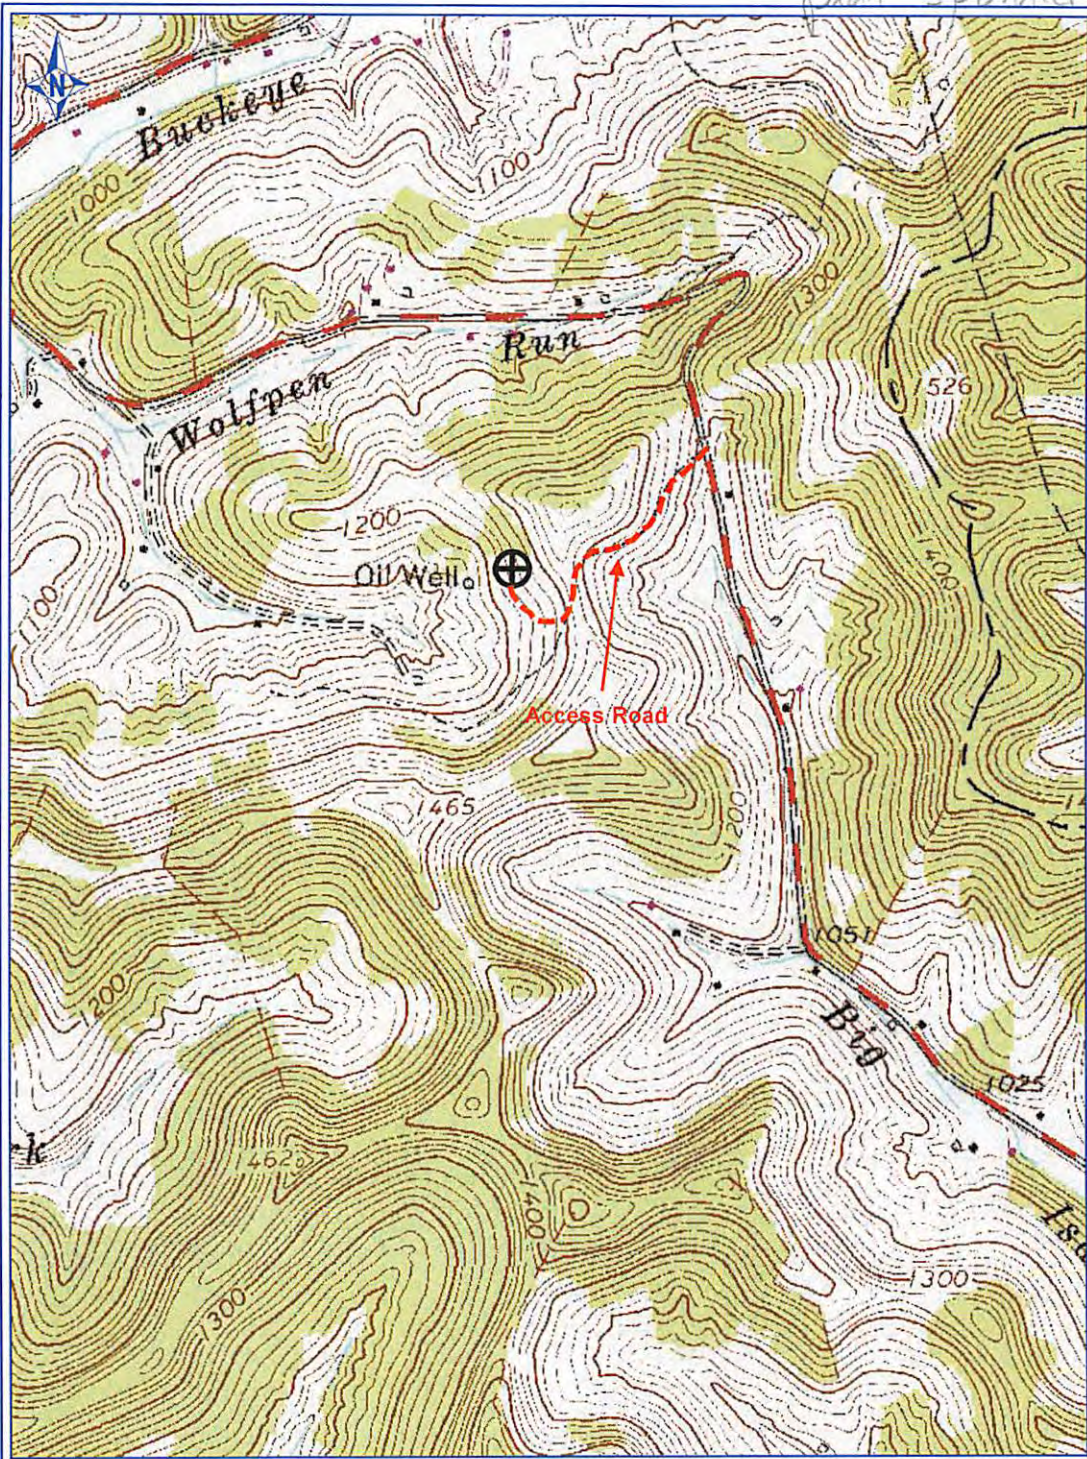

PETRA 4/17/2013 9:34:30 AM

DCN  
8-22-2013

### Antero Resources Corp

APPALACHIAN BASIN

Pauline Unit 1H

REMARKS  
QUADRANGLE: BIG ISAAC  
WATERSHED: WOLFPEN RUN  
OF BUCKEYE CREEK  
DISTRICT: GREENBRIER

By: ECM



**17-06350 H6A PAULINE UNIT 1H  
ANTERO RESOURCES**

PAD NAME: JOHN NORTH

Received

AUG 23 2013

Office of Oil and Gas  
WV Dept. of Environmental Protection