



west virginia department of environmental protection

Office of Oil and Gas
601 57th Street SE
Charleston, WV 25304
(304) 926-0450
(304) 926-0452 fax

Earl Ray Tomblin, Governor
Randy C. Huffman, Cabinet Secretary
www.dep.wv.gov

PERMIT MODIFICATION APPROVAL

August 12, 2014

CNX GAS COMPANY LLC
POST OFFICE BOX 1248
JANE LEW, WV 26378

Re: Permit Modification Approval for API Number 1706411 , Well #: OXFD 11 CHS
Intermediate casing depth changed

Oil and Gas Operator:

The Office of Oil and Gas has reviewed the attached permit modification for the above referenced permit. The attached modification has been approved and well work may begin. Please be reminded that the oil and gas inspector is to be notified twenty-four (24) hours before permitted well work is commenced.

Please call James Martin at 304-926-0499, extension 1654 if you have any questions.

Sincerely,

Gene Smith
Assistant Chief of Permitting
Office of Oil and Gas



Carolinda Flanagan
 Permitting Analyst
 P.O. Box 1248
 Jane Lew, WV 26378
 (304) 884-2057



May 16, 2014

West Virginia Department of Environmental Protection
 Office of Oil & Gas
 Attn: Laura Cooper
 601 57th Street, SE
 Charleston, WV 25304-2345

RE: OXFD11HS - Modifications (Intermediate Casing Depth Change)

Dear Laura,

Enclosed, please find for your approval and consideration, updated casing modifications where the intermediate casing depths have been changed. The casing modifications are for the following laterals:

WELL NUMBER	API NUMBER
OXFD11AHS	4701706409
OXFD11BHS	4701706410
OXFD11CHS	4701706411
OXFD11DHS	4701706412
OXFD11EHS	4701706413
OXFD11KHS	4701706414

Should you need any additional information, please contact me at (304) 884-2057 or by email at carolindaflanagan@consolenergy.com. Thank you!

Sincerely,

Carolinda Flanagan

RECEIVED
 Office of Oil and Gas

MAY 20 2014

West Virginia Department of
 Environmental Protection

08/15/2014

STATE OF WEST VIRGINIA
DEPARTMENT OF ENVIRONMENTAL PROTECTION, OFFICE OF OIL AND GAS
WELL WORK PERMIT APPLICATION

1) Well Operator: CNX Gas Company LLC 494458046 Doddridge Southwest Oxford
Operator ID County District Quadrangle

2) Operator's Well Number: OXFD11CHS Well Pad Name: OXFD11HS

3) Farm Name/Surface Owner: I.L. Morris Public Road Access: Co. Rt. 19/11

4) Elevation, current ground: 1340' Elevation, proposed post-construction: 1310'

5) Well Type (a) Gas Oil Underground Storage
Other _____

(b) If Gas Shallow Deep _____
Horizontal _____

6) Existing Pad: Yes or No NO

7) Proposed Target Formation(s), Depth(s), Anticipated Thickness and Associated Pressure(s):
Target - Burkett, Depth - 6875', Thickness - 50', Pressure - 2000#

8) Proposed Total Vertical Depth: 6925'

9) Formation at Total Vertical Depth: Burkett

10) Proposed Total Measured Depth: 13862'

11) Proposed Horizontal Leg Length: 6270'

12) Approximate Fresh Water Strata Depths: 50', 620'

13) Method to Determine Fresh Water Depths: Offset Well

14) Approximate Saltwater Depths: 1180', 2085'

15) Approximate Coal Seam Depths: 620'

16) Approximate Depth to Possible Void (coal mine, karst, other): None Anticipated

17) Does Proposed well location contain coal seams directly overlying or adjacent to an active mine? Yes No

(a) If Yes, provide Mine Info: Name: _____
Depth: _____
Seam: _____
Owner: _____

RECEIVED
Office of Oil and Gas
RECEIVED
Office of Oil and Gas
MAY 20 2014
MAY 20 2014
WV Department of
Environmental Protection
Environmental Protection

WW-6B
(9/13)

18)

CASING AND TUBING PROGRAM

<u>TYPE</u>	<u>Size</u>	<u>New or Used</u>	<u>Grade</u>	<u>Weight per ft. (lb/ft)</u>	<u>FOOTAGE: For Drilling</u>	<u>INTERVALS: Left in Well</u>	<u>CEMENT: Fill-up (Cu. Ft.)</u>
Conductor	20"	N	L.S.	81.3#	100'	100'	Grout to surface w/ Class A type cement
Fresh Water	13 3/8"	N	J-55	54.5#	690'	690'	CTS w/ Class A Type Cement
Coal							
Intermediate	9 5/8"	N	J-55	36#	2800'	2800'	CTS w/ Class A Type Cement
Production	5 1/2"	N	P-110	20#	13862'	13862'	2200 cu. ft. w/ 50/50 POZ Lead & Class A
Tubing	2 3/8"	N	J-55	4.7#	7375'	7375'	
Liners							

*DCW
5-2-2014*

<u>TYPE</u>	<u>Size</u>	<u>Wellbore Diameter</u>	<u>Wall Thickness</u>	<u>Burst Pressure</u>	<u>Cement Type</u>	<u>Cement Yield (cu. ft./k)</u>
Conductor	20"	26"	0.438	2110	Class A Type	1.18
Fresh Water	13 3/8"	17 1/2"	0.380	2730	Class A Type	1.39
Coal						
Intermediate	9 5/8"	12 3/8"	0.352	3520	Class A Type	1.18
Production	5 1/2"	8 3/4" & 8 1/2"	0.361	12640	Class A Type	1.26
Tubing	2 3/8"	5 1/2" Csg	0.190	7700
Liners						

PACKERS

Kind:	None				RECEIVED Office of Oil and Gas MAY 20 2014 WV Department of Environmental Protection
Sizes:	None				
Depths Set:	None				

WW-6B
(9/13)

19) Describe proposed well work, including the drilling and plugging back of any pilot hole:

Drill and stimulate new horizontal Marcellus well. Well to be drilled to a TMD of 13862'. Well to be drilled to a TVD of 6925', formation at TVD - Burkett. If an unexpected void is encountered, plan will be to set casing at a minimum of 30' past void and cement to surface with approved Class A type cement.

20) Describe fracturing/stimulating methods in detail, including anticipated max pressure and max rate:

The stimulation will be multiple stages divided over the lateral length of the well. Stage spacing is dependent upon engineering design. Slickwater fracturing technique will be utilized on each stage using sand, water, and chemicals. Max Pressure - 9500 psi. Max Rate - 100 bbl/min.

21) Total Area to be disturbed, including roads, stockpile area, pits, etc., (acres): 24.4 Acres

22) Area to be disturbed for well pad only, less access road (acres): 20.4 Acres

23) Describe centralizer placement for each casing string:

Conductor - No centralizers used. Fresh Water & Coal - Bow spring centralizers on first joint then every fourth joint to 100 feet from surface. Intermediate - Bow spring centralizers one on the first two joints and every fourth joint until inside surface casing. Production - Rigid bow spring centralizer on first joint then every 2 casing joints (free floating) through the lateral and the curve. (Note: cementing the 5 1/2" casing completely in open hole lateral and curve.)

24) Describe all cement additives associated with each cement type:

Conductor - 2% CaCl₂. Fresh Water/Coal - 2% CaCl₂. Intermediate - 2% CaCl₂. Production - 2.6% Cement extender, 0.7% Fluid loss additive, 0.5% High Temperature Retarder, 0.2% Friction Reducer

25) Proposed borehole conditioning procedures:

Conductor - The hole is drilled w/ air and casing ran in air. Apart from insuring the hole is clean via air circulation at TD, there are no other conditioning procedures. Fresh Water/Coal - The hole is drilled w/ air and casing is ran in air. Once casing is on bottom, the casing shoe will be cleared with fresh water and gel prior to cementing. Intermediate - The hole is drilled w/ air and casing is ran in air. Once casing is on bottom, the casing shoe will be cleared with fresh water and gel prior to cementing. (Note: Drilling soap may be utilized if the hole gets wet/damp during the drilling of all pipe strings with the exception of the conductor). Production - The hole will be drilled with synthetic oil base mud and once at TD the hole is circulated at a drilling pump rate until the hole is clean. Once casing is ran the hole is circulated for a minimum of one hole volume prior to pumping cement.

RECEIVED

Office of Oil and Gas

MAY 10 2014

Department of Environmental Protection

*Note: Attach additional sheets as needed.


S.W. STOUT LEASE OXFD 11 WELL NO.S AHS-KHS

017 06411




**NOTE: SEE SITE PLAN
OXFD 11 FOR COMPLETE
CONSTRUCTION &
EROSION & SEDIMENT
CONTROL DETAILS.**

*Drawn
10-1-13*

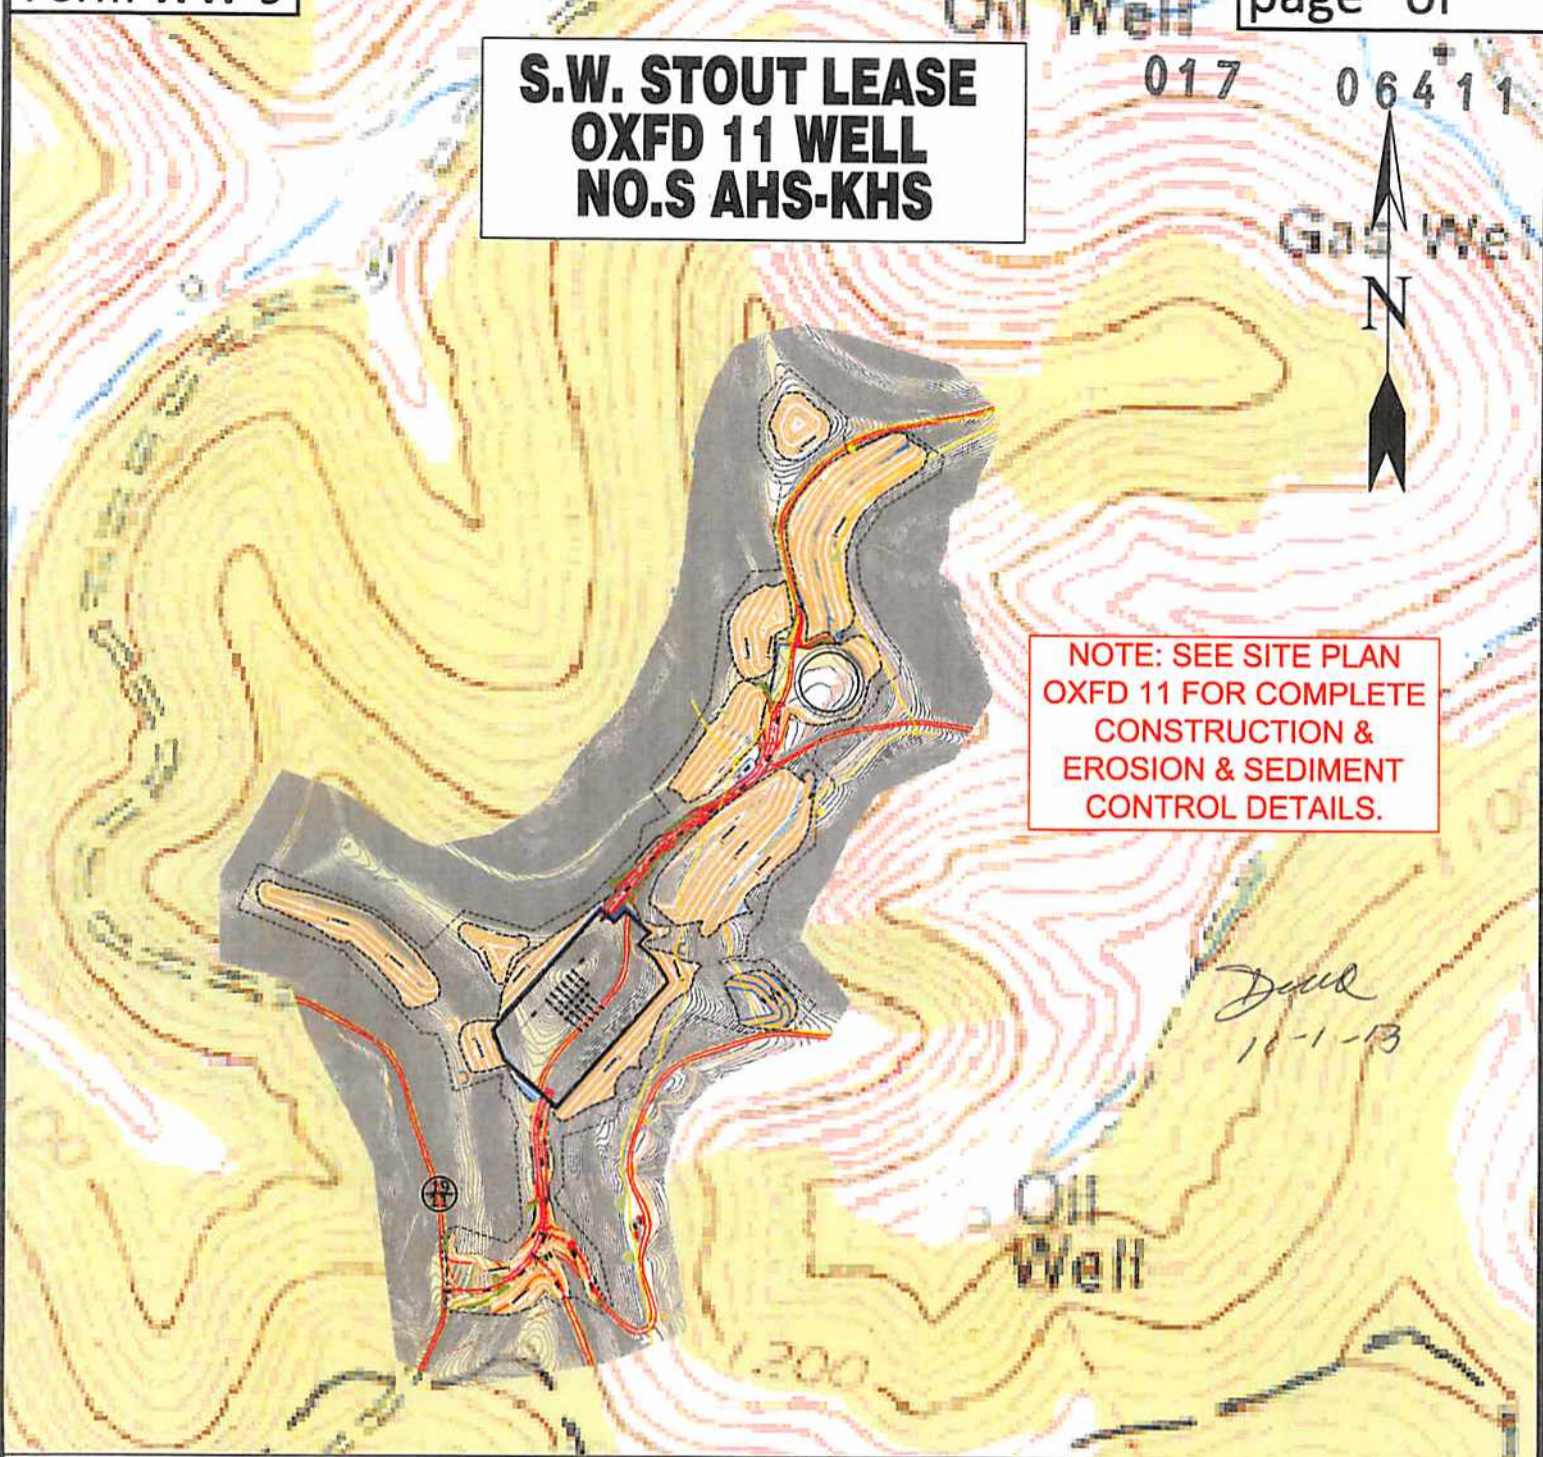

Detail Sketch for Proposed AHS-KHS Wells

**NOTE: SEE SITE PLAN
OXFD 11 FOR COMPLETE
CONSTRUCTION &
EROSION & SEDIMENT
CONTROL DETAILS.**

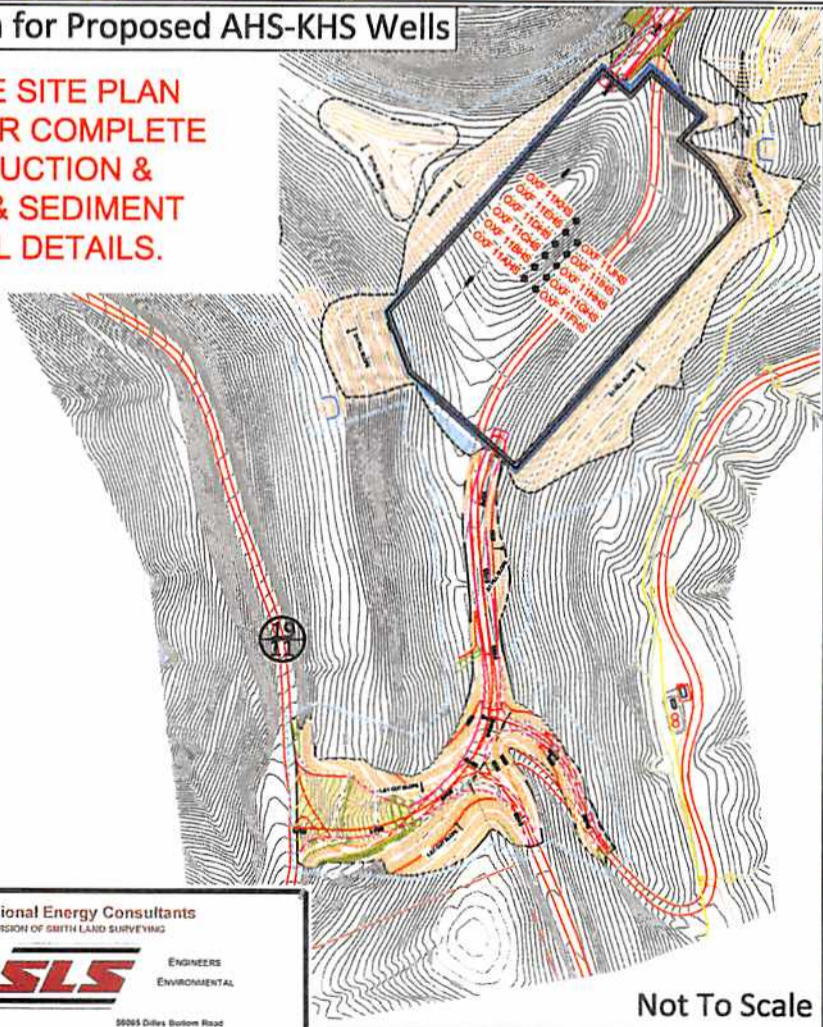

Not To Scale

08/15/2014



Professional Energy Consultants
A DIVISION OF SMITH LAND SURVEYING

SURVEYORS
PROJECT MGMT



ENGINEERS
ENVIRONMENTAL

226 West 13th St.
P.O. Box 130
Glenville, WV 26031
(204) 462-8334

89065 Delta Bottom Road
Shadyville, OH 43087
(740) 671-9911

HONESTY. INTEGRITY. QUALITY

DRAWN BY: K.D.W. FILE NO: 7981 DATE: 10-17-13 CADD FILE: 7981REC-AHS.dwg

TOPO SECTION OF OXFORD 7.5'
USGS TOPO QUADRANGLE


RECEIVED
Office of Oil and Gas

SCALE: 1"=500'





WV Department of
Environmental Protection

S.W. STOUT LEASE WELL NO. OXFD 11 CHS

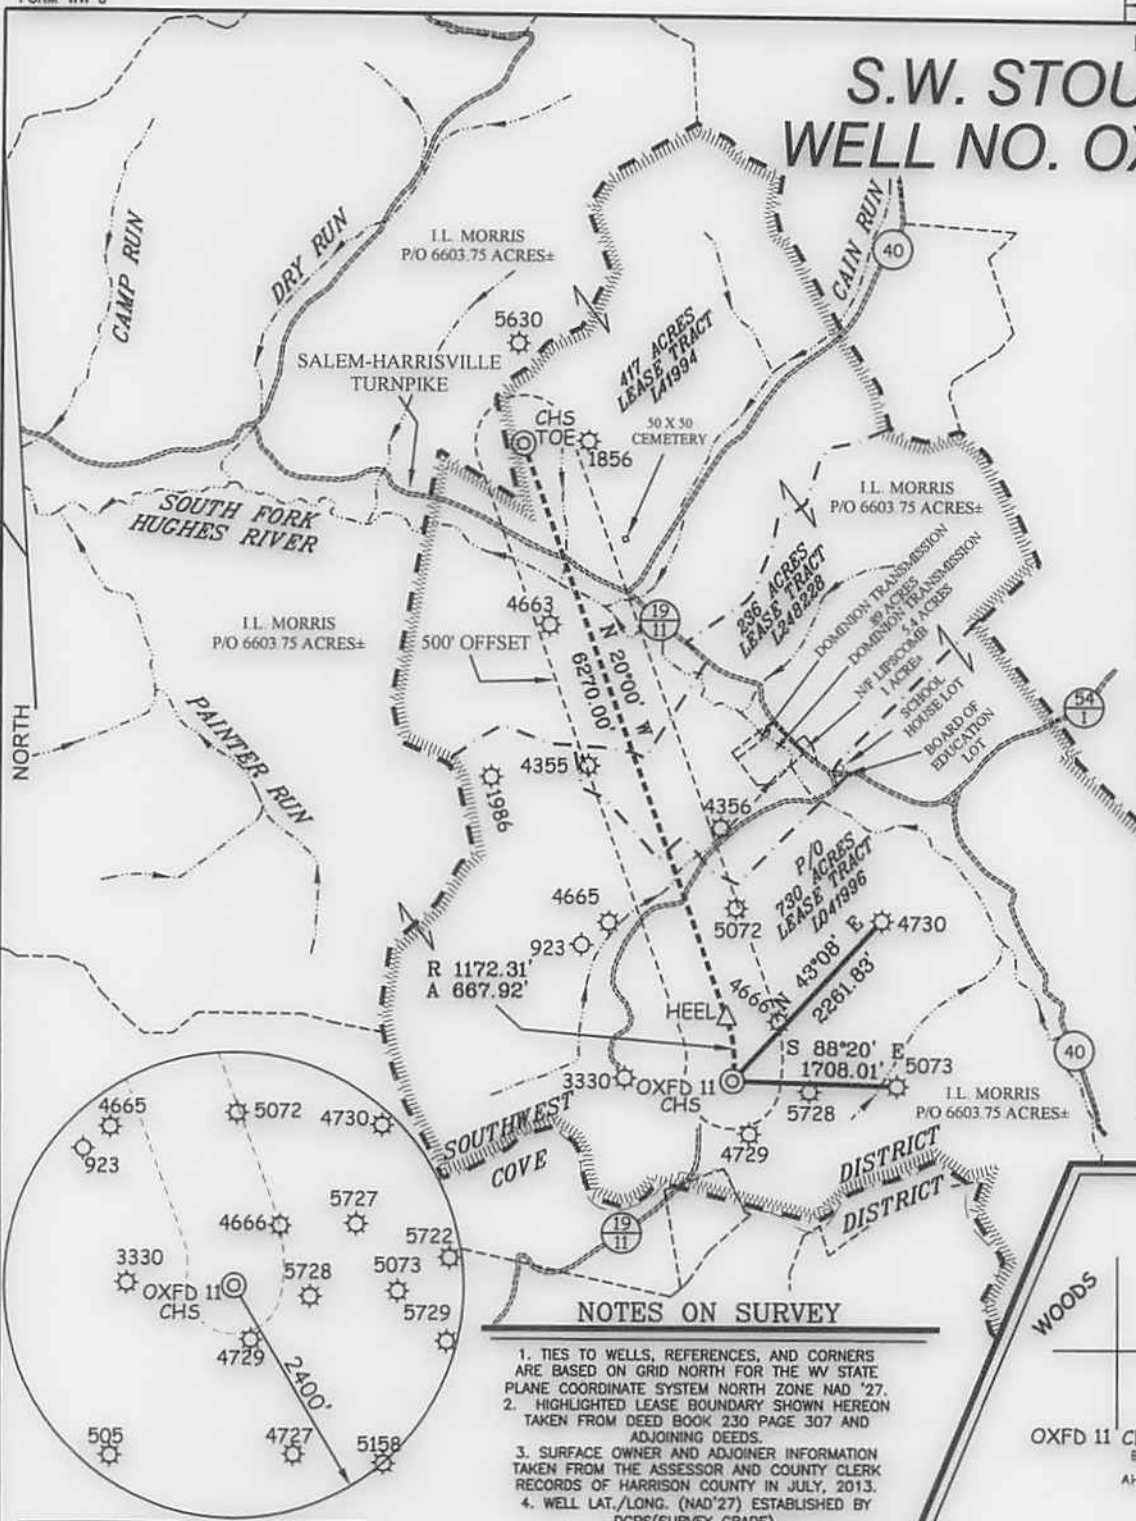

WELL NO. CHS TOP HOLE STATE PLANE COORDINATES (NORTH ZONE NAD '27)
N. 246,787 E. 1,641,715
TOP HOLE (NAD 27)
LAT=(N) 39°10'14.4" LONG=(W) 80°45'49.5"
TOP HOLE (NAD 83)
LAT=(N) 39°10'14.7" LONG=(W) 80°45'48.8"
TOP HOLE UTM (NAD 83)
(N) 4,335,751 (E) 520,424
WELL NO. CHS HEEL POINT STATE PLANE COORDINATES (NORTH ZONE NAD '27)
N. 247,443 E. 1,641,652
HEEL POINT (NAD 27)
LAT=(N) 39°10'20.8" LONG=(W) 80°45'50.4"
HEEL POINT (NAD 83)
LAT=(N) 39°10'21.1" LONG=(W) 80°45'49.7"
HEEL POINT UTM (NAD 83)
(N) 4,335,950 (E) 520,402
WELL NO. CHS TOE POINT STATE PLANE COORDINATES (NORTH ZONE NAD '27)
N. 253,335 E. 1,639,508
TOE POINT (NAD 27)
LAT=(N) 39°11'18.8" LONG=(W) 80°46'18.6"
TOE POINT (NAD 83)
LAT=(N) 39°11'19.1" LONG=(W) 80°46'18.1"
TOE POINT UTM (NAD 83)
(N) 4,337,734 (E) 519,719

REFERENCES

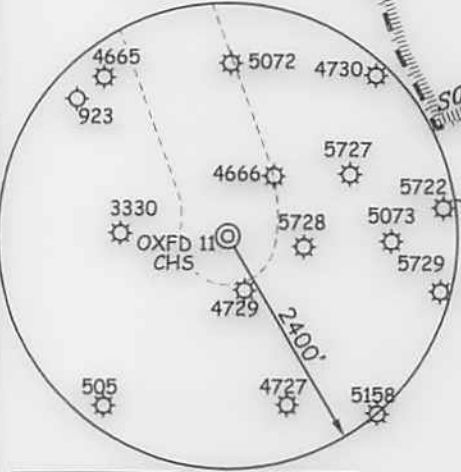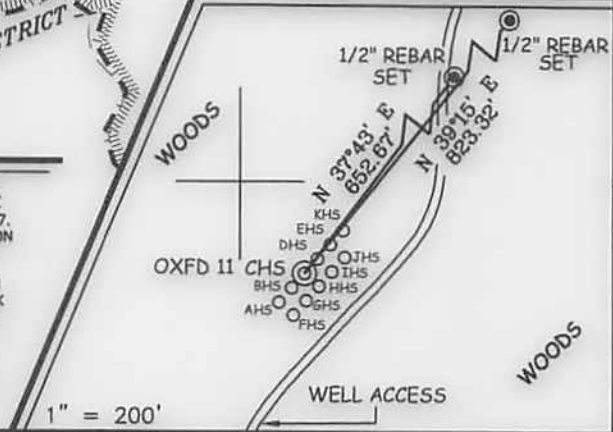

NOTES ON SURVEY

1. TIES TO WELLS, REFERENCES, AND CORNERS ARE BASED ON GRID NORTH FOR THE WV STATE PLANE COORDINATE SYSTEM NORTH ZONE NAD '27.
2. HIGHLIGHTED LEASE BOUNDARY SHOWN HEREON TAKEN FROM DEED BOOK 230 PAGE 307 AND ADJOINING DEEDS.
3. SURFACE OWNER AND ADJOINER INFORMATION TAKEN FROM THE ASSESSOR AND COUNTY CLERK RECORDS OF HARRISON COUNTY IN JULY, 2013.
4. WELL LAT./LONG. (NAD'27) ESTABLISHED BY DGPS(SURVEY GRADE).
5. NO WATER WELLS OR DEVELOPED SPRINGS WITHIN 250'. NO APPLICABLE DWELLINGS OR BUILDINGS WITHIN 625'.



I THE UNDERSIGNED, HEREBY CERTIFY THAT THIS PLAT IS CORRECT TO THE BEST OF MY KNOWLEDGE AND BELIEF AND SHOWS ALL THE INFORMATION REQUIRED BY LAW AND THE REGULATIONS ISSUED AND PRESCRIBED BY THE DIVISION OF ENVIRONMENTAL PROTECTION.

P.S. 677 *Gregory A. Smith*



(+) DENOTES LOCATION OF WELL ON UNITED STATES TOPOGRAPHIC MAPS.
 DATE OCTOBER 17, 20 13
 OPERATORS WELL NO. OXFD 11 CHS
 API WELL NO. 47-017-06411 H6A
 STATE COUNTY PERMIT

MINIMUM DEGREE OF ACCURACY 1/200 FILE NO. 7981PCHS(457-21)
 PROVEN SOURCE OF ELEVATION DGPS (SUBMETER MAPPING GRADE) SCALE 1" = 2,000'

STATE OF WEST VIRGINIA
 DIVISION OF ENVIRONMENTAL PROTECTION
 OFFICE OF OIL AND GAS

WELL TYPE: OIL GAS LIQUID INJECTION WASTE DISPOSAL IF "GAS" PRODUCTION STORAGE DEEP SHALLOW

LOCATION: ELEVATION 1,340' WATERSHED SOUTH FORK HUGHES RIVER
 DISTRICT SOUTHWEST COUNTY DODDRIDGE QUADRANGLE OXFORD 7.5'

SURFACE OWNER I.L. MORRIS ACREAGE 6603.75±

ROYALTY OWNER LINDSAY A EDMONDSON, ETAL & STATE OF WEST VIRGINIA(SALEM HARRISVILLE TURNPIKE) ACREAGE 730, 236, **08/15/2014**

PROPOSED WORK: LEASE NO. L041996, L248228, & L41994

DRILL CONVERT DRILL DEEPER REDRILL FRACTURE OR STIMULATE PLUG OFF OLD

FORMATION PERFORATE NEW FORMATION PLUG AND ABANDON CLEAN OUT AND REPLUG OTHER

PHYSICAL CHANGE IN WELL (SPECIFY) _____ TARGET FORMATION BURKETT
 ESTIMATED DEPTH 6,925' TVD / TMD 13,862'

WELL OPERATOR CNX GAS COMPANY, LLC. DESIGNATED AGENT JEREMY JONES
 ADDRESS P.O. BOX 1248 ADDRESS P.O. BOX 1248
JANE LEW, WV 26378 JANE LEW, WV 26378

COUNTY NAME
 PERMIT