



west virginia department of environmental protection

Office of Oil and Gas
601 57th Street SE
Charleston, WV 25304
(304) 926-0450
(304) 926-0452 fax

Earl Ray Tomblin, Governor
Randy C. Huffman, Cabinet Secretary
www.dep.wv.gov

PERMIT MODIFICATION APPROVAL

December 08, 2014

EQT PRODUCTION COMPANY
303 SAND CUT ROAD
CLARKSBURG, WV 26301

Re: Permit Modification Approval for API Number 1706446 , Well #: WV 514393

Modify landing point, bottom hole and lateral length.

Oil and Gas Operator:

The Office of Oil and Gas has reviewed the attached permit modification for the above referenced permit. The attached modification has been approved and well work may begin. Please be reminded that the oil and gas inspector is to be notified twenty-four (24) hours before permitted well work is commenced.

Please call James Martin at 304-926-0499, extension 1654 if you have any questions.

Sincerely,

Gene Smith
Assistant Chief of Permitting
Office of Oil and Gas



July 30, 2014

Mr. Gene Smith
West Virginia Department of Environmental Protection
Office of Oil and Gas
601 57th Street SE
Charleston, WV 25304

Re: Modification of 47-01706446

Dear Mr. Smith,

EQT would like to modify the landing point, bottom hole and lateral length on the above API #. No additional leases were affected. I have enclosed a new WW-2B, well schematics, mylar plat and copy of rec plan for your review.

If you have any questions, please do not hesitate to contact me at (304) 848-0076.

Sincerely,

A handwritten signature in blue ink, appearing to read 'Vicki Roark'.

Vicki Roark
Permitting Supervisor-WV

Enc.

Received

AUG 5 2014

12/12/14

Office of Oil and Gas
WV Dept. of Environmental Protection

STATE OF WEST VIRGINIA
DEPARTMENT OF ENVIRONMENTAL PROTECTION, OFFICE OF OIL AND GAS
W.VA. CODE §22-6A - WELL WORK PERMIT APPLICATION

017 06446

1) Well Operator: EQT Production Company

Operator ID	017	District	8	Quadrangle	671
-------------	-----	----------	---	------------	-----

2) Operator's Well Number: 514393 Well Pad Name: WEU49

3) Farm Name/Surface Owner: Mary Farr Secrist Farm Public Road Access: 50/42

4) Elevation, current ground: 1,162.0 Elevation, proposed post-construction: 1,130.0

5) Well Type: (a) Gas Oil Underground Storage
Other _____

(b) If Gas: Shallow Deep
 Horizontal

6) Existing Pad? Yes or No: no

7) Proposed Target Formation(s), Depth(s), Anticipated Thicknesses and Associated Pressure(s):
Target formation is Marcellus at a depth of 6648 with the anticipated thickness to be 57 feet and anticipated target pressure of 4474 PSI

8) Proposed Total Vertical Depth: 6,648
9) Formation at Total Vertical Depth: Marcellus
10) Proposed Total Measured Depth: 16,618
11) Proposed Horizontal Leg Length: 8,390
12) Approximate Fresh Water Strata Depths: 243, 292, 352, 487
13) Method to Determine Fresh Water Depth: By offset wells
14) Approximate Saltwater Depths: 1,542
15) Approximate Coal Seam Depths: 340, 483
16) Approximate Depth to Possible Void (coal mine, karst, other): None reported

17) Does proposed well location contain coal seams directly overlying or adjacent to an active mine?

(a) If Yes, provide Mine Info: Name: _____
 Depth: _____
 Seam: _____
 Owner: _____

Doug Newlon
1-31-2014

12/12/14
Received
FEB 5 2014

CASING AND TUBING PROGRAM

18)

TYPE	Size	New or Used	Grade	Weight per ft.	FOOTAGE: for Drilling	INTERVALS: Left in Well	CEMENT: Fill-up (Cu.Ft.)
Conductor	20	New	Varies	Varies	40	40	38
Fresh Water	13 3/8	New	MC-50	81	1,050	1,050	910
Coal							
Intermediate	9 5/8	New	MC-50	40	5,239	5,239	2,056
Production	5 1/2	New	P-110	20	16,955	16,955	See Note 1
Tubing	2 3/8		J-55	4.6			May not be run, if run will be set 100' less than TD
Liners							

MSK
12/3/14

TYPE	Size	Wellbore Diameter	Wall Thickness	Burst Pressure	Cement Type	Cement Yield (cu. ft./k)
Conductor	20	24	0.375	-	Construction	1.18
Fresh Water	13 3/8	17 1/2	0.38	2,480	1	1.21
Coal						
Intermediate	9 5/8	12 3/8	0.395	3,590	1	1.21
Production	5 1/2	8 1/2	0.361	12,640	-	1.27/1.86
Tubing						
Liners						

Packers

Kind:	N/A			
Sizes:	N/A			
Depths Set:	N/A			

Note 1: EQT plans to bring the TOC on the production casing cement job 1,000' above kick off point, which is at least 500' above the shallowest production zone, to avoid communication.

19) Describe proposed well work, including the drilling and plugging back of any pilot hole:

Drill and complete a new horizontal well in the Marcellus formation. The vertical drill to go down to an approximate depth of 5,803'.

Then kick off the horizontal leg using a slick water frac.

20) Describe fracturing/stimulating methods in detail, including anticipated max pressure and max rate:

Hydraulic fracturing is completed in accordance with state regulations using water recycled from previously fractured wells and obtained from freshwater sources. This water is mixed with sand and a small percentage (less than 0.3%) of chemicals (including 15% Hydrochloric acid, gelling agent, gel breaker, friction reducer, biocide, and scale inhibitor), referred to in the industry as a "slickwater" completion. Maximum anticipated treating pressures are expected to average approximately 8500 psi, maximum anticipated treating rates are expected to average approximately 100 bpm. Stage lengths vary from 150 to 300 feet. Average approximately 200,000 barrels of water per stage. Sand sizes vary from 100 mesh to 20/40 mesh. Average approximately 200,000 pounds of sand per stage.

21) Total area to be disturbed, including roads, stockpile area, pits, etc, (acres):

37.4

22) Area to be disturbed for well pad only, less access road (acres):

16.3

23) Describe centralizer placement for each casing string.

• Surface: Bow spring centralizers – One at the shoe and one spaced every 500'.

• Intermediate: Bow spring centralizers– One cent at the shoe and one spaced every 500'.

• Production: One spaced every 1000' from KOP to Int csg shoe

24) Describe all cement additives associated with each cement type.

Surface (Type 1 Cement): 0-3% Calcium Chloride

Used to speed the setting of cement slurries.

0.4% flake. Loss Circulation Material (LCM) is used to combat the loss of the cement slurry to a thief zone.

Intermediate (Type 1 Cement): 0-3% Calcium Chloride. Salt is used in shallow, low temperature formations to speed the setting of cement slurries. 0.4% flake. Loss Circulation Material (LCM) is used to combat the loss of whole drilling fluid or cement slurry (not filtrate) to a thief zone.

Production:

Lead (Type 1 Cement): 0.2-0.7% Lignosulfonate (Retarder). Lengthens thickening time.

0.3% CFR (dispersant). Makes cement easier to mix.

Tail (Type H Cement): 0.25-0.40% Lignosulfonate (Retarder). Lengthens thickening time.

0.2-0.3% CFR (dispersant). This is to make the cement easier to mix.

60 % Calcium Carbonate. Acid solubility.

0.4-0.6% Halad (fluid loss). Reduces amount of water lost to formation.

25) Proposed borehole conditioning procedures. **Surface:** Circulate hole clean (Approximately 30-45 minutes) rotating & reciprocating

one full joint until cuttings diminish at surface. When cuttings returning to surface diminish, continue to circulate an additional 5

minutes. To ensure that there is no fill, short trip two stands with no circulation. If there is fill, bring compressors back on

and circulate hole clean. A constant rate of higher than expected cuttings volume likely indicates washouts that will not clean up.

Intermediate: Circulate hole clean (Approximately 30-45 minutes) rotating & reciprocating one full joint until cuttings diminish at

surface. When cuttings returning to surface diminish, continue to circulate an additional 5 minutes. If foam drilling, to enhance

hole cleaning use a soap sweep or increase injection rate & foam concentration.

Production: Pump marker sweep with nut plug to determine actual hole washout. Calculate a gauge holes bottoms up volume.

Perform a cleanup cycle by pumping 3-5 bottoms up or until the shakers are clean. Check volume of cuttings coming across

the shakers every 15 minutes.

*Note: Attach additional sheets as needed.

Received

AUG 5 2014 12/12/14


Office of Oil and Gas
WV Dept. of Environmental Protection

4701706446
MOD

Well Schematic
EQT Production

Well Name 514393 (WEU49H4)
County Doddridge
State West Virginia

Elevation KB: 1143
Target Marcellus
Prospect
Azimuth 155
Vertical Section 9329

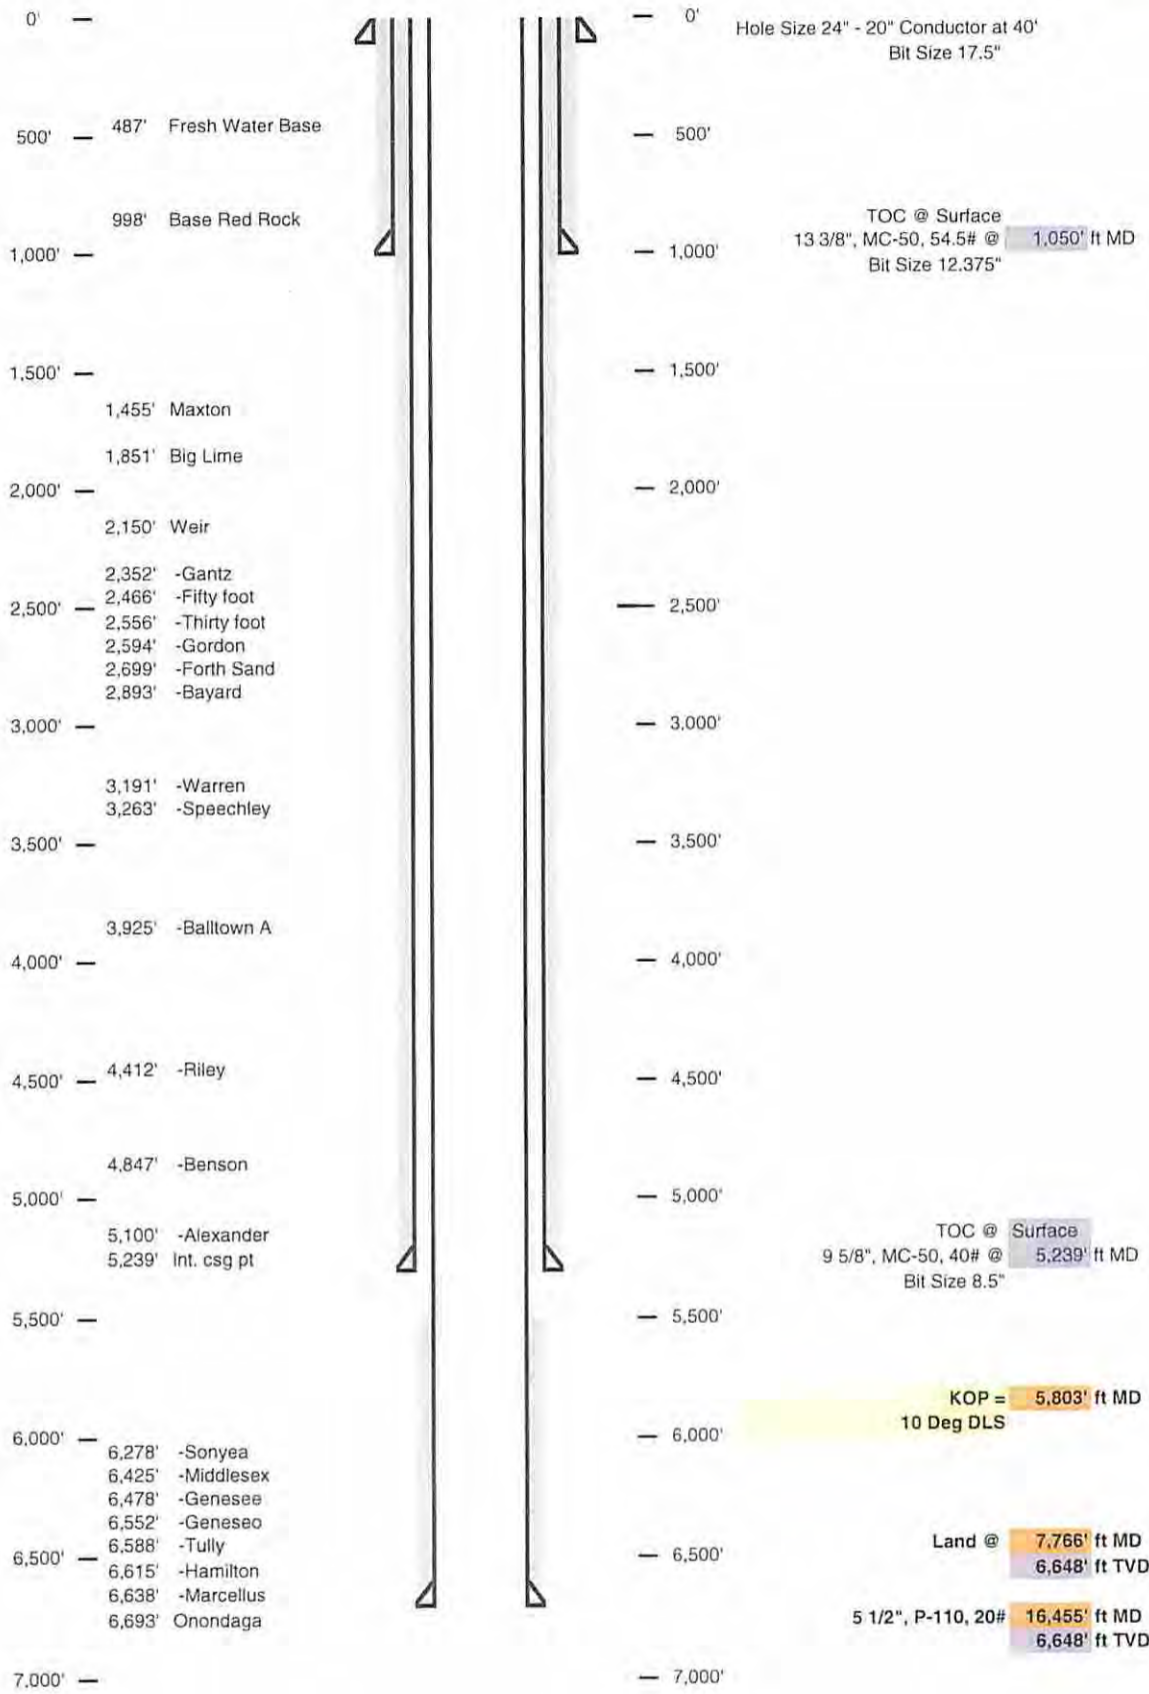

Received

AUG 5 2014 12/12/14

Office of Oil and Gas
WV Dept. of Environmental Protection

NOTES ON SURVEY

1. NO WATER WELLS WERE FOUND WITHIN 250' OF PROPOSED GAS WELL. NO AGRICULTURAL BUILDINGS ≥ 2500 SQ. FT. OR DWELLINGS WERE FOUND WITHIN 625' OF THE CENTER OF PROPOSED WELL PAD.

TOM DAVIES ET AL 1437.95 ACRES±

EQT PRODUCTION COMPANY LEWIS MAXWELL LEASE 2,654 ACRES± WELL NO. WV 514393

(S.P.C. NORTH ZONE) (UTM(M) ZONE 17 NORTH)

NAD'27 S.P.C.(FT) N. 277,539.8 E. 1,635,665.4 NAD'27 GEO. LAT-(N) 39.254848 LONG-(W) 80.786623 NAD'83 UTM (M) N. 4,345,089.0 E. 518,425.1


LANDING POINT

NAD'27 S.P.C.(FT) N. 276,505.5 E. 1,634,756.9 NAD'27 GEO. LAT-(N) 39.251972 LONG-(W) 80.789778 NAD'83 UTM (M) N. 4,344,769.2 E. 518,153.6

BOTTOM HOLE

NAD'27 S.P.C.(FT) N. 268,629.7 E. 1,638,429.5 NAD'27 GEO. LAT-(N) 39.230495 LONG-(W) 80.776416 NAD'83 UTM (M) N. 4,342,388.6 E. 519,312.5

NAD 27 GRID NORTH

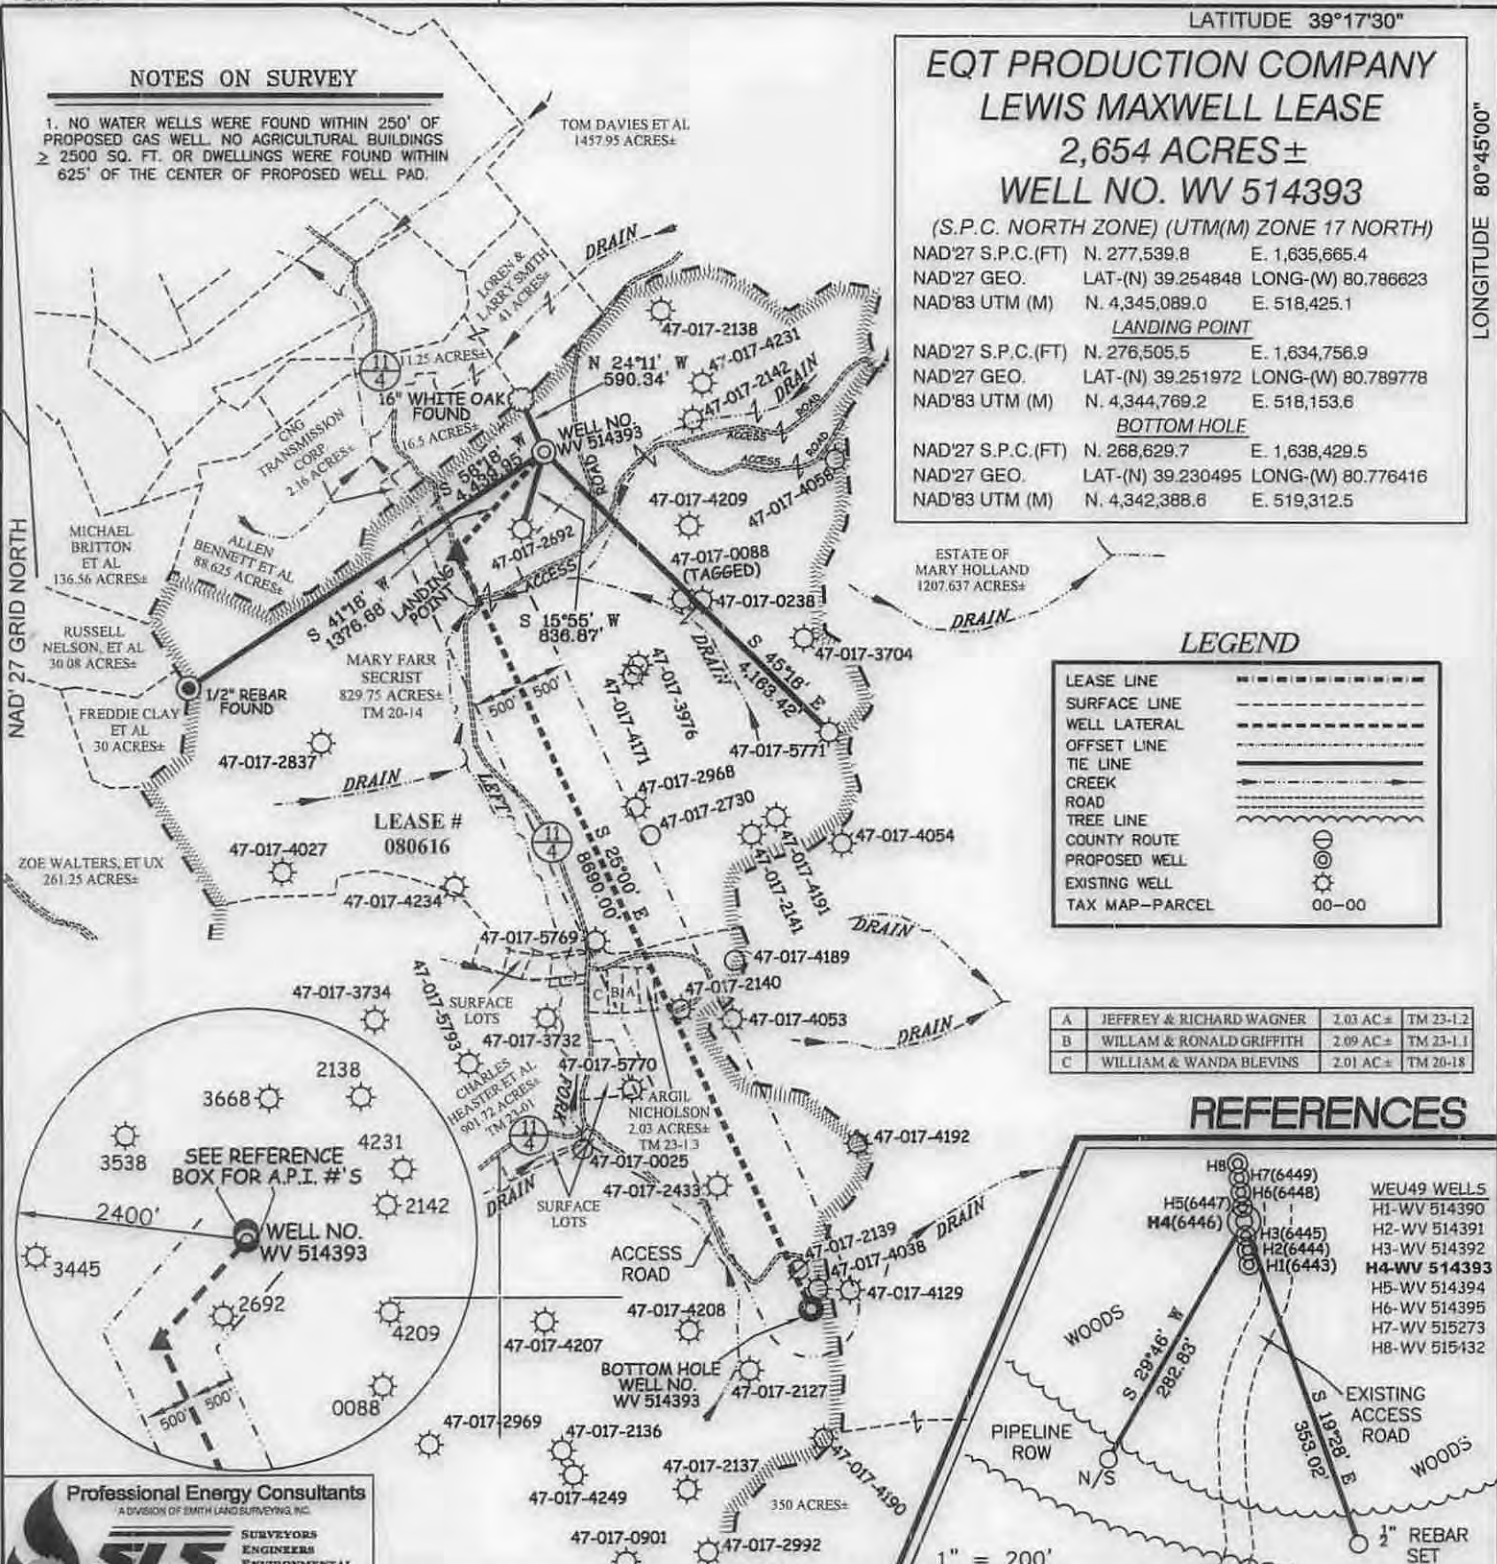


LEGEND

Legend table with symbols for LEASE LINE, SURFACE LINE, WELL LATERAL, OFFSET LINE, TIE LINE, CREEK, ROAD, TREE LINE, COUNTY ROUTE, PROPOSED WELL, EXISTING WELL, TAX MAP-PARCEL.


REFERENCES table with columns A, B, C and descriptions of adjacent parcels.

REFERENCES

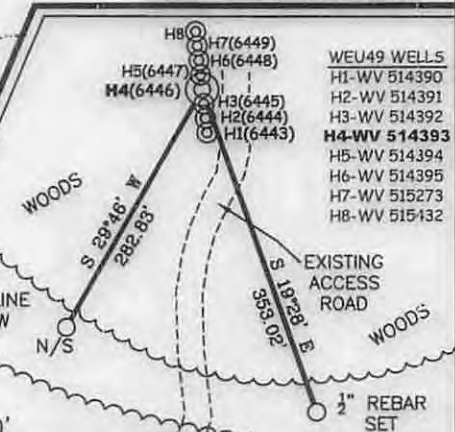

Professional Energy Consultants logo and contact information.

I THE UNDERSIGNED, HEREBY CERTIFY THAT THIS PLAT IS CORRECT TO THE BEST OF MY KNOWLEDGE AND BELIEF AND SHOWS ALL THE INFORMATION REQUIRED BY LAW AND THE REGULATIONS ISSUED AND PRESCRIBED BY THE DIVISION OF ENVIRONMENTAL PROTECTION.

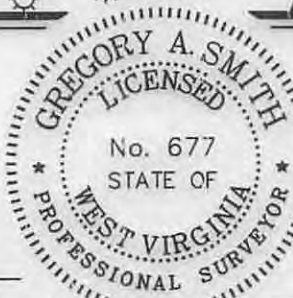

(+) DENOTES LOCATION OF WELL ON UNITED STATES TOPOGRAPHIC MAPS. DATE SEPTEMBER 09, 20 13. REVISED 12/02/13 & 07/01/14. OPERATORS WELL NO. WV 514393. API WELL NO. 47-017-017-06446. STATE COUNTY PERMIT.

MINIMUM DEGREE OF ACCURACY 1/200. FILE NO. 7871P514393R4. SCALE 1" = 2000'. HORIZONTAL & VERTICAL CONTROL DETERMINED BY DGPS (SURVEY GRADE TIE TO CORS NETWORK).

STATE OF WEST VIRGINIA DIVISION OF ENVIRONMENTAL PROTECTION OFFICE OF OIL AND GAS.

WELL TYPE: OIL GAS X INJECTION. WASTE DISPOSAL. IF "GAS" PRODUCTION X STORAGE DEEP SHALLOW X. LOCATION: ELEVATION 1,162'(GROUND) 1,130'(PROPOSED) WATERSHED LEFT FORK OF ARNOLD CREEK. DISTRICT WEST UNION COUNTY DODDRIDGE QUADRANGLE WEST UNION 7.5'. SURFACE OWNER MARY FARR SECRIST ACREAGE 829.75±. ROYALTY OWNER LEWIS MAXWELL HRS ACREAGE 2654±. PROPOSED WORK: DRILL X CONVERT DRILL DEEPER REDRILL FRACTURE OR STIMULATE X PLUG OFF OLD FORMATION PERFORATE NEW FORMATION PLUG AND ABANDON CLEAN OUT AND REPLUG OTHER. PHYSICAL CHANGE IN WELL (SPECIFY) TARGET FORMATION MARCELLUS ESTIMATED DEPTH TVD 6,622'.

WELL OPERATOR EQT PRODUCTION COMPANY DESIGNATED AGENT REX C. RAY. ADDRESS 115 PROFESSIONAL PLACE P.O. BOX 280 BRIDGEPORT, WV 26330.

COUNTY NAME PERMIT

NOTES ON SURVEY

1. NO WATER WELLS WERE FOUND WITHIN 250' OF PROPOSED GAS WELL. NO AGRICULTURAL BUILDINGS ≥ 2500 SQ. FT. OR DWELLINGS WERE FOUND WITHIN 625' OF THE CENTER OF PROPOSED WELL PAD.

TOM DAVIES ET AL. 1457.95 ACRES±

EQT PRODUCTION COMPANY LEWIS MAXWELL LEASE 2,654 ACRES± WELL NO. WV 514393

(S.P.C. NORTH ZONE) (UTM(M) ZONE 17 NORTH)

NAD'27 S.P.C.(FT) N. 277,539.8 E. 1,635,665.4 NAD'27 GEO. LAT.(N) 39.254848 LONG.(W) 80.786623 NAD'83 UTM (M) N. 4,345,089.0 E. 518,425.1

LANDING POINT

NAD'27 S.P.C.(FT) N. 276,505.5 E. 1,634,756.9 NAD'27 GEO. LAT.(N) 39.251972 LONG.(W) 80.789778 NAD'83 UTM (M) N. 4,344,769.2 E. 518,153.6

BOTTOM HOLE

NAD'27 S.P.C.(FT) N. 268,629.7 E. 1,638,429.5 NAD'27 GEO. LAT.(N) 39.230495 LONG.(W) 80.776416 NAD'83 UTM (M) N. 4,342,388.6 E. 519,312.5



LEGEND

Legend table with symbols for LEASE LINE, SURFACE LINE, WELL LATERAL, OFFSET LINE, TIE LINE, CREEK, ROAD, TREE LINE, COUNTY ROUTE, PROPOSED WELL, EXISTING WELL, TAX MAP-PARCEL.

Table with columns A, B, C and rows for JEFFREY & RICHARD WAGNER, WILLIAM & RONALD GRIFFITH, WILLIAM & WANDA BLEVINS.

REFERENCES

Table listing well numbers (H1-H8) and their corresponding TM numbers (23-1-2 to 23-1-18).

Professional Energy Consultants logo and contact information.

I THE UNDERSIGNED, HEREBY CERTIFY THAT THIS PLAT IS CORRECT TO THE BEST OF MY KNOWLEDGE AND BELIEF AND SHOWS ALL THE INFORMATION REQUIRED BY LAW AND THE REGULATIONS ISSUED AND PRESCRIBED BY THE DIVISION OF ENVIRONMENTAL PROTECTION. P.S. 677 Gregory A. Smith



(+) DENOTES LOCATION OF WELL ON UNITED STATES TOPOGRAPHIC MAPS. DATE SEPTEMBER 09 20 13 REVISED 12/02/13 & 07/01/14 OPERATORS WELL NO. WV 514393 API WELL NO. 47-017-06446 STATE COUNTY PERMIT

MINIMUM DEGREE OF ACCURACY 1/200 FILE NO. 7871P514393R4 HORIZONTAL & VERTICAL CONTROL DETERMINED BY DGPS (SURVEY GRADE TIE TO CORS NETWORK) SCALE 1" = 2000'

STATE OF WEST VIRGINIA DIVISION OF ENVIRONMENTAL PROTECTION OFFICE OF OIL AND GAS

WELL TYPE: OIL GAS X INJECTION WASTE DISPOSAL IF "GAS" PRODUCTION X STORAGE DEEP SHALLOW X LOCATION: ELEVATION 1,162'(GROUND) 1,130'(PROPOSED) WATERSHED LEFT FORK OF ARNOLD CREEK DISTRICT WEST UNION COUNTY DODDRIDGE QUADRANGLE WEST UNION 7.5' SURFACE OWNER MARY FARR SECRIST ACREAGE 829.75± ROYALTY OWNER LEWIS MAXWELL HRS ACREAGE 2654± PROPOSED WORK: DRILL X CONVERT DRILL DEEPER REDRILL FRACTURE OR STIMULATE X PLUG OFF OLD FORMATION PERFORATE NEW FORMATION PLUG AND ABANDON CLEAN OUT AND REPLUG OTHER PHYSICAL CHANGE IN WELL (SPECIFY) TARGET FORMATION MARCELLUS ESTIMATED DEPTH TVD 6,622'

WELL OPERATOR EQT PRODUCTION COMPANY DESIGNATED AGENT REX C. RAY ADDRESS 115 PROFESSIONAL PLACE P.O. BOX 280 BRIDGEPORT, WV 26330

Received AUG 5 2014

COUNTY NAME PERMIT

EQT PRODUCTION COMPANY LEWIS MAXWELL LEASE WELL NO. WV 514393



50
42

EXISTING GATE

APPROXIMATE END
END OF CO. RT. 50/42

NOTE:
SEE DESIGN FOR WEU 49 WELLS
FOR A MORE DETAILED EXHIBIT OF PROPOSED
CROSSING & LOCATION OF UTILITIES ETC.

EXISTING WELL
EXISTING GAS LINES

TO WEU 2
WELLS

EXISTING WELL

EXISTING ROAD (PREVIOUSLY UTILIZED)
TO BE RESHAPED AND REGARDED

EXISTING GAS LINES

EXISTING WELL

TO WEU 1
WELLS

340' ± @
15-20% GRADE ±

600' ± @
5-10% GRADE ±

350' ± @
0-5% GRADE ±

PROPOSED
18" CMP

EXISTING GAS LINE

MATCH
LINE

Gas
Well

Gas
Well

SHEET 1 OF 2
SCALE: 1"=500'



ALL ROADS SHOWN HEREON ARE EXISTING UNLESS OTHERWISE NOTED AND SHALL BE MAINTAINED IN ACCORDANCE WITH WV D.E.P. OIL AND GAS BMP MANUAL ENTRANCES AT COUNTY/STATE ROADS SHALL BE MAINTAINED IN ACCORDANCE WITH WV D.O.T. REGULATION SEPARATE PERMITS MAY BE REQUIRED BY THE D.O.T.

SEDIMENT BASINS (TRAPS) AND APPROPRIATE EROSION CONTROL BARRIERS ARE TO BE CONSTRUCTED AT ALL CULVERT AND CROSS DRAIN INLETS AND OUTLETS AS REQUIRED IN THE WV D.E.P. OIL AND GAS BMP MANUAL. FIELD CONDITIONS (ROCK OUTCROPS AND BEDROCK) MAY PROHIBIT INLET TRAPS BEING INSTALLED. WHEN THESE CONDITIONS EXIST ADDITIONAL EROSION CONTROL MEASURES SHALL BE EVALUATED AND UTILIZED AS NEEDED.

EARTHWORK CONTRACTORS ARE RESPONSIBLE FOR NOTIFICATION TO THE OPERATOR AND INSPECTOR PRIOR TO ANY DEVIATION FROM THIS PLAN.

TEMPORARY SEED & MULCH ALL SLOPES AFTER CONSTRUCTION OF LOCATION.

CUT & STACK ALL MARKETABLE TIMBER
STACKED BRUSH MAY BE USED FOR SEDIMENT CONTROL
APPLICATIONS FOR SEPARATE PLC PERMITS ON THE ACCESS ROAD
STREAM CROSSINGS HAVE BEEN PREPARED (IF APPLIES)

12/12/14
AUG 5 2014

EXISTING CULVERT
PROPOSED CULVERT
Office of Oil and Gas
WV Dept. of Environmental Affairs
MIN UNLESS OTHERWISE NOTED
PROPOSED STREAM CROSSING
APPROXIMATE LIMITS OF DISTURBANCE

Professional Energy Consultants
A DIVISION OF SURVEYING

SURVEYORS PROJECT MGMT. **SLS** ENGINEERS ENVIRONMENTAL


225 West Third St.
P.O. Box 139
Charmelle, WV 26031
(204) 462-8634

22983 Drive Bottom Road
Shaysville, OH 43967
(614) 871-8911

Integrity. Integrity. Quality.

TOPO SECTION OF WEST UNION 7.5'
USGS TOPO QUADRANGLE

DRAWN BY: K.D.W. FILE NO.: 7871 DATE: 12/04/13 CADD FILE: 7871RECS14393.dwg

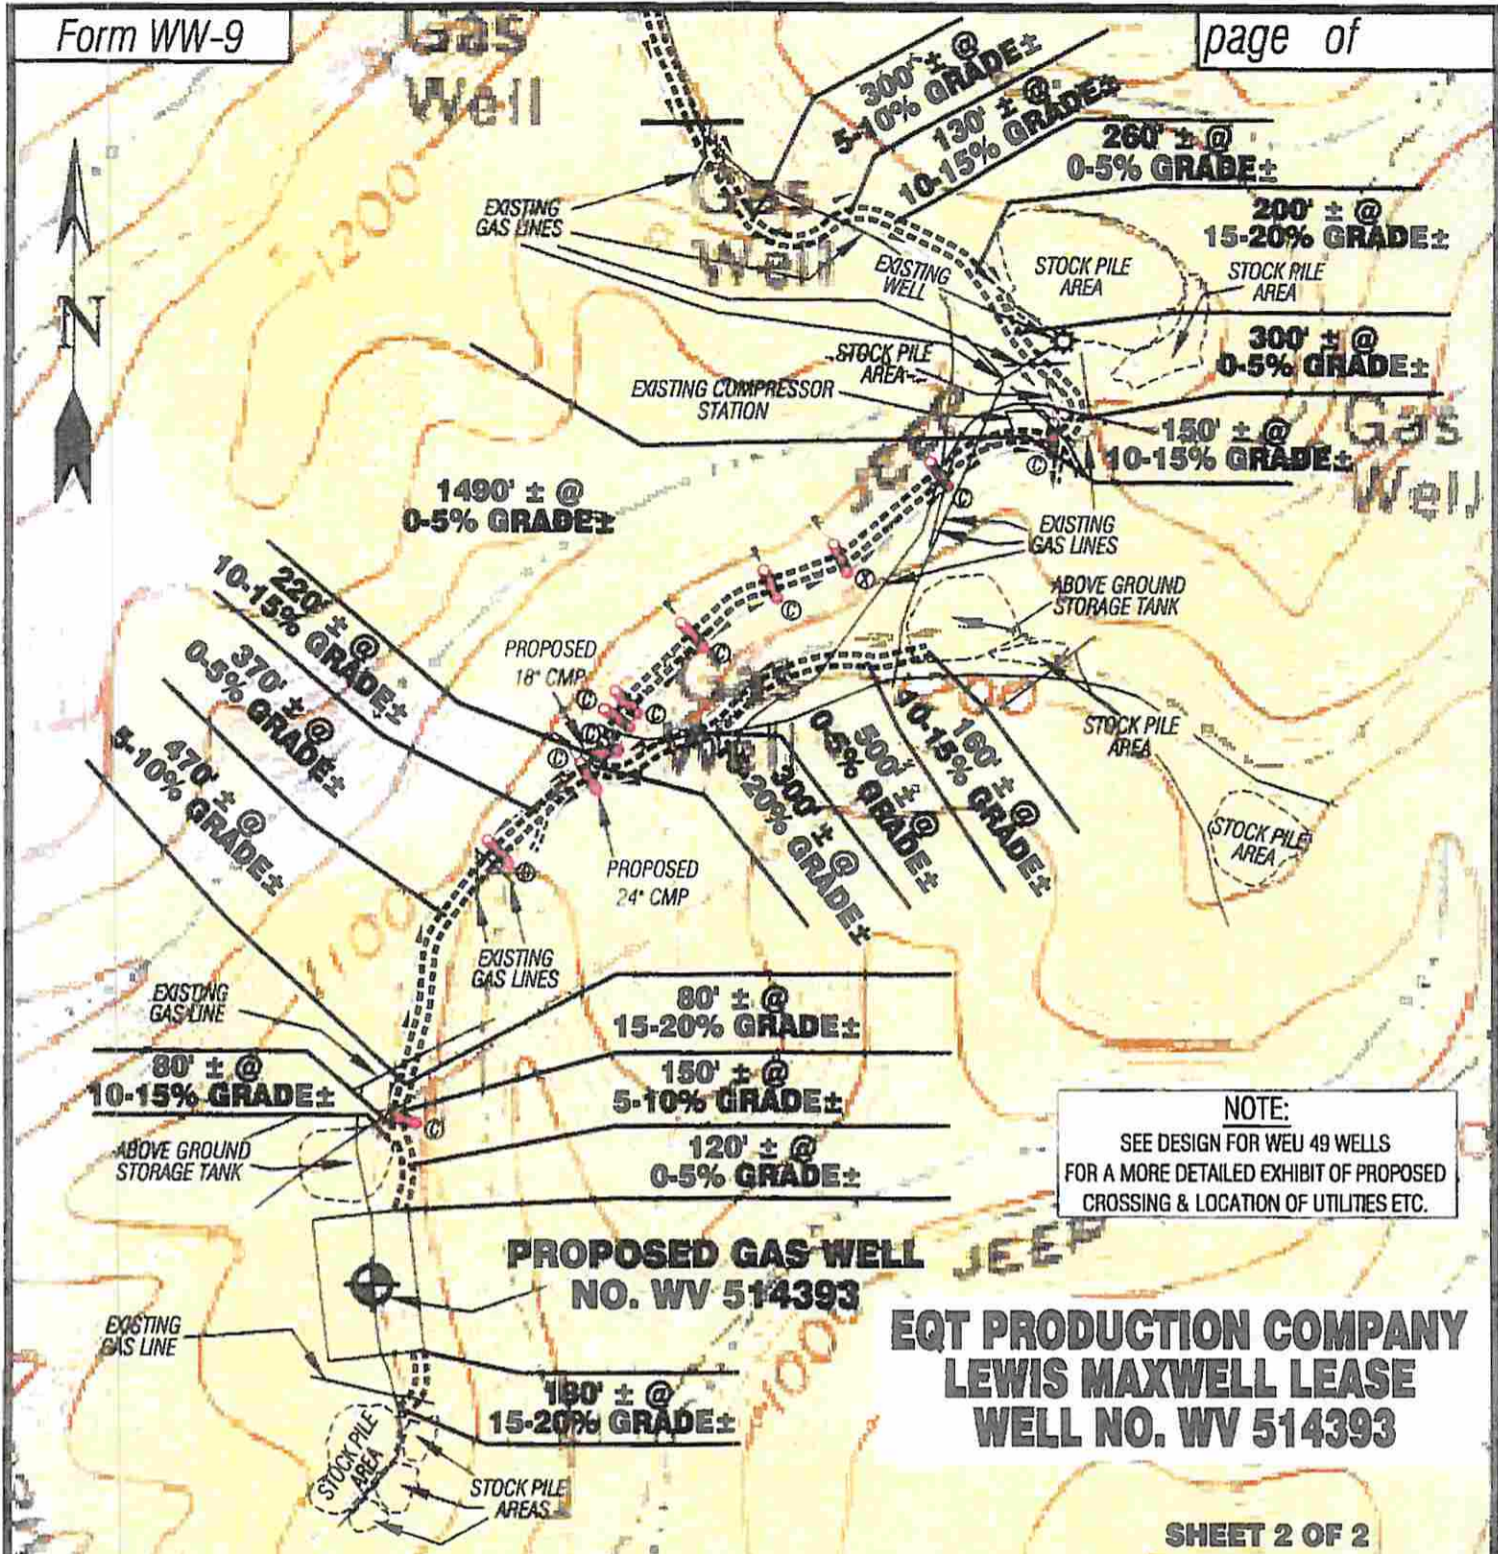

NOTE:
SEE DESIGN FOR WEU 49 WELLS
FOR A MORE DETAILED EXHIBIT OF PROPOSED
CROSSING & LOCATION OF UTILITIES ETC.

**EQT PRODUCTION COMPANY
LEWIS MAXWELL LEASE
WELL NO. WV 514393**


**SHEET 2 OF 2
SCALE: 1" = 500'**



Detail Sketch for Proposed Well WV 514393

- WEU49 WELLS
H1-WV 514390
H2-WV 514391
H3-WV 514392
H4-WV 514393
H5-WV 514394
H6-WV 514395
H7-WV 515273
H8- NOT YET DETERMINED

NOTE:
SEE DESIGN FOR WEU 49 WELLS
FOR A MORE DETAILED EXHIBIT OF PROPOSED
CROSSING & LOCATION OF UTILITIES ETC.

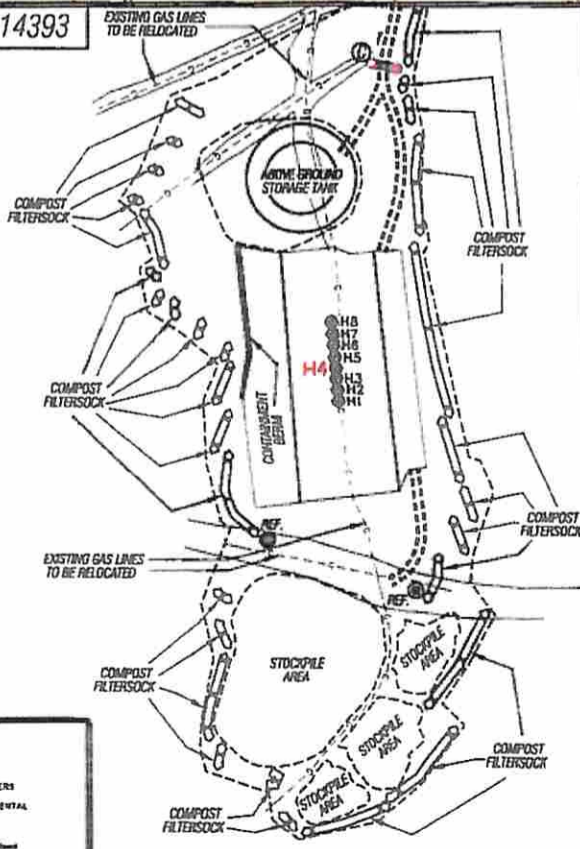

ALL ROADS SHOWN HEREON ARE EXISTING UNLESS OTHERWISE NOTED AND SHALL BE MAINTAINED IN ACCORDANCE WITH WV D.E.P. OIL AND GAS BMP MANUAL ENTRANCES AT COUNTY/STATE ROADS SHALL BE MAINTAINED IN ACCORDANCE WITH WV D.O.T. REGULATION SEPARATE PERMITS MAY BE REQUIRED BY THE D.O.T.

SEDIMENT BASINS (TRAPS) AND APPROPRIATE EROSION CONTROL BARRIERS ARE TO BE CONSTRUCTED AT ALL CULVERT AND CROSS DRAIN INLETS AND OUTLETS AS REQUIRED IN THE WV D.E.P. OIL AND GAS BMP MANUAL. FIELD CONDITIONS (ROCK OUTCROPS AND BEDROCK) MAY PROHIBIT INLET TRAPS BEING INSTALLED. WHEN THESE CONDITIONS EXIST ADDITIONAL EROSION CONTROL MEASURES SHALL BE EVALUATED AND UTILIZED AS NEEDED

EARTHWORK CONTRACTORS ARE RESPONSIBLE FOR NOTIFICATION TO THE OPERATOR AND INSPECTOR PRIOR TO ANY DEVIATION FROM THIS PLAN

TEMPORARY SEED & MULCH ALL SLOPES AFTER CONSTRUCTION OF LOCATION

CUT & STACK ALL MARKETABLE TIMBER

STACKED BRUSH MAY BE USED FOR SEDIMENT CONTROL

APPLICATIONS FOR SEPARATE PLC PERMITS ON THE ACCESS ROAD STREAM CROSSINGS HAVE BEEN PREPARED (IF APPLIES).

- EXISTING CULVERT
- PROPOSED CULVERT 15' MIN UNLESS OTHERWISE NOTED
- ⊗ PROPOSED STREAM CROSSING
- APPROXIMATE LIMITS OF DISTURBANCE

Not To Scale

Professional Energy Consultants
A DIVISION OF BATHURST SURVEYING

SURVEYORS PROJECT MGMT. ENGINEERS ENVIRONMENTAL

SLS

223 Third Street SE
P.O. Box 130
Greenville, WV 26031
(304) 452-5634

20064 Dixie Gateway Road
Shepherd, WV 26167
(781) 671-2611

INCORPORATED, QUALITY

DRAWN BY K.D.W.	FILE NO. 7871	DATE 12/04/13	CADD FILE: 7871REC514393.dwg
--------------------	------------------	------------------	---------------------------------

TOPO SECTION OF WEST UNION 7.5'
USGS TOPO QUADRANGLE