

west virginia department of environmental protection

Office of Oil and Gas 601 57th Street SE Charleston, WV 25304 (304) 926-0450 (304) 926-0452 fax Earl Ray Tomblin, Governor Randy C. Huffman, Cabinet Secretary www.dep.wv,gov

May 29, 2015

WELL WORK PERMIT Horizontal 6A Well

This permit, API Well Number: 47-1706727, issued to ANTERO RESOURCES CORPORATION, is evidence of permission granted to perform the specified well work at the location described on the attached pages and located on the attached plat, subject to the provisions of Chapter 22 of the West Virginia Code of 1931, as amended, and all rules and regulations promulgated thereunder, and to all conditions and provisions outlined in the pages attached hereto. Notification shall be given by the operator to the Oil and Gas Inspector at least 24 hours prior to the construction of roads, locations, and/or pits for any permitted work. In addition, the well operator shall notify the same inspector 24 hours before any actual well work is commenced and prior to running and cementing casing. Spills or emergency discharges must be promptly reported by the operator to 1-800-642-3074 and to the Oil and Gas inspector.

Please be advised that form WR-35, Well Operators Report of Well Work is to be submitted to this office within 90 days completion of permitted well work, as should form WR-34 Discharge Monitoring Report within 30 days of discharge of pits, if applicable. Failure to abide by all statutory and regulatory provisions governing all duties and operations hereunder may result in suspension or revocation of this permit and, in addition, may result in civil and/or criminal penalties being imposed upon the operators.

In addition to the applicable requirements of this permit, and the statutes and rules governing oil and gas activity in WV, this permit may contain specific conditions which must be followed. Permit conditions are attached to this cover letter.

Per 35CSR-4-5.2.g this permit will expire in two (2) years from the issue date unless permitted well work is commenced. If there are any questions, please feel free to contact me at (304) 926-0499 ext. 1654.

Operator's Well No: NOVA UNIT 2H

Farm Name: COASTAL FOREST RESOURCES

API Well Number: 47-1706727

Permit Type: Horizontal 6A Well

Date Issued: 05/29/2015

PERMIT CONDITIONS

West Virginia Code § 22-6A-8(d) allows the Office of Oil and Gas to place specific conditions upon this permit. Permit conditions have the same effect as law. Failure to adhere to the specified permit conditions may result in enforcement action.

CONDITIONS

- 1. This proposed activity may require permit coverage from the United States Army Corps of Engineers (USACE). Through this permit, you are hereby being advised to consult with USACE regarding this proposed activity.
- 2. If the operator encounters an unanticipated void, or an anticipated void at an unanticipated depth, the operator shall notify the inspector within 24 hours. Modifications to the casing program may be necessary to comply with W. Va. Code § 22-6A-5a (12), which requires drilling to a minimum depth of thirty feet below the bottom of the void, and installing a minimum of twenty (20) feet of casing. Under no circumstance should the operator drill more than fifty (50) feet below the bottom of the void or install less than twenty (20) feet of casing below the bottom of the void.
- 3. When compacting fills, each lift before compaction shall not be more than 12 inches in height, and the moisture content of the fill material shall be within limits as determined by the Standard Proctor Density test of the actual soils used in specific engineered fill, ASTM D698, Standard Test Method for Laboratory Compaction Characteristics of Soil Using Standard Effort, to achieve 95 % compaction of the optimum density. Each lift shall be tested for compaction, with a minimum of two tests per lift per acre of fill. All test results shall be maintained on site and available for review.
- 4. Operator shall install signage per § 22-6A-8g (6) (B) at all source water locations included in their approved water management plan within 24 hours of water management plan activation.
- 5. Oil and gas water supply wells will be registered with the Office of Oil and Gas and all such wells will be constructed and plugged in accordance with the standards of the Bureau for Public Health set forth in its Legislative rule entitled Water Well Regulations, 64 C.S.R. 19. Operator is to contact the Bureau of Public Health regarding permit requirements. In lieu of plugging, the operator may transfer the well to the surface owner upon agreement of the parties. All drinking water wells within fifteen hundred feet of the water supply well shall be flow tested by the operator upon request of the drinking well owner prior to operating the water supply well.
- 6. Pursuant to the requirements pertaining to the sampling of domestic water supply wells/springs the operator shall, no later than thirty (30) days after receipt of analytical data provide a written copy to the Chief and any of the users who may have requested such analyses.
- 7. If any explosion or other accident causing loss of life or serious personal injury occurs in or about a well or well work on a well, the well operator or its contractor shall give notice, stating the particulars of the explosion or accident, to the oil and gas inspector and the Chief, within 24 hours of said accident.
- 8. During the casing and cementing process, in the event cement does not return to the surface, the oil and gas inspector shall be notified within 24 hours.
- 9. Operator shall provide the Office of Oil & Gas notification of the date that drilling commenced on this well. Such notice shall be provided by sending an email to DEPOOGNotify@wv.gov within 30 days of commencement of drilling.



west virginia department of environmental protection

WVDEP Office of Oil and Gas 601 57th Street Southeast; Charleston, WV (304) 926-0450 Earl Ray Tomblin, Governor Randy C. Huffman, Cabinet Secretary dep.wv.gov

May 28, 2015

Eric Bernhardt 151 Chipps Run West Union, WV 26456

Re: Permits for Antero Resources Corporation Nova Unit 1H and 2H, Grape Unit 1H and 2H API numbers: 17-06724, 17-06725, 17-06726 and 17-06727

Mr. Bernhardt:

The Office of Oil and Gas (OOG) has reviewed your comments concerning Antero Resources Corporation's permits for the above referenced well. The comment was sent to the operator for its response. The operator has responded and the response is enclosed for your records.

After considering your comments, the applicant's response, and the inspector's findings, the OOG has determined that the application meets the requirements set forth in Article 6A Chapter 22 of the West Virginia Code and Legislative Rule Title 35 Series 8. Consequently, the OOG is issuing the permit today. For your information and convenience, I am including with this letter a copy of the permit as issued.

As you may know, surface owners are entitled to compensation for damages to their property resulting from oil and gas drilling activity. Absent an agreement by the parties, such damage compensation may be addressed pursuant to Article 7, Chapter 22 of the West Virginia Code.

Please contact me at (304) 926-0499, if you have any questions.

Sincerely,

Kelly Kees, PE

WV DEP Office of Oil and Gas

Permitting Section

April 2, 2015



Antero Resources 1615 Wynkoop Street Denver, CO 80202 Office 303.357.7310 Fax 303.357.7315

West Virginia Department of Environmental Protection Chief, Office of Oil and Gas Attn: Mr. James Martin 601 57th Street SE Charleston, WV 25304

RE: Response to Public Comments

Nova Unit 1H (API# 47-017-06726) Nova Unit 2H (API# 47-017-06727) Grape Unit 1H (API# 47-017-06724) Grape Unit 2H (API# 47-017-06725)

Doddridge County/Central District, West Virginia

Mr. Martin:

This letter provides Antero Resources Corporation ("Antero") response to the December 30, 2014 letter sent to the West Virginia Department of Environmental Protection Office of Oil & Gas ("DEP") by Eric Bernhardt.

Attached you will find a map reflecting where we believe Mr. Bernhardt's residence to be located. The four Nova Unit and Grape Unit wells Mr. Bernhardt submitted comments on to the DEP are proposed to be drilled on the already constructed Cofor pad. Based on where we believe Mr. Bernhardt to live, it appears he is almost three miles from the surface location of the four subject wells and the property line of his farm would thus not be within 100 feet of the wells as he suggested. The access road to the pad runs to the southwest from the Cofor pad and neither would it approach Mr. Bernhardt's property or residence. As such, we do not believe Antero's operations will have any of the impacts to Mr. Bernhardt and his property that have been indicated in his comments.

In addition, the four Nova Unit and Grape Unit permit applications that were submitted to the DEP have complied with and meet all regulatory requirements as outlined in West Virginia Code Chapter 22, Article 6A and the Code of State Rules Title 35, Series 8. By copy of this response to the DEP, we therefore request that the DEP proceed with permitting the subject wells having given consideration to Mr. Bernhardt's comments.

Best regards,


Ashlie Steele

Permitting Supervisor

Antero Resources Corporation

Ishlie Steelo

Eric Bernhardt Residence

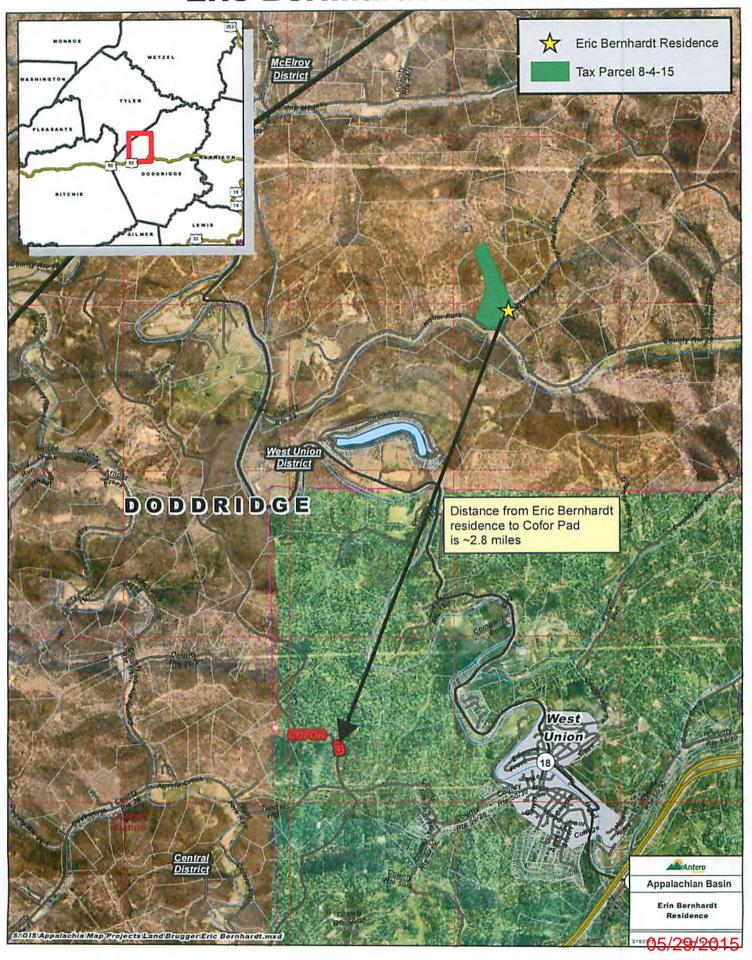

WW-6B (9/13)

STATE OF WEST VIRGINIA DEPARTMENT OF ENVIRONMENTAL PROTECTION, OFFICE OF OIL AND GAS WELL WORK PERMIT APPLICATION

1) Well Opera	tor: Antero R	Resources Corporation	494488557	017-Doddridge	West Union	West Union 7.5'
			Operator ID	County	District	Quadrangle
2) Operator's	Well Number	Nova Unit 2H	Well Pac	d Name: Cofor	Pad	
3) Farm Name	/Surface Owr	ner: Coastal Forest Resources	Company Public Roa	d Access: CR	11/8	
4) Elevation, c 5) Well Type	(a) Gas Other	i: 1189' El	evation, proposed Unde	post-construction post-construction post-construction post-construction	100	
	(b)If Gas	Shallow Horizontal	Deep	-		2.26
6) Existing Pac	d: Yes or No	Yes				3-2
		on(s), Depth(s), Anticipated Thickness	Carry Control and the A. William Control			
8) Proposed To	otal Vertical I	Depth: _7900' TVD				
9) Formation a	t Total Vertic	cal Depth: Marcellus S	Shale			
10) Proposed 7	Total Measure	ed Depth: 19,000' MD				
11) Proposed F	Horizontal Leg	g Length: 9924'				
12) Approxima	ate Fresh Wat	er Strata Depths:	120'			
		resh Water Depths: _C Depths: _764'	Outback Unit 1H (AP	l# 47-17-06518) c	n same pad	
15) Approxima	ate Coal Seam	Depths: 853'				
16) Approxima	nte Depth to P	ossible Void (coal min	ne, karst, other):	None anticipated		
		ntion contain coal sean nt to an active mine?	Yes	No	/	
(a) If Yes, pro	ovide Mine In	ifo: Name:				
		Depth:				
		Seam:		1200	eived	
		Owner:		Office O	EOIL & C	inc.
				Office of MAR	27 7015	

18)

CASING AND TUBING PROGRAM

TYPE	Size	New or Used	Grade	Weight per ft. (lb/ft)	FOOTAGE: For Drilling	INTERVALS: Left in Well	CEMENT: Fill-up (Cu. Ft.)
Conductor	20"	New	H-40	94#	40'	40'	CTS, 38 Cu. Ft.
Fresh Water	13-3/8"	New	J-55/H-40	54.5#/ 48#	300'	300'	CTS, 417 Cu. Ft
Coal	9-5/8*	New	J-55	36#	2440'	2440'	CTS, 993 Cu. Ft.
Intermediate							
Production	5-1/2"	New	P-110	20#	19000'	19000'	4835 Cu. Ft.
Tubing	2-3/8"	New	N-80	4.7#		7100'	
Liners					-		

3-26 2015

TYPE	Size	Wellbore Diameter	Wall Thickness	Burst Pressure	Cement Type	Cement Yield (cu. ft./k)
Conductor	20"	24"	0.438"	1530	Class A	1.18
Fresh Water	13-3/8"	17-1/2"	0.38"/0.33"	2730/1730	Class A	1.18
Coal	9-5/8"	12-1/4"	0.352"	3520	Class A	1.18
Intermediate						
Production	5-1/2"	8-3/4" & 8-1/2"	0.361"	12630	Lead-H/POZ & Tail - H	H/POZ-1.44 & H-1.8
Tubing	2-3/8"	4.778"	0.19"	11200		
Liners						

PACKERS

Kind:	N/A	
Sizes:	N/A	
Depths Set:	N/A	Received Gar
		Office of Citi & Gar MAR 27 2015

Page 2 of 3

RECEIVED Office of Oil and Gas

WW-6B (9/13) MAY 23 2015

WV Department of Environmental Protection

19) Describe proposed well work, including the drilling and plugging back of any pilot hole:

rill, perforate, fracture	a new horizontal shallow	well and complete Ma	rcellus Shale.	

20) Describe fracturing/stimulating methods in detail, including anticipated max pressure and max rate:

Antero plans to pump Slickwater into the Marcellus Shale formation in order to ready the well for production. The fluid will be comprised of approximately 99 percent water and sand, with less than 1 percent special-purpose additives as shown in the attached "List of Anticipated Additives Used for Fracturing or Stimulating Well."

Anticipated Max Pressure - 9300 lbs Anticipated Max Rate - 80 bpm

- 21) Total Area to be disturbed, including roads, stockpile area, pits, etc., (acres): 50.15 existing acres
- 22) Area to be disturbed for well pad only, less access road (acres): 3.70 acres

23) Describe centralizer placement for each casing string:

Conductor: no centralizers

Surface Casing: one centralizer 10' above the float shoe, one on the insert float collar and one every 4th joint spaced up the hole to surface.

Intermediate Casing: one centralizer above float joint, one centralizer 5' above float collar and one every 4th collar to surface.

Production Casing: one centralizer at shoe joint and one every 3 joints to top of cement in intermediate casing.

24) Describe all cement additives associated with each cement type:

Conductor: no additives, Class A cement.

Surface: Class A cement with 2-3% calcium chloride and 1/4 lb flake Intermediate: Class A cement with 1/4 lb of flake, 5 gallons of clay treat

Production: Lead cement- 50/50 Class H/Poz + 1.5% salt + 1% C-45 + 0.5% C-16a + 0.2% C-12 + 0.45% C-20 + 0.05% C-51
Production: Tail cement- Class H + 45 PPS Calcium Carbonate + 1.0% FL-160 + 0.2% ACGB-47 + 0.05% ACSA-51 + 0.2% ACR-20

25) Proposed borehole conditioning procedures:

Conductor: blowhole clean with air, run casing, 10 bbls fresh water.

Surface: blowhole clean with air, trip to conductor shoe, trip to bottom, blowhole clean with air, trip out, run casing, circulate pipe capacity + 40 bbls fresh water followed by 25 bbls bentonite mud, 10 bbls fresh water spacer.

Intermediate: blowhole clean with air, trip to surface casing shoe, trip to bottom, blowhole clean with air, trip out, run casing, circulate 40 bbls brine water followed by 10 bbls fresh water and 25 bbls bentonite mud, pump 10 bbls fresh water.

Production: circulate with 14 lb/gal NaCl mud, trip to middle of lateral, circulate, pump high viscosity sweep, trip to base of curve, pump high viscosity sweep, trip to top of curve, trip to bottom, circulate, pump high viscosity sweep, trip out, run casing, circulate 10 bbls fresh water, pump 48 bbls barite pill, pump 10 bbls fresh water followed by 48 bbls mud flush and 10 bbls water.

^{*}Note: Attach additional sheets as needed.

API Number 47 - 017

Operator's Well No. Nova Unit 2H

STATE OF WEST VIRGINIA DEPARTMENT OF ENVIRONMENTAL PROTECTION OFFICE OF OIL AND GAS

Watershed (HUC 10) Hoodwaters Middle Island Creek Quadrangle West Union 7.5: Do you anticipate using more than 5,000 bils of water to complete the proposed well work? Yes V No Will a pit be used? Yes No No Will a pit be used? Yes No No Will a synthetic liner be used in the pit? Yes No No Will a synthetic liner be used in the pit? Yes No No Will a synthetic liner be used in the pit? Yes No No Will a synthetic liner be used in the pit? Yes No No Will a synthetic liner be used in the pit? Yes No No Will a synthetic liner be used in the pit? Yes No No Will a synthetic liner be used in the pit? Yes No No Will a synthetic liner be used in the pit? Yes No Will a synthetic liner be used in the pit? Yes No Will a synthetic liner be used in the pit? Yes No Will a synthetic liner be used in the pit? Yes No Will a synthetic liner be used in the pit? Yes No Will a synthetic liner be used in the pit? Yes No Will a synthetic liner be used? If so, describe: Yes Off Site Disposal (Supply form WW-9 for disposal location) (Meadowfill Landfill Permit #SWE-1032-98) Other (Explain Yes Will and plan the provided for this well (vertical and horizontal)? Air, freshwater, oil based, etc. Sometime of the pit of	FLUIDS/ CUTTINGS DISPOSAL	& RECLAMATION PLAN
Do you anticipate using more than 5,000 bbls of water to complete the proposed well work? Yes No If so, please describe anticipated pit waste: Will a pit be used? Yes No If so, please describe anticipated pit waste: Will a synthetic liner be used in the pit? Yes No If so, what ml.? N/A Proposed Disposal Method For Treated Pit Wastes: Land Application Underground Injection (UIC Permit Number Reuse (at API Number Future permitted well to actions) when applicable. APIF will be provided on Form Wif-34 Off Site Disposal (Supply form WW-9 for disposal location) (Meadowfill Landfill Permit #SWF-1032-98) Will closed loop system be used? If so, describe: Yes Prilling medium anticipated for this well (vertical and horizontal)? Air, freshwater, oil based, etc. **Modifies to be used in drilling medium? Please See Attachment Drill cuttings disposal method? Leave in pit, landfill, removed offsite, etc. **If left in pit and plan to solidify what medium will be used? (cement, lime, sawdust) N/A **Landfill or offsite name/permit number? Meadowfill Landfa (Permit #SWF-1032-98) **Permittee shall provide written notice to the Office of Oil and Gas of any load of drill cuttings or associated waste rejected at any Vest Virginia solid waste facility. The notice shall be provided within 24 hours of rejection and the permittee shall also disclose here it was properly disposed. **Terrify that I understand and agree to the terms and conditions of the GENERAL WATER POLLUTION PERMIT issued to August 1, 2005, by the Office of Oil and Gas of the West Virginia Department of Environmental Protection. I understand that the rovisions of the permit are enforceable by law. Violations of any term or condition of the general permit and/or other applicable rovisions of the permit are enforceable by law. Violations of any term or condition of the general permit and/or other applicable for braining the information, I believe that the information is true, accurate, and complete. I am aware that there are significant or many and official	Operator Name Antero Resources Corporation	OP Code 494488557
Will a synthetic liner be used in the pit? Yes No If so, please describe anticipated pit waste: Will a synthetic liner be used in the pit? Yes No If so, what ml.? N/A Proposed Disposal Method For Treated Pit Wastes: Land Application Underground Injection (UIC Permit Number B. Reuse (at API Number Future permitted well bootstores when applicable. APPli well be provided on Form Wit-34 B. Off Site Disposal (Supply form WW-9 for disposal location) (Meadowfill Landfill Permit #SWF-1032-98) Other (Explain -If oil based, what type? Synthetic, petroleum, etc. N/A Additives to be used in drilling medium? Pages See Attachment Drill cuttings disposal method? Leave in pit, landfill, removed offsite, etc. Stored in tanks, removed offsite and taken to landfill. -If left in pit and plan to solidify what medium will be used? (cement, lime, sawdust) N/A -Landfill or offsite name/permit number? Meadowfill Landfill (Permit #SWF-1032-98) ermittee shall provide written notice to the Office of Oil and Gas of any load of drill cuttings or associated waste rejected at any Vest Virginia solid waste facility. The notice shall be provided within 24 hours of rejection and the permittee shall also disclose there it was properly disposed. I certify that I understand and agree to the terms and conditions of the GENERAL WATER POLLUTION PERMIT issued in August 1, 2005, by the Office of Oil and Gas of any load of drill cuttings or associated waste rejected at any vest Virginia bepartment of Environmental Protection. I understand that the rovisions of the permit are enforceable by law. Violations of any term or condition of the general permit and/or other applicable to or regulation can lead to enforcement action. I certify that I understand and agree to the terms and conditions of any term or condition of the general permit and/or other applicable in ormation, including the possibility of time or imprisonment. Ompany Official (Typed Name) Cole Kilstrom ompany Official (Typed Name) Cole Kilstrom ompany Official (Typed Name) Cole K	Watershed (HUC 10) Headwaters Middle Island Creek	Quadrangle West Union 7.5'
Land Application Underground Injection (UIC Permit Number Underground Injection (UIC Permit Number Reuse (at API Number Future permitted well locations when applicable. APIF will be provided on Form WR-34 Off Site Disposal (Supply form WW-9 for disposal location) (Meadowfill Landfill Permit #SWF-1032-98) Other (Explain Will closed loop system be used? If so, describe: Yes Orilling medium anticipated for this well (vertical and horizontal)? Air, freshwater, oil based, etc.		
Land Application Underground Injection (UIC Permit Number Reuse (at API Number Future permitted well locations when applicable. APIF well be provided on Form WR-34 Off Site Disposal (Supply form WW-9 for disposal location) (Meadewfill Landfill Permit #SWF-1032-98) Other (Explain Will closed loop system be used? If so, describe: Yes Orilling medium anticipated for this well (vertical and horizontal)? Air, freshwater, oil based, etc. For line based, what type? Synthetic, petroleum, etc. NIA Idditives to be used in drilling medium? Floase See Attachment Orill cuttings disposal method? Leave in pit, landfill, removed offsite, etc. Stored in tanks, removed offsite and taken to landfill. Fleft in pit and plan to solidify what medium will be used? (cement, lime, sawdust) NIA Landfill or offsite name/permit number? Meadowfill Landfill (Permit #SWF-1032-98) ermittee shall provide written notice to the Office of Oil and Gas of any load of drill cuttings or associated waste rejected at any Vest Virginia solid waste facility. The notice shall be provided within 24 hours of rejection and the permittee shall also disclose there it was properly disposed. I certify that I understand and agree to the terms and conditions of the GENERAL WATER POLLUTION PERMIT issued in August 1, 2005, by the Office of Oil and Gas of the West Virginia Department of Environmental Protection. I understand that the rovisions of the permit are enforceable by law. Violations of any term or condition of the general permit and/or other applicable wor regulation can lead to enforement action. I certify under penalty of law that I have personally examined and am familiar with the information submitted on this polication form and all attachments thereto and that, based on my inquiry of those individuals immediately responsible for training the information, believe that the information is true, accurate, and complete. I am aware that there are significant matters for submitting false information, including the possibility of fine or imprisonment. Om	If so, please describe anticipated pit waste: No pit will be used at this a	site (Drilling and Flowback Flaids will be stored in lienks. Cuttings will be tanked and hauled off site.
Land Application Underground Injection (UIC Permit Number Russe (at API Number Finare permitted well locations when applicable. API# will be provided on Form WR-34 Off Site Disposal (Supply form WW-9 for disposal location) (Meadowfill Landfill Permit #SWF-1032-98) Other (Explain Will closed loop system be used? If so, describe: Yes rilling medium anticipated for this well (vertical and horizontal)? Air, freshwater, oil based, etc. Froil based, what type? Synthetic, petroleum, etc. N/A dditives to be used in drilling medium? Piease See Attachment rill cuttings disposal method? Leave in pit, landfill, removed offsite, etc. Stored in tanks, removed offsite and taken to landfill. If left in pit and plan to solidify what medium will be used? (cement, lime, sawdust) N/A Landfill or offsite name/permit number? Meadowfill Landfill (Permit #SWF-1032-98) Permittee shall provide written notice to the Office of Oil and Gas of any load of drill cuttings or associated waste rejected at any lest Virginia solid waste facility. The notice shall be provided within 24 hours of rejection and the permittee shall also disclose here it was properly disposed. I certify that I understand and agree to the terms and conditions of the GENERAL WATER POLLUTION PERMIT issued A August 1, 2005, by the Office of Oil and Gas of the West Virginia Department of Environmental Protection. I understand that the ovisions of the permit are enforceable by law. Violations of any term or condition of the general permit and/or other applicable we or regulation can lead to enforcement action. I certify under penalty of law that I have personally examined and am familiar with the information submitted on this plication form and all attachments thereto and that, based on my inquiry of those individuals immediately responsible for training the information, believe that the information is true, accurate, and complete. I am aware that there are significant malties for submitting false information, including the possibility of fine or imprisonment.	Will a synthetic liner be used in the pit? Yes No	If so, what ml.? N/A
Land Application Underground Injection (UIC Permit Number Reuse (at API Number Future permitted well bostions when applicable. APIE will be provided on Form WR-34 Off Site Disposal (Supply form WW-9 for disposal location) (Meadowfill Landfill Permit #SWF-1032-98) Other (Explain Will closed loop system be used? If so, describe: Yes Prilling medium anticipated for this well (vertical and horizontal)? Air, freshwater, oil based, etc. If oil based, what type? Synthetic, petroleum, etc. N/A diditives to be used in drilling medium? Please See Attachment Infill cuttings disposal method? Leave in pit, landfill, removed offsite, etc. Stored in tanks, removed offsite and taken to landfill. If left in pit and plan to solidify what medium will be used? (cement, lime, sawdust) N/A Landfill or offsite name/permit number? Meadowfill Landfill (Permit #SWF-1032-98) ermittee shall provide written notice to the Office of Oil and Gas of any load of drill cuttings or associated waste rejected at any /est Virginia solid waste facility. The notice shall be provided within 24 hours of rejection and the permittee shall also disclose here it was properly disposed. I certify that I understand and agree to the terms and conditions of the GENERAL WATER POLLUTION PERMIT issued to August 1, 2005, by the Office of Oil and Gas of the West Virginia Department of Environmental Protection. I understand that the rovisions of the permit are enforceable by law. Violations of any term or condition of the general permit and/or other applicable we or regulation can lead to enforcement action. I certify under penalty of law that I have personally examined and am familiar with the information submitted on this publication form and all attachments thereto and that, based on my inquiry of those individuals immediately responsible for training the information, believe that the information is true, accurate, and complete. I am aware that there are significant maticies for submitting false information, including the possibility of fine or imprisonm	Proposed Disposal Method For Treated Pit Wastes:	1.18
Jorilling medium anticipated for this well (vertical and horizontal)? Air, freshwater, oil based, etc. Jorill based, what type? Synthetic, petroleum, etc. NA Additives to be used in drilling medium? Please See Attachment Jorill cuttings disposal method? Leave in pit, landfill, removed offsite, etc. Stored in tanks, removed offsite and taken to landfill. If left in pit and plan to solidify what medium will be used? (cement, lime, sawdust) N/A Landfill or offsite name/permit number? Meadowfill Landfill (Permit #SWF-1032-98) Jermittee shall provide written notice to the Office of Oil and Gas of any load of drill cuttings or associated waste rejected at any leave to the view of the provided within 24 hours of rejection and the permittee shall also disclose here it was properly disposed. Jertify that I understand and agree to the terms and conditions of the GENERAL WATER POLLUTION PERMIT issued in August 1, 2005, by the Office of Oil and Gas of the West Virginia Department of Environmental Protection. I understand that the roots of the permit are enforceable by law. Violations of any term or condition of the general permit and/or other applicable were or regulation can lead to enforcement action. Jertify under penalty of law that I have personally examined and am familiar with the information submitted on this optication form and all attachments thereto and that, based on my inquiry of those individuals immediately responsible for potatining the information, including the possibility of fine or imprisonment. Jornand Official Title Environmental & Regulatory Manager	Underground Injection (UIC Permit Numb Reuse (at API Number Future permitted well loc Off Site Disposal (Supply form WW-9 for	ober
-If oil based, what type? Synthetic, petroleum, etc. N/A Idditives to be used in drilling medium? Please See Attachment orill cuttings disposal method? Leave in pit, landfill, removed offsite, etc. Stored in tanks, removed offsite and taken to landfill. -If left in pit and plan to solidify what medium will be used? (cement, lime, sawdust) N/A -Landfill or offsite name/permit number? Meadowfill Landfill (Permit #SWF-1032-98) ermittee shall provide written notice to the Office of Oil and Gas of any load of drill cuttings or associated waste rejected at any Vest Virginia solid waste facility. The notice shall be provided within 24 hours of rejection and the permittee shall also disclose there it was properly disposed. I certify that I understand and agree to the terms and conditions of the GENERAL WATER POLLUTION PERMIT issued in August 1, 2005, by the Office of Oil and Gas of the West Virginia Department of Environmental Protection. I understand that the rovisions of the permit are enforceable by law. Violations of any term or condition of the general permit and/or other applicable wor regulation can lead to enforcement action. I certify under penalty of law that I have personally examined and am familiar with the information submitted on this optication form and all attachments thereto and that, based on my inquiry of those individuals immediately responsible for tealing the information, including the possibility of time or imprisonment. ompany Official Title Environmental & Regulatory Manager Notary Public Notary Public	Will closed loop system be used? If so, describe: Yes	
Additives to be used in drilling medium? Please See Attachment Prill cuttings disposal method? Leave in pit, landfill, removed offsite, etc. Stored in tanks, removed offsite and taken to landfill. -If left in pit and plan to solidify what medium will be used? (cement, lime, sawdust) N/A -Landfill or offsite name/permit number? Meadowfill Landfill (Permit #SWF-1032-98) ermittee shall provide written notice to the Office of Oil and Gas of any load of drill cuttings or associated waste rejected at any Vest Virginia solid waste facility. The notice shall be provided within 24 hours of rejection and the permittee shall also disclose there it was properly disposed. I certify that I understand and agree to the terms and conditions of the GENERAL WATER POLLUTION PERMIT issued in August 1, 2005, by the Office of Oil and Gas of the West Virginia Department of Environmental Protection. I understand that the rovisions of the permit are enforceable by law. Violations of any term or condition of the general permit and/or other applicable to or regulation can lead to enforcement action. I certify under penalty of law that I have personally examined and am familiar with the information submitted on this opticalion form and all attachments thereto and that, based on my inquiry of those individuals immediately responsible for obtaining the information, I believe that the information is true, accurate, and complete. I am aware that there are significant enalties for submitting false information, including the possibility of fine or imprisonment. Ompany Official Title Environmental & Regulatory Manager Management of the Cole Kilstrom Ompany Official Title Environmental & Regulatory Manager Management of the Cole Kilstrom Ompany Official Title Environmental & Regulatory Manager Notary Public	Orilling medium anticipated for this well (vertical and horizontal)? A	Air, freshwater, oil based, etc. Dut/Freshwater, indermediate -
orill cuttings disposal method? Leave in pit, landfill, removed offsite, etc. Stored in tanks, removed offsite and taken to landfill. -If left in pit and plan to solidify what medium will be used? (cement, lime, sawdust) N/A -Landfill or offsite name/permit number? Meadowfill Landfill (Permit #SWF-1032-98) ermittee shall provide written notice to the Office of Oil and Gas of any load of drill cuttings or associated waste rejected at any lest Virginia solid waste facility. The notice shall be provided within 24 hours of rejection and the permittee shall also disclose here it was properly disposed. I certify that I understand and agree to the terms and conditions of the GENERAL WATER POLLUTION PERMIT issued in August 1, 2005, by the Office of Oil and Gas of the West Virginia Department of Environmental Protection. I understand that the rovisions of the permit are enforceable by law. Violations of any term or condition of the general permit and/or other applicable were or regulation can lead to enforcement action. I certify under penalty of law that I have personally examined and am familiar with the information submitted on this optication form and all attachments thereto and that, based on my inquiry of those individuals immediately responsible for tataining the information, I believe that the information is true, accurate, and complete. I am aware that there are significant emaltics for submitting false information, including the possibility of fine or imprisonment. The provision of the general permit and/or other applicable or provision form and all attachments thereto and that, based on my inquiry of those individuals immediately responsible for translities for submitting false information, including the possibility of fine or imprisonment. The provision of the general permit and/or other applicable or imprisonment. The provision of the general permit and/or other applicable or other applicable. I am aware that there are significant treadily of the or imprisonment. The provision of the permit and/o	-If oil based, what type? Synthetic, petroleum, etc. N/A	
orill cuttings disposal method? Leave in pit, landfill, removed offsite, etc. Stored in tanks, removed offsite and taken to landfill. -If left in pit and plan to solidify what medium will be used? (cement, lime, sawdust) N/A -Landfill or offsite name/permit number? Meadowfill Landfill (Permit #SWF-1032-98) ermittee shall provide written notice to the Office of Oil and Gas of any load of drill cuttings or associated waste rejected at any lest Virginia solid waste facility. The notice shall be provided within 24 hours of rejection and the permittee shall also disclose here it was properly disposed. I certify that I understand and agree to the terms and conditions of the GENERAL WATER POLLUTION PERMIT issued in August 1, 2005, by the Office of Oil and Gas of the West Virginia Department of Environmental Protection. I understand that the rovisions of the permit are enforceable by law. Violations of any term or condition of the general permit and/or other applicable were or regulation can lead to enforcement action. I certify under penalty of law that I have personally examined and am familiar with the information submitted on this optication form and all attachments thereto and that, based on my inquiry of those individuals immediately responsible for tataining the information, I believe that the information is true, accurate, and complete. I am aware that there are significant emaltics for submitting false information, including the possibility of fine or imprisonment. The provision of the general permit and/or other applicable or provision form and all attachments thereto and that, based on my inquiry of those individuals immediately responsible for translities for submitting false information, including the possibility of fine or imprisonment. The provision of the general permit and/or other applicable or imprisonment. The provision of the general permit and/or other applicable or other applicable. I am aware that there are significant treadily of the or imprisonment. The provision of the permit and/o	additives to be used in drilling medium? Please See Attachment	
-If left in pit and plan to solidify what medium will be used? (cement, lime, sawdust) N/A -Landfill or offsite name/permit number? Meadowfill Landfill (Permit #SWF-1032-98) ermittee shall provide written notice to the Office of Oil and Gas of any load of drill cuttings or associated waste rejected at any West Virginia solid waste facility. The notice shall be provided within 24 hours of rejection and the permittee shall also disclose where it was properly disposed. I certify that I understand and agree to the terms and conditions of the GENERAL WATER POLLUTION PERMIT issued in August 1, 2005, by the Office of Oil and Gas of the West Virginia Department of Environmental Protection. I understand that the revisions of the permit are enforceable by law. Violations of any term or condition of the general permit and/or other applicable was or regulation can lead to enforcement action. I certify under penalty of law that I have personally examined and am familiar with the information submitted on this optication form and all attachments thereto and that, based on my inquiry of those individuals immediately responsible for tetalning the information, I believe that the information is true, accurate, and complete. I am aware that there are significant emalties for submitting false information, including the possibility of fine or imprisonment. The provided waste rejected at any waste rejec		etc. Stored in tanks, removed offsite and taken to landfill.
-Landfill or offsite name/permit number? Meadowfill Landfill (Permit #SWF-1032-98) dermittee shall provide written notice to the Office of Oil and Gas of any load of drill cuttings or associated waste rejected at any West Virginia solid waste facility. The notice shall be provided within 24 hours of rejection and the permittee shall also disclose where it was properly disposed. I certify that I understand and agree to the terms and conditions of the GENERAL WATER POLLUTION PERMIT issued in August 1, 2005, by the Office of Oil and Gas of the West Virginia Department of Environmental Protection. I understand that the revisions of the permit are enforceable by law. Violations of any term or condition of the general permit and/or other applicable two or regulation can lead to enforcement action. I certify under penalty of law that I have personally examined and am familiar with the information submitted on this optication form and all attachments thereto and that, based on my inquiry of those individuals immediately responsible for obtaining the information, I believe that the information is true, accurate, and complete. I am aware that there are significant company Official Signature Ompany Official Signature Ompany Official Signature Ompany Official Title Environmental & Regulatory Manager Notary Public Notary Public Notary Public		
Permittee shall provide written notice to the Office of Oil and Gas of any load of drill cuttings or associated waste rejected at any West Virginia solid waste facility. The notice shall be provided within 24 hours of rejection and the permittee shall also disclose where it was properly disposed. I certify that I understand and agree to the terms and conditions of the GENERAL WATER POLLUTION PERMIT issued in August 1, 2005, by the Office of Oil and Gas of the West Virginia Department of Environmental Protection. I understand that the revisions of the permit are enforceable by law. Violations of any term or condition of the general permit and/or other applicable two or regulation can lead to enforcement action. I certify under penalty of law that I have personally examined and am familiar with the information submitted on this optication form and all attachments thereto and that, based on my inquiry of those individuals immediately responsible for obtaining the information, I believe that the information is true, accurate, and complete. I am aware that there are significant containing the information, including the possibility of fine or imprisonment. Sompany Official Signature The provided within 24 hours of rejection and the permittee shall also disclose the description of the general permit and/or other applicable to the general		
Vest Virginia solid waste facility. The notice shall be provided within 24 hours of rejection and the permittee shall also disclose where it was properly disposed. I certify that I understand and agree to the terms and conditions of the GENERAL WATER POLLUTION PERMIT issued in August 1, 2005, by the Office of Oil and Gas of the West Virginia Department of Environmental Protection. I understand that the revisions of the permit are enforceable by law. Violations of any term or condition of the general permit and/or other applicable to or regulation can lead to enforcement action. I certify under penalty of law that I have personally examined and am familiar with the information submitted on this optication form and all attachments thereto and that, based on my inquiry of those individuals immediately responsible for braining the information, I believe that the information is true, accurate, and complete. I am aware that there are significant enalties for submitting false information, including the possibility of fine or imprisonment. Sompany Official Signature The province of the west Virginia Department of Environmental & Regulatory Manager Montary Public Notary Public West Virginia Protection. I understand that the revisions of the GENERAL WATER POLLUTION PERMIT issued in the province of the GENERAL WATER POLLUTION PERMIT issued in the province of the general permit and/or other applicable to the provisions of the GENERAL WATER POLLUTION PERMIT issued in the provision of the GENERAL WATER POLLUTION PERMIT issued in the provision of the general permit and/or other applicable to the provision of the general permit and/or other applicable to the provision of the general permit and/or other applicable to the provision of the general permit and/or other applicable to the provision of the general permit and/or other applicable to the provision of the general permit and/or other applicable to the provision of the general permit and/or other applicable to the provision of the general permit and/or other applicab	-Landing of offsite name/permit number?	1 OHIA 7077 -1002-30)
n August 1, 2005, by the Office of Oil and Gas of the West Virginia Department of Environmental Protection. I understand that the revisions of the permit are enforceable by law. Violations of any term or condition of the general permit and/or other applicable and or regulation can lead to enforcement action. I certify under penalty of law that I have personally examined and am familiar with the information submitted on this opplication form and all attachments thereto and that, based on my inquiry of those individuals immediately responsible for obtaining the information, I believe that the information is true, accurate, and complete. I am aware that there are significant enalties for submitting false information, including the possibility of fine or imprisonment. Sompany Official Signature The province of the West Virginia Department of Environmental & Regulatory Manager The province of the general permit and/or other applicable and am familiar with the information submitted on this policial in the information submitted on this province of the general permit and/or other applicable and submitted on this province of the general permit and/or other applicable and submitted on this province of the general permit and/or other applicable and submitted on this province of the general permit and/or other applicable and submitted on this province of the general permit and/or other applicable and submitted on this province of the general permit and/or other applicable and submitted on this province of the general permit and/or other applicable and submitted on this province of the general permit and/or other applicable and submitted on this province of the general permit and/or other applicable on the general permit and/or other applicable on this province of the general permit and/or other applicable on this province of the general permit and/or other applicable on this province of the general permit and/or other applicable on this province of the general permit and/or other applicable on the general permit and/or	Permittee shall provide written notice to the Office of Oil and Gas of a West Virginia solid waste facility. The notice shall be provided within where it was properly disposed.	any load of drill cuttings or associated waste rejected at any 124 hours of rejection and the permittee shall also disclose
ompany Official (Typed Name) Cole Kilstrom ompany Official Title Environmental & Regulatory Manager ubscribed and sworn before me this day of MOVM , 20 15 Notary Public Offic 2018	on August 1, 2005, by the Office of Oil and Gas of the West Virginia I provisions of the permit are enforceable by law. Violations of any to aw or regulation can lead to enforcement action. I certify under penalty of law that I have personally examinable polication form and all attachments thereto and that, based on multiple between the information is true, acceptable for submitting false information, including the possibility of the possibility	Department of Environmental Protection. I understand that the term or condition of the general permit and/or other applicable sined and am familiar with the information submitted on this my inquiry of those individuals immediately responsible for ecurate, and complete. I am aware that there are significant fine or imprisonment.
ubscribed and sworn before me this 6 day of MAVM , 20 15 Notary Public Office and Sworn Defore me this 6 day of MAVM , 20 15		KARA
ubscribed and sworn before me this 6 day of MAVM , 20 15 Notary Public Office and Sworn Defore me this 6 day of MAVM , 20 15	Company Official Title Environmental & Regulatory Manager	MY COMMISSIVID COUBLISH
Notary Public Office Of		UM , 20 15 CEPIRES JULY SOCIETY OF
v commission expires TMIN 21, 2018	MAN AMMANA	Notary Public Office 2018
	ly commission expires TMIM 21, 2018	MAR 27 2015

Antero Resources Corporation

2.2		existing acres Prevegetation p	.,
Lime 2-3	Tons/acre or to correct to pl	Н 6.5	
Fertilizer type Hay or s	straw or Wood Fiber (will be used	where needed)	
Fertilizer amount 500)	lbs/acre	
Mulch 2-3	Tons	/acre	
Access Roads (24.12) + Sta Excess/Topsoil Material Sto	aging Areas (1,39) + Rock Run W ockpiles (11,86) = 50.15 Existing	'ell Pad (6.81) + Cofor Well Pad (3.70) + Acres	Water Containment Pad (2.27
Temp	porary	Perm	anent
Seed Type	lbs/acre	Seed Type	lbs/acre
Annual Ryegrass	40	Crownvetch	10-15
*See attached Table 3 for additional seed	type (Cofor Pad Design Page 19)	*See attached Table 4a for additional see	d type (Cofor Pad Design Page 19)
*or type of grass seed reque	ested by surface owner	*or type of grass seed requ	ested by surface owner
*No Fescue or Timoth	ny Grass shall be use	d	
provided) Photocopied section of involved	d 7.5' topographic sheet.		cluding this info have been
provided) Photocopied section of involved	d 7.5' topographic sheet.		
provided) Photocopied section of involved	d 7.5' topographic sheet.	estarbed areas	
provided) Photocopied section of involved	d 7.5' topographic sheet.		
provided) Photocopied section of involved	d 7.5' topographic sheet.		
Photocopied section of involved Plan Approved by: Bangarange Comments: 5 and and Eth To W.	en A surface Motoh any dispersions	istorbed areas	Maintain
Photocopied section of involved Photocopied section of involved Plan Approved by: Banga Comments: Send a Eth to we have the section of involved Plan Approved by: Banga Plan A	las A surfamotoh any di Dep. regulations	Date: 3-26-20/3	Maintain
Photocopied section of involved Plan Approved by: Bangarange Comments: 5 and a Comme	en A surface Motoh any dispersions	istorbed areas	Maintain

MAR 27 2015

Form WW-9 Additives Attachment

SURFACE INTERVAL

- 1. Fresh Water
- 2. Soap -Foamer AC
- 3. Air

INTERMEDIATE INTERVAL

STIFF FOAM RECIPE:

- 1) 1 ppb Soda Ash / Sodium Carbonate-Alkalinity Control Agent
- 2) 1 ppb Conqor 404 (11.76 ppg) / Corrosion Inhibitor
- 3) 4 ppb KLA-Gard (9.17 ppg) / Amine Acid Complex-Shale Stabilizer
- 4) 1ppb Mil Pac R / Sodium Carboxymethylcellulose-Filtration Control Agent
- 5) 12 ppb KCL / Potassium Chloride-inorganic Salt
- 6) Fresh Water 80 bbls
- 7) Air

PRODUCTION INTERVAL

1. Alpha 1655

Salt Inhibitor

2. Mil-Carb

Calcium Carbonate

3. Cottonseed Hulls

Cellulose-Cottonseed Pellets - LCM

4. Mil-Seal

Vegetable, Cotton & Cellulose-Based Fiber Blend - LCM

5. Clay-Trol

Amine Acid Complex - Shale Stabilizer

6. Xan-Plex

Viscosifier For Water Based Muds

7. Mil-Pac (All Grades)

Sodium Carboxymethylcellulose - Filtration Control Agent

8. New Drill

Anionic Polyacrylamide Copolymer Emulsion - Shale Stabilizer

9. Caustic Soda

Sodium Hydroxide – Alkalinity Control

10. Mil-Lime

Calcium Hydroxide – Lime

11. LD-9

Polyether Polyol – Drilling Fluid Defoamer

12. Mil Mica

Hydro-Biotite Mica – LCM

RECEIVED
Office of Oil and Gas

MAR 1 7 2015

WV Department of Environmental Protection 2015

13. Escaid 110

Drilling Fluild Solvent - Aliphatic Hydrocarbon

14. Ligco

Highly Oxidized Leonardite - Filteration Control Agent

15. Super Sweep

Polypropylene - Hole Cleaning Agent

16. Sulfatrol K

Drilling Fluid Additive - Sulfonated Asphalt Residuum

17. Sodium Chloride, Anhydrous

Inorganic Salt

18. D-D

Drilling Detergent - Surfactant

19. Terra-Rate

Organic Surfactant Blend

20. W.O. Defoam

Alcohol-Based Defoamer

21. Perma-Lose HT

Fluid Loss Reducer For Water-Based Muds

22. Xan-Plex D

Polysaccharide Polymer – Drilling Fluid Viscosifier

23. Walnut Shells

Ground Cellulosic Material - Ground Walnut Shells - LCM

24. Mil-Graphite

Natural Graphite – LCM

25. Mil Bar

Barite - Weighting Agent

26. X-Cide 102

Biocide

27. Soda Ash

Sodium Carbonate - Alkalinity Control Agent

28. Clay Trol

Amine Acid complex - Shale Stabilizer

29. Sulfatrol

Sulfonated Asphalt – Shale Control Additive

30. Xanvis

Viscosifier For Water-Based Muds

31. Milstarch

Starch – Fluid Loss Reducer For Water Based Muds

32. Mil-Lube

Drilling Fluid Lubricant

RECEIVED
Office of Oil and Gas

MAR 1 7 2015

WV Department of Environmental Protection 29/2015



911 ADDRESS 770 Tunnel Hill Rd. West Union, WV 26456

Well Site Safety Plan Antero Resources

Well Name: Outback Unit 1H, Outback Unit 2H, Morton Unit

1H, Morton Unit 2H, Nova Unit 1H, Nova Unit 2H, Grape Unit 1H, Grape Unit 2H, Rainer Unit

1H, and Rainer Unit 2H

Pad Location: COFOR PAD

Doddridge County/ West Union District

GPS Coordinates: Lat 39°17′57.92"/Long -80°48′0.20" (NAD83)

Driving Directions:


From West Union, WV

Drive west on HWY 50 W 2.6 miles. Turn Right onto US-50 West 2.6 miles. Turn Right onto Co Rte 11/Arnolds Creek Rd 1.4 miles. Turn Right onto Tunnel Hill Rd 0.75 miles. Turn Left onto access road. Look for rig signs.

EMERGENCY (24 HOUR) CONTACT 1-800-878-1373

DCN 3-26-2015

Office of Oil & Gas MAR 27 2015

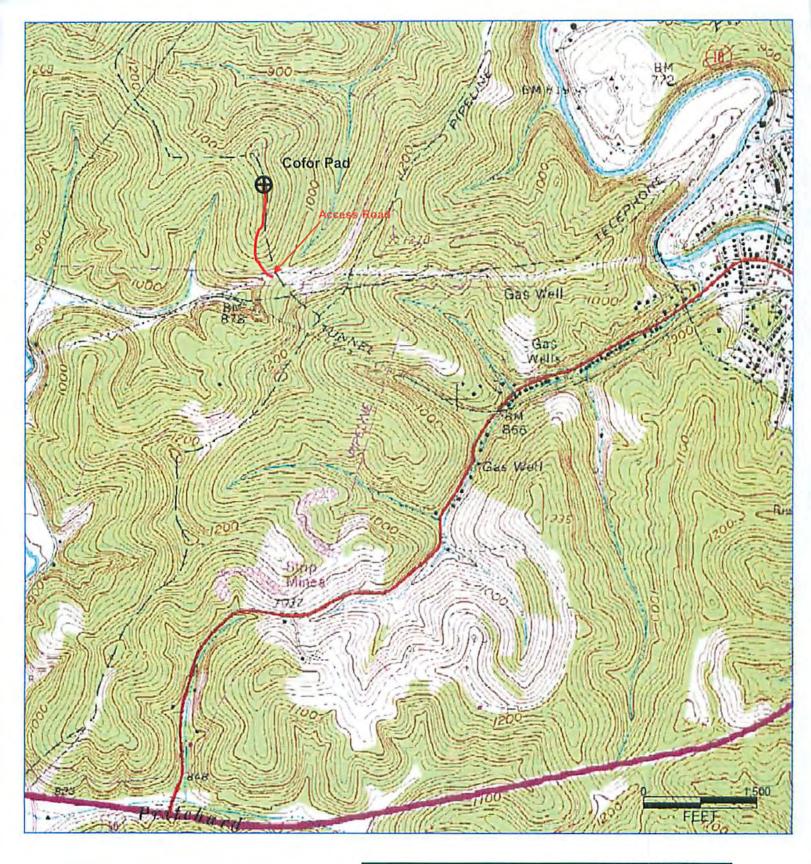


Antero Resources Corporationas Appalachian Basin Nova Unit 2HMAR 1 7 2015

Doddridge County epartment of Quadrangle: West Union 7.5' Environmental Protection Watershed: Headwaters Middle Island Creek

05/29/2015 District: West Union

Date: 4-01-2014

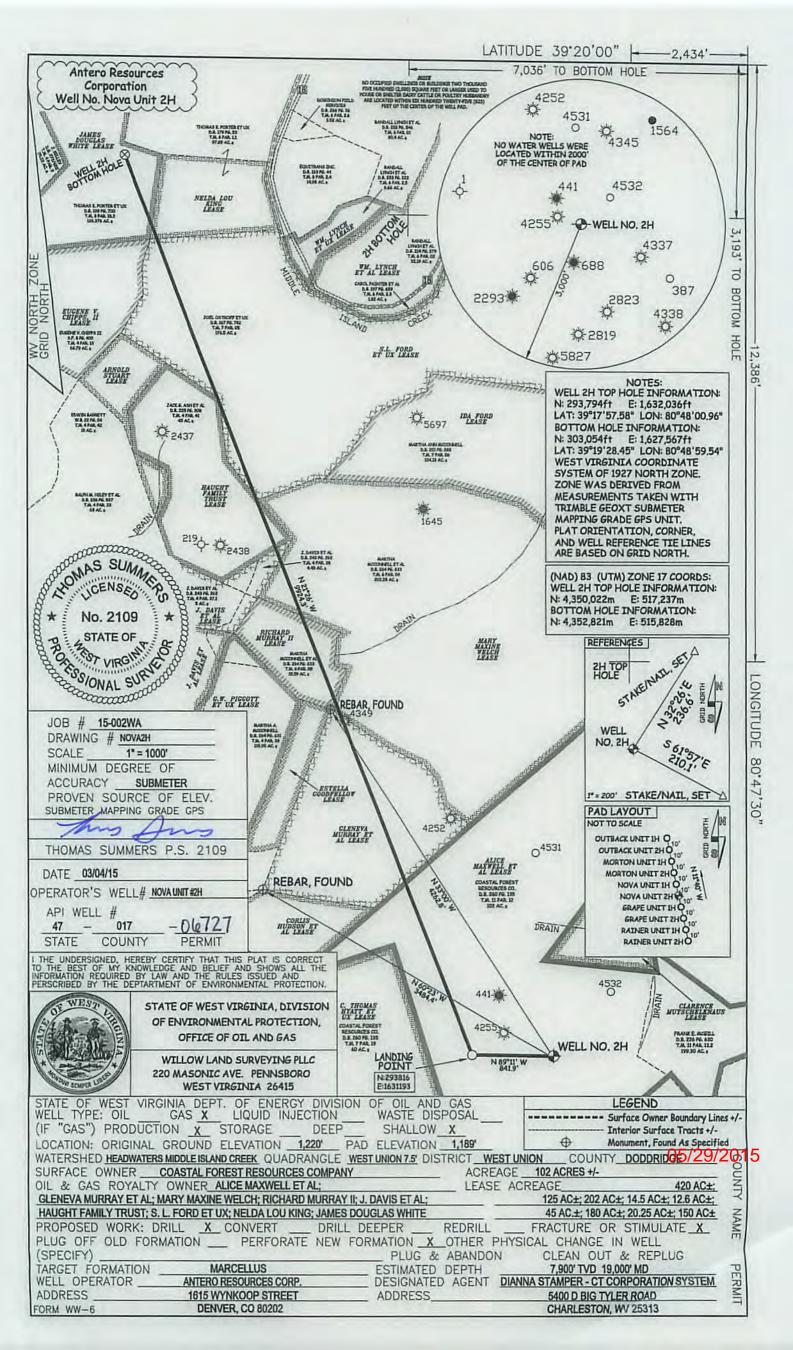

Nova Unit 2H

INFORMATION SUPPLIED UNDER WEST VIRGINIA CODE Chapter 22, Article 6A, Section 5(a)(5) IN LIEU OF FILING LEASE(S) AND OTHER CONTINUING CONTRACT(S)

Under the oath required to make the verification on page 1 of this Notice and Application, I depose and say that I am the person who signed the Notice and Application for the Applicant, and that --

- (1) the tract of land is the same tract described in this Application, partly or wholly depicted in the accompanying plat, and described in the Construction and Reclamation Plan;
- (2) the parties and recordation data (if recorded) for lease(s) or other continuing contract(s) by which the Applicant claims the right to extract, produce or market the oil or gas are as follows:

Grantor, lessor, etc.	Grantee, lessee, etc.	Royalty	Book/Page
Alice Maxwell, et al Lease			
Alice H. Maxwell, et al	Carl D. Perkins & William Paul McCutchan	1/8	0063/0111
Carl D. Perkins & William Paul McCutchan, et al	Justin L. Henderson	Assignment	0104/0589
Justin Henderson	P.D. Farr II	Assignment	0109/0385
P.D. Farr II	Antero Resources Appalachian Corporation	Assignment	0271/0546
Antero Resources Appalachian Corporation	Antero Resources Corporation	Name Change	Exhibit 1
Gleneva Murray, et al Lease			
Gleneva Murray, et al	Murvin Oil Company	1/8	0174/0112
Murvin Oil Company	Murvin & Meier Oil Company	Assignment	0179/0193
Murvin & Meier Oil Company	Tenmile Land, LLC	Assignment	0252/0609
Tenmile Land, LLC	Antero Resources Appalachian Corporation	Assignment	0261/0014
Antero Resources Appalachian Corporation	Antero Resources Corporation	Name Change	Exhibit 1
Mary Maxine Welch Lease			
Mary Maxine Welch	Antero Resources Appalachian Corporation	1/8+	0271/0060
Mary Maxine Welch	Antero Resources Appalachian Corporation	1/8+	0271/0066
Antero Resources Appalachian Corporation	Antero Resources Corporation	Name Change	Exhibit1
Richard Murray II Lease			
Richard Patrick Murray, II	Antero Resources Appalachian Corporation		0266/0585
Antero Resources Appalachian Corporation	Antero Resources Corporation	Name Change	Exhibit 1
<u>J. Davis, et al Lease</u>			
Jonathan L. Davis, et al	Antero Resources Appalachian Corporation	1/8+	0283/0130
Antero Resources Appalachian Corporation	Antero Resources Corporation	Name Change	Exhibit 1
Haught Family Trust Lease			
Haught Family Trust (dated April 17, 1989)	Antero Resources Appalachian Corporation	1/8+	0263/0482
Antero Resources Appalachian Corporation	Antero Resources Corporation	Name Change	Exhibit 1
S. L. Ford, et ux Lease		DE0511	2024/2422
S.L. Ford, et x	J.L. Neuman	RECEIVED	0021/0172
J.L. Neuman	The Philadelphia Company	Office of Chilliand Gas	0106/0474
The Philadelphia Company	Pittsburgh and West Virginia Gas Company	_	DB 0045/0102
Pittsburgh & West Virginia Gas Company	Equitable Gas Company	Assignment	0121/0257
Equitable Gas Company	Equitrans, Inc.	MARA±is7m2015	0154/0475
Equitrans, Inc.	Equitrans, L.P.	Merger	Recited in 302/0123
Equitrans, L.P.	Equitable Production-Eastern States, Inc.	WV Department of	0192/0019
Equitable Production Eastern States, Inc.	Equitable Production Company	Environment of Pro-	Exhibit 2
Equitable Production Company	EQT Production Company	Environmented Protection	OB 0281/0346 0325/0539
EQT Production Company	Antero Resources Corporation	vəsikumenr	V323/V33 3
Nelda Lou King Lease	A B	4/0.	0310/0550
Nelda Lou King	Antero Resources Corporation	1/8+	0310/0559

^{*}Partial Assignments to Antero Resources Corporation include 100% rights to extract, produce and market the oil and gas from the Marcellus and any other formations completed with this well.

INFORMATION SUPPLIED UNDER WEST VIRGINIA CODE Chapter 22, Article 6A, Section 5(a)(5) IN LIEU OF FILING LEASE(S) AND OTHER CONTINUING CONTRACT(S)

Under the oath required to make the verification on page 1 of this Notice and Application, I depose and say that I am the person who signed the Notice and Application for the Applicant, and that –

- (1) the tract of land is the same tract described in this Application, partly or wholly depicted in the accompanying plat, and described in the Construction and Reclamation Plan;
- (2) the parties and recordation data (if recorded) for lease(s) or other continuing contract(s) by which the Applicant claims the right to extract, produce or market the oil or gas are as follows:

James Douglas White Lease	James Douglas White	Antero Resources Corporation	1/8+	0313/0688
Number	Grantor, Lessor, etc.	Grantee, Lessee, etc.	Royalty	Book/Page
Lease Name or				

^{*}Partial Assignments to Antero Resources Corporation include 100% rights to extract, produce and market the oil and gas from the Marcellus and any other formations completed with this well.

Acknowledgement of Possible Permitting/Approval In Addition to the Office of Oil and Gas

The permit applicant for the proposed well work addressed in this application hereby acknowledges the possibility of the need for permits and/or approvals from local, state, or federal entities in addition to the DEP, Office of Oil and Gas, including but not limited to the following:

- WV Division of Water and Waste Management
- WV Division of Natural Resources WV Division of Highways
- U.S. Army Corps of Engineers
- U.S. Fish and Wildlife Service
- County Floodplain Coordinator


The applicant further acknowledges that any Office of Oil and Gas permit in no way overrides, replaces, or nullifies the need for other permits/approvals that may be necessary and further the permits/approvals should be acquired from the appropriate authority before the affected activity is initiated.

Well Operator:	Antero Resources C	ofporation 1 7 2015
By:	Kevin Kilstrom	
Its:	VP of Production	WV Department of
	Fr	vironmental Protection

Page 1 of ____

Natalie B. Tennant. Secretary of State 1900 Kanawha Bivd E Bldg I, Suite 157-K Charleston, WV 25305

FILE ONE ORIGINAL (Two if you want a filed stamped copy returned to you) FEE: \$25:00

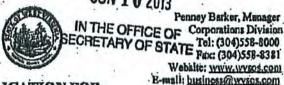

APPLICATION FOR AMENDED CERTIFICATE OF AUTHORITY

**** In accordance with the provisions of the West Virginia Code, the undersigned corporation hereby ****

Office Hours: Monday - Friday 8:30 a.m. - 5:00 p.m. BT

applies for an Amended Certificate of Authority and submits the following statement: 1. Name under which the corporation was Antero Resources Appalachian Corporation authorized to transact business in WV: 2. Date Certificate of Authority was 6/25/2008 issued in West Virginia: Antero Resources Corporation 3. Corporate name has been changed to: (Attach one Certified Copy of Name Change as filed in home State of incorporation.) Antero Resources Corporation 4. Name the corporation elects to use in WV: (due to home state name not being available) 5. Other amendments: (attach additional pages if necessary) 6. Name and phone number of contact person. (This is optional, however, if there is a problem with the filing, listing a contact person and phone number may avoid having to return or reject the document.) Alwn A. Schopp (303) 357-7310 Contact Name Phone Number 7. Signature information (See below *Important Legal Notice Regarding Signature): Title/Capacity; Authorized Person

*Important Level Notice Repartition Standard: Per West Virginia Code 8310-1-129. Penalty for signing fair deciminal, IVED Any person who signs a document he or she knows is false in any material respect and knows that the document is to be delivered to the secretary of state for filing is guilty of a misdomesmor and, upon conviction thereof, shall be fined to fire than one it and Gas thousand delies or confised in the county or regional jall not more than one year, or both.

Date: June 10, 2013

Porm CF-

Signature:

Print Name of Signer: Allyn A. Schopp

lisued by the Office of the Secretary of Sinte

MAR 1 7 2015

WV Department of Environmental Protection

WV611 - 644 6/2017 Walters Klasver Oullan

RM WW-6A1 **EXHIBIT 2**



I, Joe Manchin III, Secretary of State of the State of West Virginia, hereby certify that

by the provisions of Chapter 31 of the West Virginia Code, Articles of Merger were received and filed MERGING EQUITABLE PRODUCTION - EASTERN STATES, INC., A QUALIFIED DE ORGANIZATION, WITH AND INTO EQUITABLE PRODUCTION COMPANY, A QUALIFIED ORGANIZATION.

Therefore, I hereby issue this

CERTIFICATE OF MERGER



Given under my hand and the Great Seal of the State of West Virginia on this day of June 28, 2001

RECEIVED Office of Oil and Gas

WV Department of Environmental Protection of State

05/29/2015



March 6, 2015

Antero Resources 1615 Wynkoop Street Denver, CO 80202 Office 303.357.7310 Fax 303.357.7315

West Virginia Department of Environmental Protection Chief, Office of Oil and Gas Attn: Mr. James Martin 601 57th Street SE Charleston, WV 25304

RE: Nova Unit 2H

Quadrangle: West Union 7.5'

Doddridge County/West Union District, West Virginia

Mr. Martin:

Antero Resources Corporation (Antero) is submitting the following application for a new well work permit for the Nova Unit 2H horizontal shallow well. As an authorized representative, I certify that Antero has the right to extract, produce or market the oil or gas for all leases through which the Nova Unit 2H horizontal lateral will drill through including any and all roads crossed under as identified on the attached survey plat.

Sincerely.

Thomas Kuhn Landman

RECEIVED
Office of Oil and Gas

MAR 1 7 2015

WV Department of Environmental Protection 05/29/2015 Date of Notice Certification: 03/09/2015

the return receipt card or other postal receipt for certified mailing.

STATE OF WEST VIRGINIA DEPARTMENT OF ENVIRONMENTAL PROTECTION, OFFICE OF OIL AND GAS NOTICE CERTIFICATION

API No. 47- 017

Operator's Well No. Nova Unit 2H

State:	tract of land as follows: West Virginia	UTM NAD 83 Easting: 5	17,237m	
County:	Doddridge	Northing: 4	,350,022m	
District:	West Union		CR 11/3	
)uadrangle:	West Union 7.5'	Generally used farm name:	Coastal Forest Resources Company	
Vatershed:	Headwaters Middle Island Creek			
rescribed by has provide aformation re f giving the equirements irginia Code	the secretary, shall be verified and significant the owners of the surface described equired by subsections (b) and (c), se surface owner notice of entry to su of subsection (b), section sixteen o	every permit application filed under this shall contain the following information: (14) bed in subdivisions (1), (2) and (4), subsection sixteen of this article; (ii) that the requirvey pursuant to subsection (a), section tenf this article were waived in writing by the ender proof of and certify to the secretary that.	A certification from the operation (b), section ten of this irement was deemed satisfient of this article six-a; or (iii e surface owner; and Pursu	article d as a re) the no
hat the Ope	West Virginia Code § 22-6A, the Oprator has properly served the require	erator has attached proof to this Notice Cert d parties with the following:	OOG OFFIC	
PLEASE CHI	CK ALL THAT APPLY		ONLY	
□ 1. NO	TICE OF SEISMIC ACTIVITY or	■ NOTICE NOT REQUIRED BECAUS SEISMIC ACTIVITY WAS CONDUCTED		
	TICE OF ENTRY FOR PLAT SURV	YEY or ☐ NO PLAT SURVEY WAS CON	NDUCTED TRECEIVE	ED
■ 2. NO				
	FICE OF INTENT TO DRILL or	NOTICE NOT REQUIRED BECAUS NOTICE OF ENTRY FOR PLAT SURVE WAS CONDUCTED or	1000000	
	FICE OF INTENT TO DRILL or	NOTICE OF ENTRY FOR PLAT SURVE	NOT REC	
□ 3. NO	TICE OF INTENT TO DRILL OF	NOTICE OF ENTRY FOR PLAT SURVE WAS CONDUCTED OF WRITTEN WAIVER BY SURFACE	NOT REC	UIREI
□ 3. NO		NOTICE OF ENTRY FOR PLAT SURVE WAS CONDUCTED OF WRITTEN WAIVER BY SURFACE	NOT REC)UIREI

Advertisement with publication date verification or the associated Affidavit of Publication. The attached Notice Forms and Certifications of Notice shall serve as proof that the required parties have been noticed as required under West Vinginia Code § 22-6A. Pursuant to West Virginia Code § 22-6A-11(b), the Certification of Notice to the person may be made by affidavit of personal service, WV Department of Environmental Protection

Certification of Notice is hereby given:

THEREFORE, I Kevin Kilstrom , have read and understand the notice requirements within West Virginia Code § 22-6A. I certify that as required under West Virginia Code § 22-6A. I have served the attached copies of the Notice Forms, identified above, to the required parties through personal service, by registered mail or by any method of delivery that requires a receipt or signature confirmation. I certify under penalty of law that I have personally examined and am familiar with the information submitted in this Notice Certification and all attachments, and that based on my inquiry of those individuals immediately responsible for obtaining the information, I believe that the information is true, accurate and complete. I am aware that there are significant penalties for submitting false information, including the possibility of fine and imprisonment.

Well Operator: Antero Resources Corporation Address: 1615 Wynkoop Street

By: Kevin Kilstrom Denver, CO 80202

Its: VP of Production Facsimile: 303-357-7315

Telephone: (303) 357-7310 Email: asteele@anteroresources.com

NOTARY SEAL

KARA QUACKENBUSH
NOTARY PUBLIC
STATE OF COLORADO
NOTARY ID 20144028297
MY COMMISSION EXPIRES JULY 21, 2018

Subscribed and sworn before me this	9	day of	March	2015
-------------------------------------	---	--------	-------	------

KUU QUUKLWOUSH Notary Public

My Commission Expires JMM 21,2018

Oil and Gas Privacy Notice:

The Office of Oil and Gas processes your personal information, such as name, address and telephone number, as part of our regulatory duties. Your personal information may be disclosed to other State agencies or third parties in the normal course of business or as needed to comply with statutory or regulatory requirements, including Freedom of Information Act requests. Our office will appropriately secure your personal information. If you have any questions about our use or your personal information, please contact DEP's Chief Privacy Officer at deprivacyofficer@wv.gov.

RECEIVED
Office of Oil and Gas

MAR 1 7 2015

WV Department of Environmental Protection WW-6A (9-13)

API NO. 47- 017 -	
OPERATOR WELL NO.	Nova Unit 2H
Well Pad Name: Cofor Pad	

STATE OF WEST VIRGINIA DEPARTMENT OF ENVIRONMENTAL PROTECTION, OFFICE OF OIL AND GAS NOTICE OF APPLICATION

Notice Time Requirement: notice shall be provided no later than the filing date of permit application. Date of Notice: 3/11/2015 Date Permit Application Filed: 3/11/2015 Notice of: PERMIT FOR ANY ☐ CERTIFICATE OF APPROVAL FOR THE WELL WORK CONSTRUCTION OF AN IMPOUNDMENT OR PIT Delivery method pursuant to West Virginia Code § 22-6A-10(b) ☐ REGISTERED ☑ METHOD OF DELIVERY THAT REQUIRES A ☐ PERSONAL **SERVICE** MAIL RECEIPT OR SIGNATURE CONFIRMATION Pursuant to W. Va. Code § 22-6A-10(b) no later than the filing date of the application, the applicant for a permit for any well work or for a certificate of approval for the construction of an impoundment or pit as required by this article shall deliver, by personal service or by registered mail or by any method of delivery that requires a receipt or signature confirmation, copies of the application, the erosion and sediment control plan required by section seven of this article, and the well plat to each of the following persons: (1) The owners of record of the surface of the tract on which the well is or is proposed to be located; (2) The owners of record of the surface tract or tracts overlying the oil and gas leasehold being developed by the proposed well work, if the surface tract is to be used for roads or other land disturbance as described in the erosion and sediment control plan submitted pursuant to subsection (c), section seven of this article; (3) The coal owner, operator or lessee, in the event the tract of land on which the well proposed to be drilled is located [sic] is known to be underlain by one or more coal seams; (4) The owners of record of the surface tract or tracts overlying the oil and gas leasehold being developed by the proposed well work, if the surface tract is to be used for the placement, construction, enlargement, alteration, repair, removal or abandonment of any impoundment or pit as described in section nine of this article; (5) Any surface owner or water purveyor who is known to the applicant to have a water well, spring or water supply source located within one thousand five hundred feet of the center of the well pad which is used to provide water for consumption by humans or domestic animals; and (6) The operator of any natural gas storage field within which the proposed well work activity is to take place. (c)(1) If more than three tenants in common or other co-owners of interests described in subsection (b) of this section hold interests in the lands, the applicant may serve the documents required upon the person described in the records of the sheriff required to be maintained pursuant to section eight, article one, chapter eleven-a of this code, (2) Notwithstanding any provision of this article to the contrary, notice to a lien holder is not notice to a landowner, unless the lien holder is the landowner. W. Va. Code R. § 35-8-5.7.a requires, in part, that the operator shall also provide the Well Site Safety Plan ("WSSP") to the surface owner and any water purveyor or surface owner subject to notice and water testing as provided in section 15 of this rule. ☐ Application Notice ☐ WSSP Notice ☐ E&S Plan Notice ☐ Well Plat Notice is hereby provided to: ☑ SURFACE OWNER(s) COAL OWNER OR LESSEE Name: NO DECLARATIONS ON RECORD WITH COUNTY Name: Coastal Forest Resources Co. Address: P.O. Box 709 Address: Buckhannon, WV 26201 COAL OPERATOR Name: Name: _____ Address: Address: SURFACE OWNER(s) (Road and/or Other Disturbance) WATER PURVEYOR(s)/OWNER(s) OF WATER WELL. Name: __ SPRING OR OTHER WATER SUPPLY SOURCE Address: Name: NONE IDENTIFIED WITHIN 1500' Name: Address: Address: **OPERATOR OF ANY NATURAL GAS STORAGE FIELD** ☐ SURFACE OWNER(s) (Impoundments or Pits) Name: RECEIVED Address: Office of Oil and Gas Name: _____ Address: *Please attach additional forms if necessary MAR 1 7 2015

WV Department of Environmental Protection 05/29/2015

WW-6A	
(8-13)	

API NO. 47-017 OPERATOR WELL NO. Nova Unit 2H
Well Pad Name: Cofor Pad

Notice is hereby given:

Pursuant to West Virginia Code § 22-6A-10(b), notice is hereby given that the undersigned well operator has applied for a permit for well work or for a certificate of approval for the construction of an impoundment or pit.

This Notice Shall Include:

Pursuant to W. Va. Code § 22-6A-10(b), this notice shall include: (1) copies of the application; (2) the erosion and sediment control plan required by section seven of this article; and (3) the well plat.

Pursuant to W. Va. Code § 22-6A-10(f), this notice shall include: (1) a statement of the time limits for filing written comments; (2) who may file written comments; (3) the name and address of the secretary for the purpose of filing the comments and obtaining additional information; and (4) a statement that the persons may request, at the time of submitting written comments, notice of the permit decision and a list of persons qualified to test water.

Pursuant to W. Va. Code R. § 35-8-5.7.a, the operator shall provide the Well Site Safety Plan to the surface owner and any water purveyor or surface owner subject to notice and water testing as provided in section 15 of this rule.

Pursuant to W. Va. Code R. § 35-8-15.2.c, this notice shall: (1) contain a statement of the surface owner's and water purveyor's right to request sampling and analysis; (2) advise the surface owner and water purveyor of the rebuttable presumption for contamination or deprivation of a fresh water source or supply; advise the surface owner and water purveyor that refusal to allow the operator to conduct a pre-drilling water well test constitutes a method to rebut the presumption of liability; (3) advise the surface owner and water purveyor of his or her independent right to sample and analyze any water supply at his or her own expense; advise the surface owner and water purveyor whether or not the operator will utilize an independent laboratory to analyze any sample; and (4) advise the surface owner and or water purveyor that he or she can obtain from the Chief a list of water testing laboratories in the subject area capable of and qualified to test water supplies in accordance with standard acceptable methods.

Additional information related to horizontal drilling may be obtained from the Secretary, at the WV Department of Environmental Protection headquarters, located at 601 57th Street, SE, Charleston, WV 25304 (304-926-0450) or by visiting www.dep.wv.gov/oil-and-gas/pages/default.aspx.

Well Location Restrictions

Pursuant to W. Va. Code § 22-6A-12, Wells may not be drilled within two hundred fifty feet measured horizontally from any existing water well or developed spring used for human or domestic animal consumption. The center of well pads may not be located within six hundred twenty-five feet of an occupied dwelling structure, or a building two thousand five hundred square feet or larger used to house or shelter dairy cattle or poultry husbandry. This limitation is applicable to those wells, developed springs, dwellings or agricultural buildings that existed on the date a notice to the surface owner of planned entry for surveying or staking as provided in section ten of this article or a notice of intent to drill a horizontal well as provided in subsection (b), section sixteen of this article was provided, whichever occurs first, and to any dwelling under construction prior to that date. This limitation may be waived by written consent of the surface owner transmitted to the department and recorded in the real property records maintained by the clerk of the county commission for the county in which such property is located. Furthermore, the well operator may be granted a variance by the secretary from these distance restrictions upon submission of a plan which identifies the sufficient measures, facilities or practices to be employed during well site construction, drilling and operations. The variance, if granted, shall include terms and conditions the department requires to ensure the safety and protection of affected persons and property. The terms and conditions may include insurance, bonding and indemnification, as well as technical requirements. (b) No well pad may be prepared or well drilled within one hundred feet measured horizontally from any perennial stream, natural or artificial lake, pond or reservoir, or a wetland, or within three hundred feet of a naturally reproducing trout stream. No well pad may be located within one thousand feet of a surface or ground water intake of a public water supply. The distance from the public water supply as identified by the department shall be measured as follows: (1) For a surface water intake on a lake or reservoir, the distance shall be measured from the boundary of the lake or reservoir. (2) For a surface water intake on a flowing stream, the distance shall be measured from a semicircular radius extending upstream of the surface water intake. (3) For a groundwater source, the distance shall be measured from the wellhead or spring. The department may, in its discretion, waive these distance restrictions upon submission of a plan identifying suffice the least the lacilities or practices to be employed during well site construction, drilling and operations to protect the waters of the late of walker fight shall impose any permit conditions as the secretary considers necessary. (c) Notwithstanding the foregoing provisions of this section, nothing contained in this section prevents an operator from conducting the activities permitted or authorized by a Clean Water Act Section 404 permit or other approval from the United States Army Corps of Engineers within any waters of the state of within the restricted areas referenced in this section. (d) The well location restrictions set forth in this section shall not apply to any well on a multiple well pad if at least one of the wells was permitted prior to the effective date of this article. (e) The secretary whall Deplacement 101012, report to the Legislature on the noise, light, dust and volatile organic compounds generated by the drilling of horizontal wells as they relate to the well location restrictions regarding occupied dwelling structures pursuant to this section. Upon a finding, if any, by the secretary that the well location restrictions regarding occupied dwelling structures are inadequate or otherwise require alteration to address the items

WW-6A	
(8-13)	

API NO. 47-017 OPERATOR WELL NO. Nova Unit 2H
Well Pad Name: Cofor Pad

examined in the study required by this subsection, the secretary shall have the authority to propose for promulgation legislative rules establishing guidelines and procedures regarding reasonable levels of noise, light, dust and volatile organic compounds relating to drilling horizontal wells, including reasonable means of mitigating such factors, if necessary.

Water Well Testing:

Pursuant to West Virginia Code § 22-6A-10(d), notification shall be made, with respect to surface landowners identified in subsection (b) or water purveyors identified in subdivision (5), subsection (b) of this section, of the opportunity for testing their water well. The operator shall provide an analysis to such surface landowner or water purveyor at their request.

Water Testing Laboratories:

Pursuant to West Virginia Code § 22-6A-10(i), persons entitled to notice pursuant to subsection (b) of this section may contact the department to ascertain the names and locations of water testing laboratories in the subject area capable and qualified to test water supplies in accordance with standard accepted methods. In compiling that list of names the department shall consult with the state Bureau for Public Health and local health departments. A surface owner and water purveyor has an independent right to sample and analyze any water supply at his or her own expense. The laboratory utilized by the operator shall be approved by the agency as being certified and capable of performing sample analyses in accordance with this section.

Rebuttable Presumption for Contamination or Deprivation of a Fresh Water Source or Supply:

W. Va. Code § 22-6A-18 requires that (b) unless rebutted by one of the defenses established in subsection (c) of this section, in any action for contamination or deprivation of a fresh water source or supply within one thousand five hundred feet of the center of the well pad for horizontal well, there is a rebuttable presumption that the drilling and the oil or gas well or either was the proximate cause of the contamination or deprivation of the fresh water source or supply. (c) In order to rebut the presumption of liability established in subsection (b) of this section, the operator must prove by a preponderance of the evidence one of the following defenses: (1) The pollution existed prior to the drilling or alteration activity as determined by a predrilling or prealteration water well test, (2) The landowner or water purveyor refused to allow the operator access to the property to conduct a predrilling or prealteration water well test. (3) The water supply is not within one thousand five hundred feet of the well. (4) The pollution occurred more than six months after completion of drilling or alteration activities. (5) The pollution occurred as the result of some cause other than the drilling or alteration activity. (d) Any operator electing to preserve its defenses under subdivision (1), subsection (c) of this section shall retain the services of an independent certified laboratory to conduct the predrilling or prealteration water well test. A copy of the results of the test shall be submitted to the department and the surface owner or water purveyor in a manner prescribed by the secretary. (e) Any operator shall replace the water supply of an owner of interest in real property who obtains all or part of that owner's supply of water for domestic, agricultural, industrial or other legitimate use from an underground or surface source with a comparable water supply where the secretary determines that the water supply has been affected by contamination, diminution or interruption proximately caused by the oil or gas operation, unless waived in writing by that owner. (f) The secretary may order the operator conducting the oil or gas operation to: (1) Provide an emergency drinking water supply within twenty-four hours; (2) Provide temporary water supply within seventy-two hours; (3) Within thirty days begin activities to establish a permanent water supply or submit a proposal to the secretary outlining the measures and timetables to be used in establishing a permanent supply. The total time in providing a permanent water supply may not exceed two years. If the operator demonstrates that providing a permanent replacement water supply cannot be completed within two years, the secretary may extend the time frame on case-by-case basis; and (4) Pay all reasonable costs incurred by the real property owner in securing a water supply. (g) A person as described in subsection (b) of this section aggrieved under the provisions of subsections (b), (e) or (f) of this section may seek relief in court... (i) Notwithstanding the denial of the operator of responsibility for the damage to the real property owner's water supply or the status of any appeal on determination of liability for the damage to the real property owner's water supply, the operator may not discontinue providing the required water service until authorized to do so by the secretary or a court of competent jurisdiction.

Written Comment:

Pursuant to West Virginia Code § 22-6A-11(a), all persons described in subsection (b), section ten of this article may file written comments with the secretary as to the location or construction of the applicant's proposed well work within thirty days after the application is filed with the secretary. All persons described in West Virginia Code § 22-6A-10(b) may file written comments as to the location or construction of the applicant's proposed well work to the Secretary at:

Chief, Office of Oil and Gas
Department of Environmental Protection
601 57th St. SE
Charleston, WV 25304
(304) 926-0450

RECEIVED
Office of Oil and Gas

MAR 1 7 2015

Such persons may request, at the time of submitting written comments, notice of the permit decision and a list of persons qualified to test water. NOTE: YOU ARE NOT REQUIRED TO FILE ANY COMMENT.

WV Department of Environmental Protection

05/29/2015

API NO. 47-017 OPERATOR WELL NO. Nova Unit 2H
Well Pad Name: Cofor Pad

Time Limits and Methods for Filing Comments.

The law requires these materials to be served on or before the date the operator files its Application. You have THIRTY (30) DAYS after the filing date to file your comments. Comments must be filed in person or received in the mail by the Chief's office by the time stated above. You may call the Chief's office to be sure of the date. Check with your postmaster to ensure adequate delivery time or to arrange special expedited handling. If you have been contacted by the well operator and you have signed a "voluntary statement of no objection" to the planned work described in these materials, then the permit may be issued at any time.

Pursuant to West Virginia Code § 22-6A-11(c)(2), Any objections of the affected coal operators and coal seam owners and lessees shall be addressed through the processes and procedures that exist under sections fifteen, seventeen and forty, article six of this chapter, as applicable and as incorporated into this article by section five of this article. The written comments filed by the parties entitled to notice under subdivisions (1), (2), (4), (5) and (6), subsection (b), section ten of this article shall be considered by the secretary in the permit issuance process, but the parties are not entitled to participate in the processes and proceedings that exist under sections fifteen, seventeen or forty, article six of this chapter, as applicable and as incorporated into this article by section five of this article.

Comment Requirements

Your comments must be in writing and include your name, address and telephone number, the well operator's name and well number and the approximate location of the proposed well site including district and county from the application. You may add other documents, such as sketches, maps or photographs to support your comments.

Disclaimer: All comments received will be placed on our web site http://www.dep.wv.gov/oil-and-gas/Horizontal-Permits/Pages/default.aspx and the applicant will automatically be forwarded an email notice that such comments have been submitted. The applicant will be expected to provide a response to comments submitted by any surface owner, water purveyor or natural gas storage operator noticed within the application.

Permit Denial or Condition

The Chief has the power to deny or condition a well work permit. Pursuant to West Virginia Code § 22-6A-8(d), the permit may not be issued or be conditioned, including conditions with respect to the location of the well and access roads prior to issuance if the director determines that:

- (1) The proposed well work will constitute a hazard to the safety of persons;
- (2) The plan for soil erosion and sediment control is not adequate or effective;
- (3) Damage would occur to publicly owned lands or resources; or
- (4) The proposed well work fails to protect fresh water sources or supplies.

A permit may also be denied under West Virginia Code § 22-6A-7(k), the secretary shall deny the issuance of a permit if the secretary determines that the applicant has committed a substantial violation of a previously issued permit for a horizontal well, including the applicable erosion and sediment control plan associated with the previously issued permit, or a substantial violation of one or more of the rules promulgated under this article, and in each instance has failed to abate or seek review of the violation within the time prescribed by the secretary pursuant to the provisions of subdivisions (1) and (2), subsection (a), section five of this article and the rules promulgated hereunder, which time may not be unreasonable.

Pursuant to West Virginia Code § 22-6A-10(g), any person entitled to submit written comments to the secretary pursuant to subsection (a), section eleven of this article, shall also be entitled to receive from the secretary a copy of the permit as issued or a copy of the order modifying or denying the permit if the person requests receipt of them as a part of the written comments submitted concerning the permit application. Such persons may request, at the time of submitting written comments, notice of the permit decision and a list of persons qualified to test water.

RECEIVED
Office of Oil and Gas

MAR 1 7 2015

WV Department of Environmental Protection WW-6A (8-13) API NO. 47- 017 OPERATOR WELL NO. Nova Unit 2H
Well Pad Name: Cofor Pad

Notice is hereby given by:

Well Operator: Antero Resources Corporation

Telephone: (303) 357-7310 La Muldina Email: asteele@anteroresources.com

Address: 1615 Wynkoop Street

Denver, CO 80202

Facsimile: 303-357-7315

Oil and Gas Privacy Notice:

The Office of Oil and Gas processes your personal information, such as name, address and telephone number, as part of our regulatory duties. Your personal information may be disclosed to other State agencies or third parties in the normal course of business or as needed to comply with statutory or regulatory requirements, including Freedom of Information Act requests. Our office will appropriately secure your personal information. If you have any questions about our use or your personal information, please contact DEP's Chief Privacy Officer at depprivacyofficer@wv.gov.

KARA QUACKENBUSH
NOTARY PUBLIC
STATE OF COLORADO
NOTARY ID 20144028297
MY COMMISSION EXPIRES JULY 21, 2018

Subscribed and sworn before me this 11 day of MUY, Ch 2015.

KUUL OULUKUMOUY Notary Public

My Commission Expires TUY 21/2018

RECEIVED
Office of Oil and Gas

MAR 1 7 2015

WV Department of Environmental Protection 05/29/2015

Operator Well No.	Nova Unit 2H
Multiple Malle on the	Cofor Dad

STATE OF WEST VIRGINIA DEPARTMENT OF ENVIRONMENTAL PROTECTION, OFFICE OF OIL AND GAS NOTICE OF ENTRY FOR PLAT SURVEY

Notice Time Req	uirement:	Notice shall be prov	vided at least SE	VEN (7) da	ys but no more tha	n FORTY-FIVE (45) days prior to
Date of Notice: 3	/14/2014	Date of Plan	nned Entry: 3/2	4/2014		
Delivery method	pursuant	to West Virginia C	ode § 22-6A-10	a		
☐ PERSONAL		REGISTERED	■ METH	OD OF DEL	IVERY THAT RE	EOUIRES A
SERVICE		MAIL			NATURE CONFIR	
on to the surface t but no more than t beneath such tract owner of minerals and Sediment Con Secretary, which s enable the surface	ract to cond forty-five d that has fil underlying strol Manua statement sl owner to co	duct any plat surveys lays prior to such enti- led a declaration pur- g such tract in the co- al and the statutes and shall include contact obtain copies from the	s required pursu try to: (1) The s suant to section ounty tax record ad rules related to information, income	ant to this an urface owne thirty-six, a s. The notice o oil and gas	rticle. Such notice s r of such tract; (2) rticle six, chapter t e shall include a sta s exploration and p	r shall provide notice of planned entry shall be provided at least seven days to any owner or lessee of coal seams wenty-two of this code; and (3) any atement that copies of the state Erosion production may be obtained from the age on the Secretary's web site, to
Notice is hereby	provided t	0:				
■ SURFACE O				☐ COA	L OWNER OR LE	SSEE
Name: Coastal For	est Resources	Co.	2		DECLARATIONS ON RE	
Address: PO Box 70		/	_	Address:		
	n, WV 26201		-	_		
Name:			-	MINI	ERAL OWNER(s)	
					And the second s	artnership #1 C/O ICG-Bank One
				Address:		arthership #1 C/O ICG-Bank One
				and a second sec	Buckhannon, WV 26201	
				*please attac	h additional forms if ne	ecessary
a plat survey on the State: West County: Dod District: West	Virginia Co		P W	pprox. Latit ublic Road A vatershed:	ude & Longitude: Access:	I operator is planning entry to conduct 39.299423, -80.800056 (NAD 83) CR 11/8 Tributary of Arnold Creek.
Quadrangle: Wes	t Union 7.5'		G	enerally use	d farm name:	Coastal Forest Resources Company
may be obtained fi Charleston, WV 2 obtained from the Notice is hereby	rom the Se 25304 (304 Secretary b	cretary, at the WV E -926-0450). Copies by visiting <u>www.dep</u>	Department of E of such docume	nvironmenta ents or addit	Il Protection headq ional information r lefault.aspx.	il and gas exploration and production uarters, located at 601 57 th Street, SE, related to horizontal drilling may be
	The second second		_	Address.	1615 Wynkoop Street	
The second secon	303) 357-7323				Denver, CO 80202	
Email:	stople@-sto	annument nam		Facsimile	(303) 357-7315	
Email: a	steele@anteror	esources.com		Facsimile:	(303) 357-7315	RECEIVED

The Office of Oil and Gas processes your personal information, such as name, address and telephone number, as part of our regulatory duties. Your personal information may be disclosed to other State agencies or third parties in the normal course of business or as needed to comply with statutory or regulatory requirements, including Freedom of Information Act Trequests. Our office will appropriately secure your personal information. If you have any questions about our use or your personal information, please contact DEP's Chief Privacy Officer at depprivacyofficer@wv.gov.

WV Department of Environmental Prote 05/29/2015

WW-6A5 (1/12)

Operator Well No. Nova Unit 2H

STATE OF WEST VIRGINIA DEPARTMENT OF ENVIRONMENTAL PROTECTION, OFFICE OF OIL AND GAS NOTICE OF PLANNED OPERATION

Date of Notic	e: 03/11/2015 Date Permi	t Application Filed: 03/1	date of permit application.
Delivery met	hod pursuant to West Virginia Code	e § 22-6A-16(c)	
CERTII	FIED MAIL [☐ HAND	
RETU	N RECEIPT REQUESTED	DELIVERY	
Pursuant to Vereturn receipt the planned of required to be drilling of a lidamages to the (d) The notice of notice.	V. Va. Code § 22-6A-16(c), no later to requested or hand delivery, give the superation. The notice required by this provided by subsection (b), section to horizontal well; and (3) A proposed subsection gas operate surface affected by oil and gas operate.	urface owner whose land is subsection shall included on this article to a surface use and compensations to the extent the date of the surface owner as the s	he permit application, an operator shall, by certified maild will be used for the drilling of a horizontal well notice of de: (1) A copy of this code section; (2) The information ace owner whose land will be used in conjunction with the sation agreement containing an offer of compensation for amages are compensable under article six-b of this chapter. at the address listed in the records of the sheriff at the time
Address: P.O. Buckt Notice is here Pursuant to Woperation on	eby given: /est Virginia Code § 22-6A-16(c), noti the surface owner's land for the purpo	se of drilling a horizonta	he undersigned well operator has developed a planned al well on the tract of land as follows:
Address: P.O. Buckt Notice is her Pursuant to W operation on State:	Box 709 Jeannon, WV 26201 eby given: /est Virginia Code § 22-6A-16(c), noti the surface owner's land for the purpo West Virginia	Address	he undersigned well operator has developed a planned all well on the tract of land as follows: Section 2
Address: P.O. Buckt Notice is her Pursuant to Woperation on State: County:	Box 709 pannon, WV 26201 by given: /est Virginia Code § 22-6A-16(c), noti the surface owner's land for the purpo	Address ce is hereby given that the se of drilling a horizonta	he undersigned well operator has developed a planned all well on the tract of land as follows: Easting: 517,237m Northing: 4,350,022m
Notice is here Pursuant to Woperation on State: County: District:	Box 709 Box	Address ce is hereby given that the se of drilling a horizonta UTM NAD 8 Public Road	he undersigned well operator has developed a planned all well on the tract of land as follows: Easting: 517,237m Northing: 4,350,022m
Address: P.O. Buckt Notice is her Pursuant to W	Box 709 Jannon, WV 26201 Peby given: Vest Virginia Code § 22-6A-16(c), noting the surface owner's land for the purpo West Virginia Doddridge West Union	Address ce is hereby given that the se of drilling a horizonta UTM NAD 8 Public Road	he undersigned well operator has developed a planned al well on the tract of land as follows: Easting: 517,237m Northing: 4,350,022m Access: CR 11/8
Notice is here. Pursuant to Woperation on State: County: District: Quadrangle: Watershed: This Notice Sepursuant to Wood be provided the horizontal we surface affect information readquarters, gas/pages/def	Box 709 Jannon, WV 26201 Leby given: Lest Virginia Code § 22-6A-16(c), notifies surface owner's land for the purpor West Virginia Doddridge West Union West Union West Union 7.5' Headwaters Middle Island Creek Shall Include: Lest Virginia Code § 22-6A-16(c), this led by W. Va. Code § 22-6A-10(b) to lit; and (3) A proposed surface use and led by oil and gas operations to the exeluted to horizontal drilling may be colocated at 601 57th Street, SE, Clault.aspx.	Address ice is hereby given that the se of drilling a horizonta UTM NAD 8 Public Road A Generally use a surface owner whose decompensation agreement the damages are contained from the Secret tharleston, WV 25304 (contents)	he undersigned well operator has developed a planned all well on the tract of land as follows: Easting: 517.237m Northing: 4.350.022m Access: CR 11/8 ed farm name: Coastal Forest Resources Company OA copy of this code section; (2) The information required a land will be used in conjunction with the drilling of a nt containing an offer of compensation for damages to the compensable under article six-b of this chapter. Additional lary, at the WV Department of Environmental Protection (304-926-0450) or by visiting www.dep.wv.gov/oil-and-
Notice is here. Pursuant to Woperation on State: County: District: Quadrangle: Watershed: This Notice Sepursuant to Wood be provided the provided for izontal we surface affect information readquarters, gas/pages/def	Box 709 Jannon, WV 26201 Leby given: Lest Virginia Code § 22-6A-16(c), notifies surface owner's land for the purpor West Virginia Doddridge West Union West Union West Union 7.5' Headwaters Middle Island Creek Shall Include: Lest Virginia Code § 22-6A-16(c), this led by W. Va. Code § 22-6A-10(b) to all; and (3) A proposed surface use and led by oil and gas operations to the explanation of the explana	Address ace is hereby given that the se of drilling a horizonta UTM NAD 8 Public Road A Generally use s notice shall include: (1) a surface owner whose decompensation agreement the damages are contained from the Secret	he undersigned well operator has developed a planned al well on the tract of land as follows: Easting: 517,237m Northing: 4,350,022m Access: CR 11/8 ed farm name: Coastal Forest Resources Company OA copy of this code section; (2) The information required a land will be used in conjunction with the drilling of a nt containing an offer of compensation for damages to the compensable under article six-b of this chapter. Additional lary, at the WV Department of Environmental Protection (304-926-0450) or by visiting www.dep.wv.gov/oil-and-
Notice is here Pursuant to Woperation on State: County: District: Quadrangle: Watershed: This Notice Sursuant to Wood be provided horizontal we surface affect information readquarters,	Box 709 Jannon, WV 26201 Leby given: Lest Virginia Code § 22-6A-16(c), notifies surface owner's land for the purpor West Virginia Doddridge West Union West Union West Union 7.5' Headwaters Middle Island Creek Shall Include: Lest Virginia Code § 22-6A-16(c), this led by W. Va. Code § 22-6A-10(b) to lit; and (3) A proposed surface use and led by oil and gas operations to the exeluted to horizontal drilling may be colocated at 601 57th Street, SE, Clault.aspx.	Address ace is hereby given that the se of drilling a horizonta UTM NAD 8 Public Road A Generally use s notice shall include: (1) a surface owner whose decompensation agreement the damages are contained from the Secret tharleston, WV 25304 (1) Address:	he undersigned well operator has developed a planned all well on the tract of land as follows: Easting: 517.237m Northing: 4.350.022m Access: CR 11/8 ed farm name: Coastal Forest Resources Company OA copy of this code section; (2) The information required a land will be used in conjunction with the drilling of a nt containing an offer of compensation for damages to the compensable under article six-b of this chapter. Additional lary, at the WV Department of Environmental Protection (304-926-0450) or by visiting www.dep.wv.gov/oil-and-

Oli and Gas Privacy Notice:

The Office of Oil and Gas processes your personal information, such as name, address and telephone number, as part of our regulatory duties. Your personal information may be disclosed to other State agencies or third parties in the normal course of business or as needed to comply with statutory or regulatory requirements, including Freedom of Information Act requests. Our office will appropriately secure your personal information. If you have any questions about our use or your personal information, please contact DEP's Chief Privacy Officer at depprivacyofficer@wv.gov.

Office of Oil and Gas

MAR 1 7 2015



WEST VIRGINIA DEPARTMENT OF TRANSPORTATION

Division of Highways

1900 Kanawha Boulevard East • Building Five • Room 110 Charleston, West Virginia 25305-0430 • (304) 558-3505

Paul A. Mattox, Jr., P. E. Secretary of Transportation/ Commissioner of Highways

Earl Ray Tomblin Governor

May 22, 2014

James A. Martin, Chief Office of Oil and Gas Department of Environmental Protection 601 57th Street, SE Charleston, WV 25304

Subject: DOH Permit for the Cofor Pad, Doddridge County
Nova Unit 2H Well site

Dear Mr. Martin,

This well site will be accessed from a DOH permit #04-2013-0684 which has been issued to Antero Resources Corporation for access to the State Road for a well site located off of Doddridge County Route 11 SLS.

The operator has signed a STATEWIDE OIL AND GAS ROAD MAINTENANCE BONDING AGREEMENT and provided the required Bond. This operator is currently in compliance with the DOH OIL AND GAS POLICY dated January 3, 2012.

Very Truly Yours,

Gary K. Clayton, P.E.

Regional Maintenance Engineer Central Office O&G Coordinator

Cc: Lisa Bottinelli

Antero Resources Corporation

CH, OM, D-4

File

RECEIVED
Office of Oil and Gas

MAR 1 7 2015

WV Department of Environmental Protection

05/29/2015

List of Anticipated Additives Used for Fracturing or Stimulating Well

Additives	Chemical Abstract Service Number (CAS #)
Fresh Water	7732-18-5
2 Phosphobutane 1,2,4 tricarboxylic acid	37971-36-1
Ammonium Persulfate	7727-54-0
Anionic copolymer	proprietary
Anionic polymer	proprietary
BTEX Free Hydrotreated Heavy Naphtha	64742-48-9
Cellulase enzyme	(Proprietary)
Demulsifier Base	(Proprietary)
Ethoxylated alcohol blend	Mixture
Ethoxylated Nonylphenol	68412-54-4
Ethoxylated oleylamine	26635-93-8
Ethylene Glycol	107-21-1
Glycol Ethers	111-76-2
guar gum	9000-30-0
Hydrogen Chloride	7647-01-0
Hydrotreated light distillates, non-aromatic, BTEX free	64742-47-8
Isopropyl alcohol	67-63-0
liquid, 2,2-dibromo-3-nitrilopropionamide	10222-01-2
Microparticle	proprietary
Petroleum Distillates (BTEX Below Detect)	64742-47-8
Polyacrylamide	57-55-6
Propargyl Alcohol	107-19-7
Propylene Glycol	57-55-6
Quartz	14808-60-7
Sillica, crystalline quartz	7631-86-9
Sodium Chloride	7647-14-5
Sodium Hydroxide	1310-73-2
Sugar	57-50-1
Surfactant	68439-51-0
Suspending agent (solid)	14808-60-7
Tar bases, quinoline derivs, benzyl chloride-quaternized	72480-70-7

RECEIVED
Office of Oil and Gas

MAR 1 7 2015

WV Department of Environmental Protection

LATITUDE 39 296922 LENGITUDE: -80 799541 (NAD 83) N 434968665 E 51728549 (UTW 20NE 17 METERS

CENTROID OF COPUR WELL PAD LATITUDE: 39 200423 LONGITUDE: -80 800056 (NAD 83) N 4350023.78 E 517240.50 (UTM ZONE 17 METERS)

CENTROID OF ROCK BUN WELL PAD LATITUDE: 39 304923 LONGITUDE: -83 814648 (NAD 83) N 433063148 E 515980.84 (UTM TONE 17 METERS)

GENERAL DESCRIPTION:

THE ACCESS ROAD(S). WELL PADS, AND WATER CONTAINMENT PAD HAVE BEEN CONSTRUCTED TO AID IN THE DEVELOPMENT OF INDIVIDUAL MANCELLUS SHALE CAS WILLS.

1706476, 1706494, 1706509

1706518, 1706519, 1706559, 1706560

FLOODPLAIN NOTES:
THE SITE IS LOCATED IN PLOCOZONE 'X' PER FEMA FLOOD MAPS (SACIFCOIESC & (SACIFCOIESC)

ENVIRONMENTAL NOTES:
WITLAND DELEVATIONS NEW PERFORMS ENTIREN OCTOBER 2013 & FERROART, 2014 BY ALLSTAR
RECOLLOT, LLC TO REVIEW THE STAY FOR WATERS AND STANCES THAN SHOT INLESS WERE RECULATION PLANTS OF THE U.S. ARMY COURS OF ENGINEERS (CREACY) AMOUNT THE WEST VICINETY. DEPARTMENT OF ENVIRONMENTAL PROTECTION (WYDEP). THE FERSUARY OR 2013 ROCK HUN & COFOR OF MATERIAL OF ENVIRONMENTAL PROFICED (MYORY) THE PERIODAY OR, DOTS SICK ON AN ECOPOR PROFILED TO THE PERIODAY OF THE PERIODAY OF THE ALLEYS COULDED, LA AND SOCIALIZED DETERMINATION OF THE LANDSHOED LIKETS OF MATERS AND WITHARD WHOSE MAY BE INSURANTED BY THE DIALECT OR THE WYOR!

ROCK HUN & COFOR EPHEMERAL STREAM REPACT (LINEAR FEET)					
Stream and Impact Cause	F#(LF)	Culvert (LF)	Inlets/Outlets Structures (LF)	Total Impact (LF)	
Ephemeral Steam 04 (Access Road "A")	2	NA.	NA	2	
Ephemoral Stream 05 (Access Road "A")	0	5.2	14	-00	

GEOTECHNICAL NOTES:
A GEOTECHNICAL INVESTIGATION OF THE SITE WAS PERFORMED BY PENNSYLVANIA SOIL A ROCK INC. A GRUTECHNICAL INVESTIGATION OF THE SITE VAS PERSONADD BY FIRMSTLVANIA SOIL & HOCK, INC.
BETTEEN AROUNT 15, OOL 4 FEBRUARY 5, 2014. THE REPORT PREVAMED BY PROMITICANS LOCAL
A ROCK, INC. DATED FEBRUARY 17, 2014. REFLECTS THE MUSICALE OF THE SUBSULVANIAGE
INVESTIGATION. THE PROVINGATION AND RECOMMENDATIONS CONTINUED IN THE SECONT VAS USED IN
THE PREPARATION OF THESE PLANS. FLARES REFER TO THE CENTRICAL INVESTIGATION REPORT
BY FERNITIVANIA SOIL & ROCK, SOC. FOR AGENTORAL INVESTIGATION, AS DELEGIAL.

ENGINEER/SURVEYOR: NAVITUS ENGINEERING, INC. CTRUS S. KUMP, PE - PROJECT WANAGER/ENGINEER

ENVIRONMENTAL:

DFFICE (688) 662-4185 CELL: (540) 686-6747

ALLITAR ECOLOGY, LLC BYAN L WARD - ENVIRONMENTAL SCIENTIST (N66) 213-2866 CELL (304) 682-7477

GEOTECHNICAL:
FENNSYLVANIA BOIL & ROCK, INC.
CHURTOPHER W. EAMIOS-FROJECT ENGINEER
(412) 372-4000 CHLL (412) 509-5062

PROJECT CONTACTS:

OPERATOR: ANTERO RESOURCES CORPORATION 505 WHITE CAKE BLVD. BRIDGEFORT, WV 26130

ELI VACCAFR - ENVIRONMENTAL ENCINEER OFFICE: (304) 842-4068 CELL: (304) 476-9770 JOHN KANCAK - OPERATIONS SUPERINTENDENT

CELL: (405) 227-8344

ANTHONY SMITH - FIELD ENGINEER OFFICE (304) 842-4208 CELL: (304) 672-6196

WARK JOHNSON - SUNVEYING COOKSINATOR (304) 642-4152 CELL (304) 719-6449

DAVE CAVA - LAND AGENT (304) 641-5814

RESTRICTIONS NOTES:

1. THERE ARE NO PERENNAL STREAMS, VETLANDS, LAKER, FONDS, OR RESERVOIRS WITHIN 100 FERT OF THE VELL PLANS AND ATTEMPTS.

- R. THERE ARE NO NATURALLY PRODUCING TROUT STREAMS WITHIN 300 PEET OF THE WELL PADS
- 3. THERE ARE NO GROUNDWATER INTAKE OR PUBLIC WATER SUPPLY FACILITIES WITHIN 1000 FEET
- 4. THERE ARE NO APPARENT EXISTING WATER WELLS ON DEVELOPED SPHONGS WITHIN 250 FEET OF
- THERE ARE NO OCCUPIED DWELLING STRUCTURES WITHIN 825 FEET OF THE CENTER OF THE WILL PADS
- 8. THERE ARE NO AGRICULTURAL BUILDINGS LARGER THAN 2.500 SQUARE PEET WITHIN 605 FEET OF THE CENTER OF THE WELL PAID.

MALIGNES MEET STAND IN PLACE AND PUNCTIONAL UNITL ALL AREAS WITCH THE LIMIT OF DESTRUMENTS ARE CONFIDER TON PERMANENTY STANLINGS. MANTENANCE MEET NOTE OF INSPECTION OF ALL EDGESON AND SEDIMENT CONTROLS AFTER EACH MUNICIPE EVENT IN EXCESS OF ON AND OR A REVERLEY SEC.

- THE CONSTRUCTION RITE SHOULD BE STABILIZED AS SOON AS POSSIBLE AFTER COMPLETION. ESTABLISHMENT OF PAUL STABILIZATION MUST BE INTIMIED NO LATER THAN 7 DAYS AFTER REACHING INAL GRADE FINAL STABILIZATION MADE THAT ARE STABLESTED AND THAT EFFORT A PERMANENT VECTORITY COVER WITH A DENSITY OF YOX OR CREATER HAS BEST STABLESTED OF THAT THE SENS STABLESTED OF HAND COVER SHOULD BE SHOULD BE NOTATE AND REST STABLESTED OF HAND COVER OF THE STABLEST OF HE STABLEST OF THE STAB
- ALL PERMANENT SEDIMENT CONTROL MEASURES CAN BE REMOVED AFTER THE SITE IS PERMANENTLY STABILIZED AND APPROVAL IS RECEIVED FROM THE WYDEP
- ANY AREAS DISTURBED BY REMOVAL OF CONTROLS SHALL BE REPAIRED, STABILIZED, AND PERMANENTLY SECOND.

ROCK RUN & COFOR WELL PADS & WATER CONTAINMENT PAD

CENTER OF VATER CONTAINMENT TANK
LIMITURE 38 3008000 LONGTOND -80 0010044 (AND 81) Well API Numbers for Rock Ruin & Cofor AS-BUILT AND EROSION & SEDIMENT
17064796 17064994 17 CONTROL IMPROVEMENT PLAN

> CENTRAL & WEST UNION DISTRICTS, DODDRIDGE COUNTY, WEST VIRGINIA NUTTER FORK - MIDDLE ISLAND CREEK & ARNOLD CREEK WATERSHEDS

USGS 7.5 WEST UNION QUAD MAP (*) ROCK RUN WELL PAD WATER . COPOR WELL PAD CONTAINMENT PAD N SITE ENTRANCE



WVDEP OOG ACCEPTED AS-BUILT

VAL 429-2015

MISS Utility of West Virginia 1-800-245-4848 West Virginia State Law (Section XIV: Chapter 24-C) Requires that you call two business days before you dig in the state of West Virginia IT'S THE LAW!!

WVDOH COUNTY ROAD MAP



AS-BUILT CERTIFICATION:
THE DRAWINGE, CONSTRUCTION NOTTS, AND
REFFERENCE DIAGRAMS ATTACHED HERSTO HAVE
BEEN PREPARED IN ACCORDANCE WITH THE
EXET THERMAL CODE OF STATE RULES. DEVENOR
OF INVENIONALISTAL PROTECTION, CIFFICE OF OIL
AND CAS CORE 30-8.

TEST VERGINA STATE FLANE COCORTI ZONE, NADES
LEVATION BASED ON NAVDES
STABLEMED BY SURVEY GRADE

SHEET INDEX:

1 - COVER DESET

2 - COVER DESET

3 - COVERAL PLAN SHEET INDEX

4 - ACCESS RADA & STACING AREA "A" AS-BUILT PLAN

5 - ACCESS RADA & COVER TELL PAD AS-BUILT PLAN

6 - ACCESS RADA AS-BUILT PLAN AS-BUILT PLAN

7 - ACCESS RADA AS-BUILT PLAN AS-BUILT PLAN

8 - ACCESS RADA AS-BUILT PLAN AS-BUILT PLAN

8 - ACCESS RADA & ASTER CONTAINMENT PAD AS-BUILT PLAN

11 - COPOR TELL PLAN, ROCK RUN TELL PLAN, A VAITER CONTAINMENT PAD SECTIONS

ROCK RUN WELL PAD						
Programed Wed Horse	NAD 27	CHICAN VAN	UTW (METERS)	HAD ES LAS & Long		
Falors Hell	N 290873-44 6: 1627981.56	N 200408.52 E 1046543.38		LAT 39-18-17 8429 LONG 80-48-12 3/63		
Fotos Well		N 206008 37 E 1596530 38		LONG 80-48-52 4325		
Disvonian Unit SH	N 295873 14 8 1627961 57	A 2006KA 22 E 159652G 58		LONG 60-46-52-5556		
Describer Unit 2H	N 255872 99 E 1627981 52	PA ZONNICA GE E 15965/G 38		LONG 40-48-52 6008		
Devonian Unit til	N 296872 83 E 1627941 57	N ZERWOT RZ E. TSWISKO 38	N 4350634 61 E 515978 89	LAT 39-18-17 8311 LONG -50-48-52 8140		
Wentz Unit 191 (Dellact Wells Area 47-017-00109	N 255872 66 E 1627931 57	N 295907 76 E 1596490 39	N 4350834 73 E 515075.85	LONG -80-48-52 9411		
Wentz Unit 1H (Dritted West) - APUS 67-017-05476	N 395872.53 E 1637921.57		N 4350034 62 C 515973 80	LONG 4548-53 0665		
Terford Unit In (Deline Well) APIS 47-017-04402	H 295672.36 6 1627911.57	N 298967 46 E 1698470 39		LAT 39-18-17-6223 LONG-80-48-85-1964		
MACH Fred Electricism	1120 7.1733 6					

	COFOR	MELL PAS	The second	and the second
Proposed Well flores	NAC 27	NAD EX	OMETERAL!	NAD ET LIM &
Cuttack Unit 1H (Drived Well)	N 293842 73	N 293877.91	N 4350037 13	LAT 39-17-56 3563
	6 1632026 37	E 1800585.17	E 517233 64	LONG -89-48-00 479
Command Unit 200 (Delical West)	N 299832 93	N 202008 12	N 4350034 19	LAT 39 17 58 2598
	6 MIQUIDS 29	E 1900567 19	E 517234 31	LONG -80-48 00 450
Number Control (Collect West)	N 200023 14	N 207858.33	N 4350031.19	LAT 39-17-98 1933
	II MIDDIO 41	E 1000586.21	E 01/234 #/	LONG -80-48-00 423
Worker Dell 251 (Delling Weld)	N 291813 26	N 299948.80	N 4390028 21	LA139-17-56 bere
APR 47-917-(6503)	6 1612032 44	E 1600801 24	E 617235 64	LONG -80-48-00 les
More a	N 28 38G3 55 E 16S2G34 AS	N 293838.74 E 1903568.26	N 4350025 24 E 517238 31	LONG 40-4800 8W
Nove	N ZWITER TO	N 283K24 96	N KINDER 27	LAT 36-17-57-8738
Unit 20	E NEZXINE AS	E 10000W 28	E 117236 67	LONG -89-48-00 340
Orape	N 293783 97	# 29361815	N 4250019-20	LONG 404636 313
Dist 19	6 N32038 51	E 160068730	E 517207-54	
Grape	N 293774 17	N 293809 36	N 4250016-32	LAT 39-17-07 6609
Unit 29	E 1533040 53	E 1500599 33	E 517238-30	LONG -80-48-00 760
Rativery	N 2003764 38	N 293799.57	N 4250013.35	LAT 39-17-52 MH3
Unit 164	© HE32642 55	E 1503901.35	E 517236.87	1 CRNG -80-48-30 258
Rainer	N 20175A 50	N 203789 FT	N 43900-0.3*	LAT 29-17-57-4879
Unit 29	E NEDSAN 58	E 1800633 ST	E \$17236.54	1-CPG -85-49-30-730
Wed Pad Elevators	1189.4-1189.7			-

		Impacts to Douglas P. Farr, E YM T-E	
		Access Road "A" (218")	1.39
Attorney		Access Road "B" (V)	0.32
ROCK RUN & COFOR LIMITS OF DE	STURBANCE	Water Containment Paid	1.03
	AREA (AC)		0.09
Total Site		Total Affected Area	2.83
Access Road "A" (4,792')	16.40	Total Wooded Acres Distuted	2.65
Access Road 'B" (1,253)	6.30	Impacts to Marcha A. McConnell	TM 4-20
Access Road "C" (523)	1.36	Access Road "A" (756")	1.71
Staging Area "A"	1.39	Access Road 'B' (1.253)	5.79
Rock Pun Well Pad	6.81	Rinck Run Wet Part	0.53
Cefor Well Pad	3.70	Water Containment Pad	124
Water Containment Pad	2.27	Excess/Topsoil Material Stockgilles	0.50
Excess/Topsoil Material Stockpiles	11.56	Total Affected Area	9.77
Total Affected Area	50.15	Total Wooded Agres Distated	8.62
Total Wooded Acres Disturbed	43.52	Impacts to George D. Lambert	
Any acts to Constal Forest Resources	Co.TM#11-12	Access Road "B" (01)	0.25
Access Road "A" (2,356")	7.75	Rock Run Wet Pad	4.06
Access Road "C" (523)	1.36	Excess/Topspil Material Stockpiles	134
Staging Area "A"	139	Total Affected Area	7.65
Color Well Pad	3.70	Total Wooded Acres Distuted	6.32
Excess/Topsol Meternal Stockpiles	793	Impacts to Jonathan L. & Jeffery W. D.	
Total Affected Area	22.13	Rock Rup Wed Part	
Total Wooded Acres Disturbed	19.00		2.10
Impacts to Countal Forcet Reserved	Co THEEL	Total Affected Area	2.10
Access Road 'A' (1,450')	5.55	Total Wooded Acres Disturbed	2.10
Total Affected Area	5.55	Impacts to Jonathan L. & Jeffery W. D.	
Total Wooded Acres Distarted	4.72	Rock Fair Well Paid	0.12
TOTAL STREET, THE PARTY CANADAGE	716	Total Affected Ame	4.13

Total Mineried Wise	9.99	Rock Fair Wed Paid	0.12
Total Wooded Acres Distated	472	Total Affected Area	0.12
		Total Wooded Acres Distirted	0.11
FINAL GRADING OF THE DISTU	REED AREA AS OF	FLECTS FIELD DATA COLLECTED RELAT- JANUARY 15, 2015. NAVITUS ENGINEE SITE AFTER THE ABOVE MENTIONED D	SING IS NOT
2. THE EXISTING CONTAINMENT E		WILL PAD SHALL BE REPAIRED AS NO	CESSARY TO

THE EXISTING EGRESSES TO THE WELL PAD SHALL HAVE THE MOUNTAINE BERKES REPAIRED AS NECESSARY TO ENSURE 100% CONTAINMENT OF ALL FLUIDS PRIOR TO DRILLING OPERATIONS.

S EERING ENGINE




RUN & COFOR

COVER WELL PADS & V ROCE



DATE 02/18/2015 SCALE AS SHOWN SHEET 1 OF 11

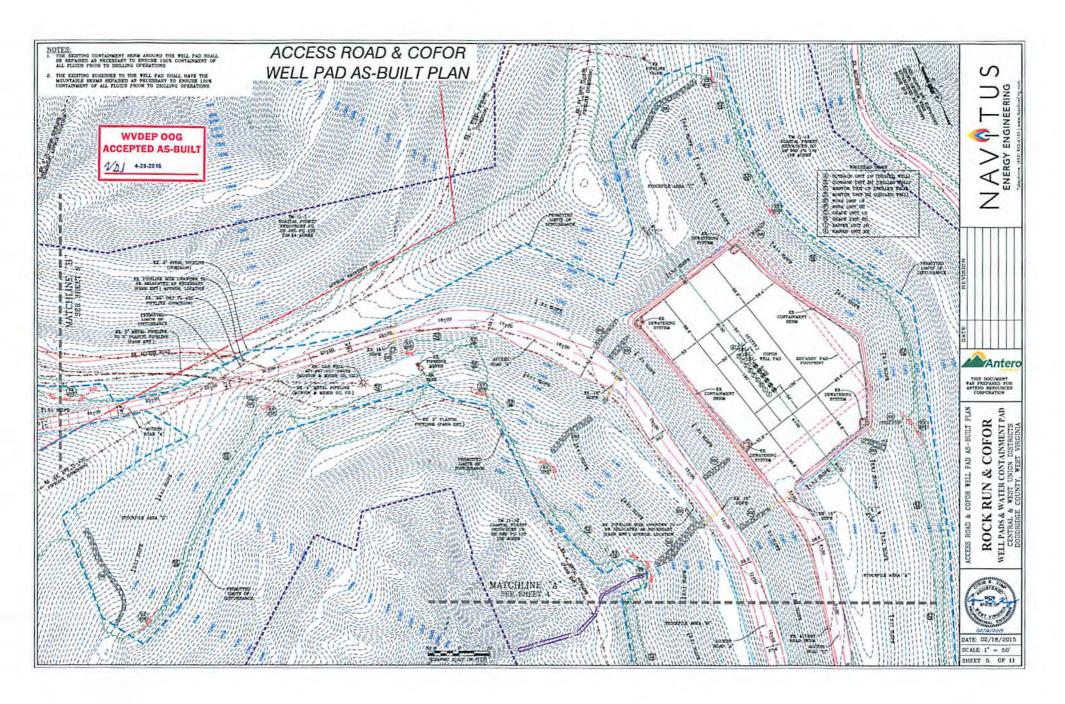

LOCATION COORDINATES:

ACCESS ROAD ENTRANCE
LATITUDE: 39.296222 LONGITUDE: -80.799541 (NAD 83)
N 4349668.65 E 517285.49 (UTM ZONE 17 METERS)

CENTROID OF COFOR WELL PAD LATITUDE: 39.299423 LONGITUDE: -80.800055 (NAD 83) N 4350023.78 E 517240.30 (UTM ZONE 17 METERS)

CENTER OF WATER CONTAINMENT TANK LATITUDE: 39.303990 LONGITUDE: -80.810564 (NAD 83) N 4350628.67 E 516333.18 (UTM ZONE 17 METERS)

CENTROID OF ROCK RUN WELL PAD LATITUDE: 39.304923 LONGITUDE: -80.814648 (NAD 63) N 4350631.48 E 515980.84 (UTM ZONE 17 METERS)

GENERAL DESCRIPTION:

THE ACCESS ROAD(S), WELL PADS, AND WATER CONTAINMENT PAD HAVE BEEN CONSTRUCTED TO AID IN THE DEVELOPMENT OF INDIVIDUAL MARCELLUS SHALE GAS WELLS.

FLOODPLAIN NOTES:

THE SITE IS LOCATED IN FLOODZONE "X" PER FEMA FLOOD MAPS #54017C0115C & #54017C0120C

ENVIRONMENTAL NOTES:

WETLAND DELINEATIONS WERE PERFORMED BETWEEN OCTOBER, 2013 & FEBRUARY, 2014 BY ALISTAR ECOLOGY, ILC TO REVIEW THE SITE FOR WATERS AND WETLANDS THAT ARE MOST LIKELY WITHIN THE REGULATORY FURVIEW OF THE U.S. ARMY CORPS OF ENGINEERS (USACE) AND/OR THE WEST VIRGOLIA DEPARTMENT OF ENVIRONMENTAL PROTECTION (WYDEP). THE FEBRUARY OS, 2013 ROCK RUN & COFOR JURISDICTIONAL STREAMS & WETLANDS MAPS WERE PREPARED BY ALISTAR ECOLOGY, ILC AND SUMMARIZE THE RESULTS OF THE FIELD DELINEATION. THE MAPS DO NOT, IN ANY WAY, REPRESENT A JURISDICTIONAL DETERMINATION OF THE LANDWARD LIMITS OF WATERS AND WETLANDS WHICH MAY BE REGULATED BY THE

ROCK RUN & COFOR EPHEMERAL STREAM IMPACT (LINEAR FEET)				
Stream and Impact Cause	FIII (LF)	Culvert (LF)	Inlets/Outlets Structures (LF)	Total Impact (LF)
Ephemeral Stream 04 (Access Road "A")	2	N/A	N/A	2
Ephemeral Stream 05 (Access Road "A")	0	52	14	66

GEOTECHNICAL NOTES:
A GEOTECHNICAL INVESTIGATION OF THE SITE WAS PERFORMED BY PENNSYLVANIA SOIL & ROCK, INC.
BETWEEN JANUARY 15, 2014 & FEBRUARY 5, 2014. THE REPORT PREPARED BY PENNSYLVANIA SOIL
& ROCK, INC. DATED FEBRUARY 17, 2014, REFLECTS THE RESULTS OF THE SUBSURFACE
INVESTIGATION. THE INFORMATION AND RECOMMENDATIONS CONTAINED IN THIS REPORT WAS USED IN
THE PREPARATION OF THESE PLANS. PLEASE REFER TO THE GEOTECHNICAL INVESTIGATION REPORT
BY PENNSYLVANIA SOIL & ROCK, INC. FOR ADDITIONAL INFORMATION, AS NEEDED.

ENGINEER/SURVEYOR: NAVITUS ENGINEERING, INC. CYRUS S. KUMP, PE - PROJECT MANAGER/ENGINEER

OFFICE: (888) 662-4185 CELL: (540) 686-6747

ENVIRONMENTAL: ALISTAR ECOLOGY, LLC RYAN L WARD - ENVIRONMENTAL SCIENTIST (866) 213-2866 CELL: (304) 692-7477

GEOTECHNICAL: PENNSYLVANIA SOIL & ROCK, INC. CHRISTOPHER W. SAMIOS-PROJECT ENGINEER

(412) 372-4000 CELL: (412) 589-0662

PROJECT CONTACTS:

OPERATOR:

OPERATOR: ANTERO RESOURCES CORPORATION 535 WHITE OAXS BLVD. BRIDGEPORT, W 26930 PHONE: (304) 842-4100 FAX: (504) 842-4102

ELI WAGONER - ENVIRONMENTAL ENGINEER OFFICE: (304) 842-4068 CELL: (304) 476-9770

JOHN KAWCAK - OPERATIONS SUPERINTENDENT CELL: (817) 368-1553

AARON KUNZLER - CONSTRUCTION SUPERVISOR CELL: (405) 227-8344

ANTHONY SMITH - FIELD ENGINEER OFFICE: (304) 842-4208 CELL: (304) 673-6196

MARK JOHNSON - SURVEYING COORDINATOR (304) 842-4162 CELL: (304) 719-6449

DAVE CAVA - LAND AGENT (304) 841-5814

RESTRICTIONS NOTES:


- THERE ARE NO PERENNIAL STREAMS, WETLANDS, LAKES, PONDS, OR RESERVOIRS WITHIN 100 FEET OF THE WELL PADS AND LOD.
- THERE ARE NO NATURALLY PRODUCING TROUT STREAMS WITHIN 300 FEET OF THE WELL PADS
- THERE ARE NO GROUNDWATER INTAKE OR PUBLIC WATER SUPPLY FACILITIES WITHIN 1000 FEET OF THE WELL PADS AND LOD. THERE ARE NO APPARENT EXISTING WATER WELLS OR DEVELOPED SPRINGS WITHIN 250 FEET OF
- THE WELL(S) BEING DRILLED.
- THERE ARE NO OCCUPIED DWELLING STRUCTURES WITHIN 625 FEET OF THE CENTER OF THE
- THERE ARE NO AGRICULTURAL BUILDINGS LARGER THAN 2,500 SQUARE FEET WITHIN 625 FEET OF THE CENTER OF THE WELL PADS.

- ALL BMP'S MUST REMAIN IN PLACE AND FUNCTIONAL UNTIL ALL AREAS WITHIN THE LIMIT OF DISTURBANCE ARE COMPLETE AND PERMANENTLY STABILIZED. MAINTENANCE MUST INCLUDE INSPECTION OF ALL EROSION AND SEDIMENT CONTROLS AFTER EACH RUNOFF EVENT IN EXCESS OF 0.6° AND ON A BIWEEKLY BASIS.
- THE CONSTRUCTION SITE SHOULD BE STABILIZED AS SOON AS POSSIBLE AFTER COMPLETION. ESTABLISHMENT OF FINAL STABILIZATION MUST BE INITIATED NO LATER THAN 7 DAYS AFTER REACHING FINAL GRADE. FINAL STABILIZATION MEANS THAT ALL SOIL—DISTURBING ACTIVITIES ARE COMPLETED, AND THAT EITHER A PERMANENT VEGETATIVE COVER WITH A DENSITY OF 70% OR GREATER HAS BEEN ESTABLISHED OR THAT THE SURFACE HAS BEEN STABILIZED BY HARD COVER SUCH AS PAVEMENT OR BUILDINGS. IT SHOULD BE NOTED THAT THE 70% REQUIREMENT REFERS TO THE TOTAL AREA VEGETATED AND NOT JUST A PERCENT OF THE SITE.
- ALL PERMANENT SEDIMENT CONTROL MEASURES CAN BE REMOVED AFTER THE SITE IS PERMANENTLY STABILIZED AND APPROVAL IS RECEIVED FROM THE WYDEP.
- ANY AREAS DISTURBED BY REMOVAL OF CONTROLS SHALL BE REPAIRED, STABILIZED, AND PERMANENTLY SEZDED.

ROCK RUN & (WELL PADS & WATER CO AS-BUILT AND EROSION CONTROL IMPROVEN

CENTRAL & WEST UNION DISTRICTS, DODDRIL NUTTER FORK - MIDDLE ISLAND CREEK & AR

USGS 7.5 WEST UNION Q

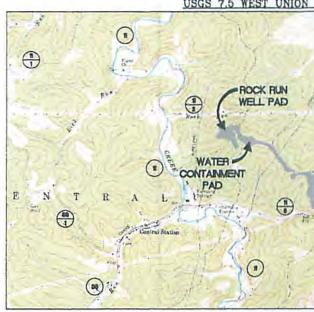

SCALE:

WEST VIRGINIA COUNTY MAP



MISS Utility of West Virginia 1-800-245-4848 West Virginia State Law (Section XIV: Chapter 24-C) Requires that you call two business days before you dig in the state of West Virginia. IT'S THE LAW!!