

WW-7
8-30-06



West Virginia Department of Environmental Protection
Office of Oil and Gas

WELL LOCATION FORM: GPS

API: 47-017-72516 WELL NO.: MW-01

FARM NAME: MarkWest Liberty Midstream & Resources LLC

RESPONSIBLE PARTY NAME: Stalnaker Energy Corporation

COUNTY: Doddridge DISTRICT: West Union

QUADRANGLE: Smithburg

SURFACE OWNER: MarkWest Liberty Midstream & Resources LLC

ROYALTY OWNER: _____

UTM GPS NORTHING: 4347995.21m

UTM GPS EASTING: 523413.73m GPS ELEVATION: 281.3m (923')

The Responsible Party named above has chosen to submit GPS coordinates in lieu of preparing a new well location plat for a plugging permit or assigned API number on the above well. The Office of Oil and Gas will not accept GPS coordinates that do not meet the following requirements:

1. Datum: NAD 1983, Zone: 17 North, Coordinate Units: meters, Altitude: height above mean sea level (MSL) – meters.
2. Accuracy to Datum – 3.05 meters
3. Data Collection Method:

Survey grade GPS _____: Post Processed Differential _____
Real-Time Differential _____

Mapping Grade GPS X: Post Processed Differential _____
Real-Time Differential X


4. Letter size copy of the topography map showing the well location.

I the undersigned, hereby certify this data is correct to the best of my knowledge and belief and shows all the information required by law and the regulations issued and prescribed by the Office of Oil and Gas.

[Signature]
Signature


VICE President
Title

07-11-18
Date

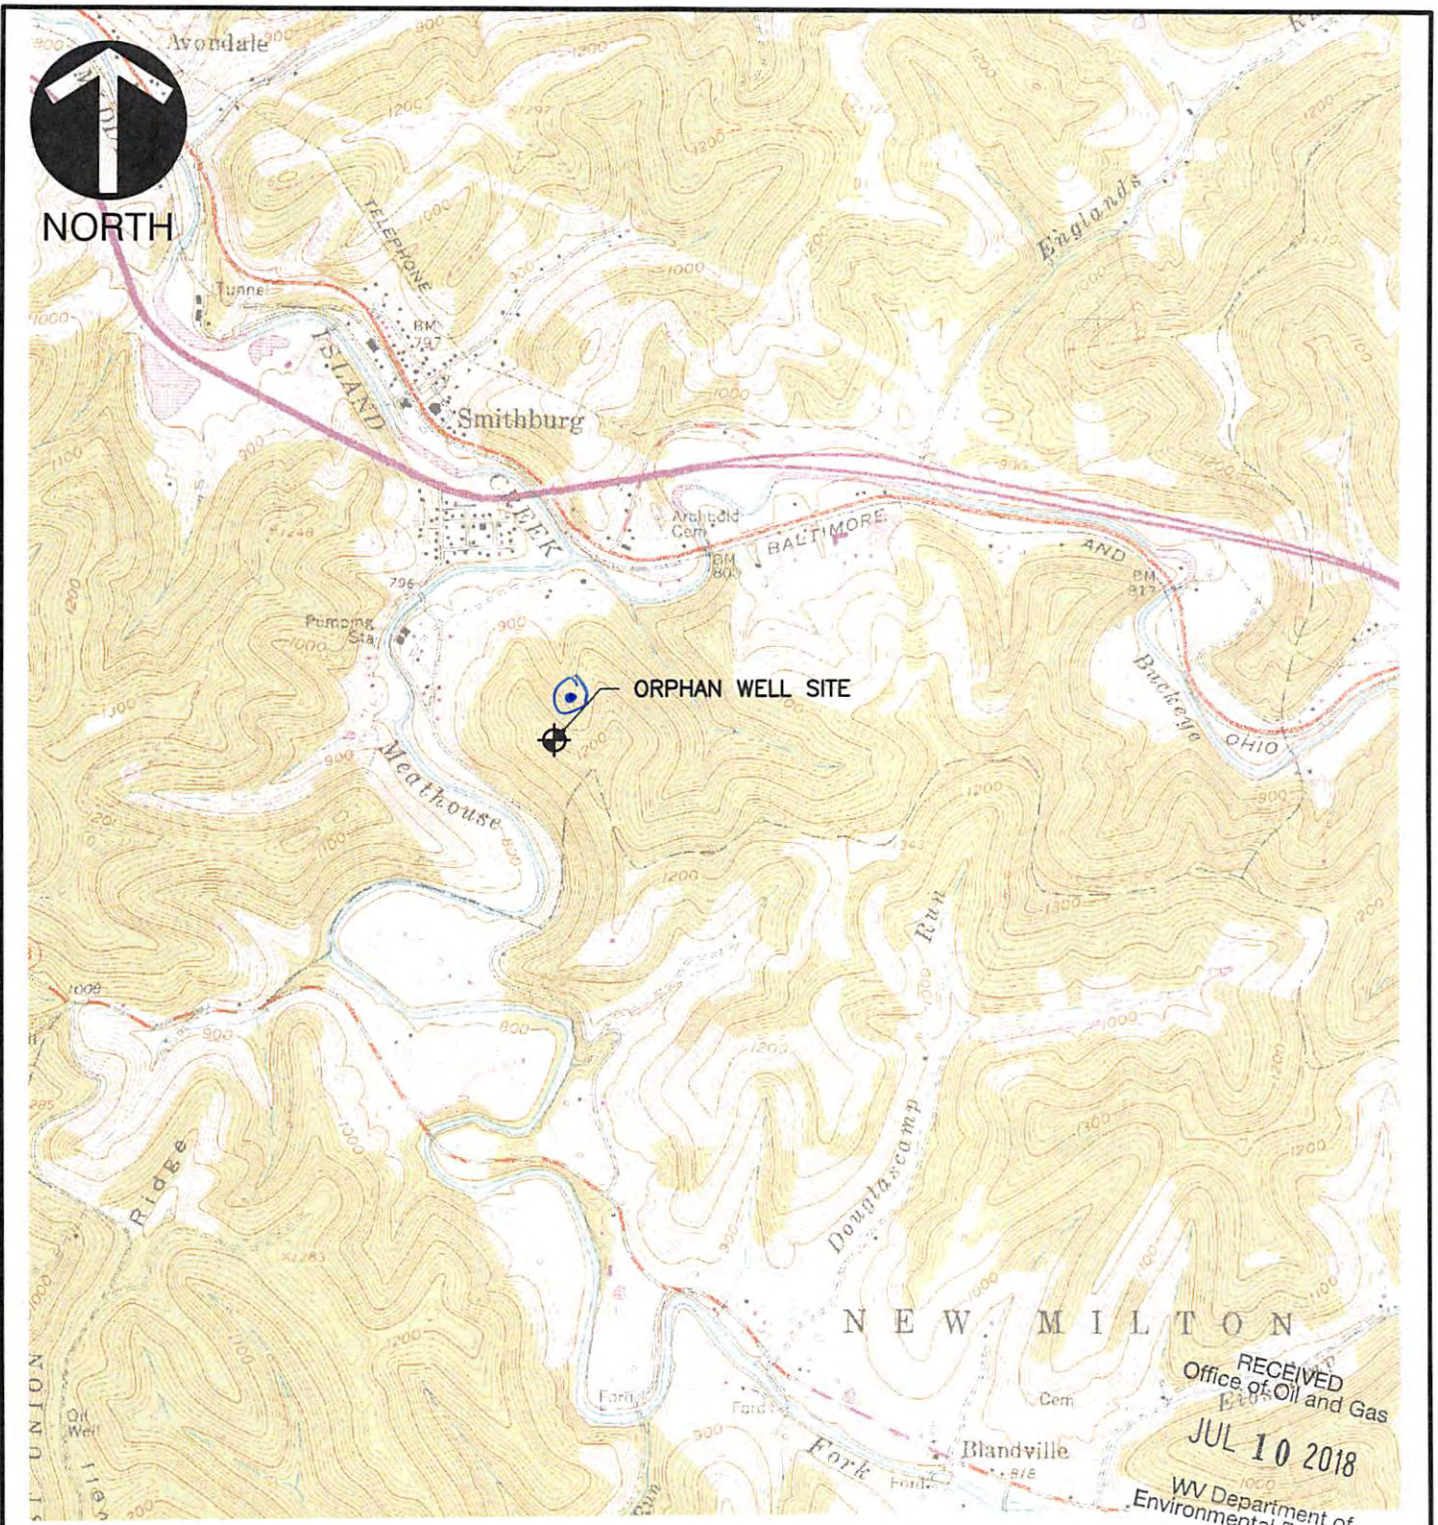

REFERENCE

1. USGS 7.5 MIN. TOPOGRAPHIC QUADRANGLE SMITHBURG, WV, DATED 1961. PHOTOREVISED 1976.

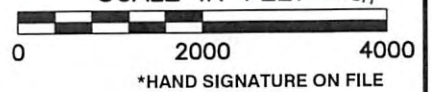

Civil & Environmental Consultants, Inc.

333 Baldwin Road - Pittsburgh, PA 15205
 412-429-2324 · 800-365-2324
 www.cecinc.com

SHERWOOD MIDSTREAM LLC
 SMITHBURG NATURAL GAS
 PROCESSING FACILITY
 DODDRIDGE COUNTY, WEST VIRGINIA

ORPHAN WELL LOCATION MAP

DRAWN BY:	KLP	CHECKED BY:	RPC	APPROVED BY:	*RPC	FIGURE NO.:	SP17
DATE:	6/25/2018	DWG SCALE:	1"=2,000'	PROJECT NO.:	130-359.0209		

P:\2013\130-359\CADD\DWG\TASK_0209\130359.0209-CV01-SP17.dwg[SP17] LS:(25/06/2018 - kpoole) - LP: 6/25/2018 11:16 AM