

Latitude 39°25' 00"

+

39° 07' 00"

Longitude

Topo Location

7.5' Loc. 0.645 15' Loc. 0.645
1.09W (calc.) 1.09

Company _____

Farm Wm. Ash.

15' Quad Center Point we
(sec.)

7.5' Quad Center Point

District McClellan

WELL LOCATION PLAT


County 017 Permit 30006

ASH, WM., HEIRS, NO. 8.

Dod-6-A.

By Murphy Oil Co.

McClellan Dist.

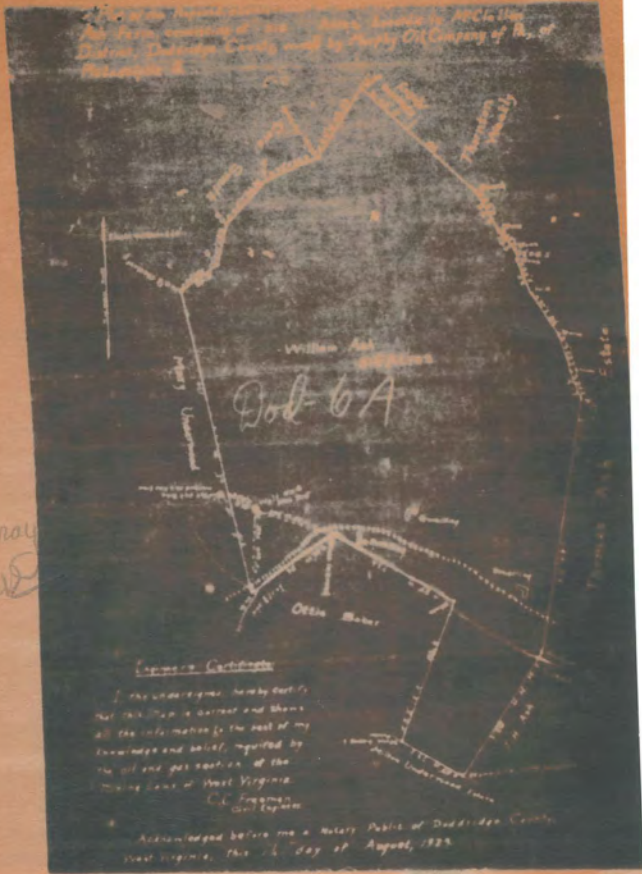

McElroy
Creed

Exhibit Certificate
I, the undersigned, hereby certify
that this plan is correct and shows
all the information to the best of my
knowledge and belief, required by
the oil and gas section of the
Mining Laws of West Virginia.
C. C. Freeman,
Civil Engineer

Acknowledged before me a Notary Public of Doddridge County,
West Virginia, this 14 day of August, 1925.

