

Latitude 39° 25' 00"

108.4588

Longitude

75'
+
8A

Topo Location

7.5' Loc. 2.09S 15' Loc. 2.09S
2.02W (calc.) 4.25W

Company South Penn Oil
Farm John. A Davis
15' Quad Centerpoint C
(sec.)
7.5' Quad Center Point
District McClellan

WELL LOCATION PLAT

County 017 Permit 30008

DAVIS, JOHN A., NO. 6.

Dod-8-A.

By South Penn Oil Co.

McClellan Dist.

017-84

John A. Davis well No. 6 - McStellan District, Sedgwick County, K. Va.

COMPLETION DATA SHEET NO. 2
FORMATION RECORD

DATE	COLOR	CHARACTER	DIG. GAN OF WATER	TOP	BOTTOM	THICK- NESS	TOTAL DEPTH	RE- MARKS
						14		
						None		
				945	960			
				1405	1455			
				1640	1671			
				1690	1750			
				1925	1945			
				2055	2075			
				2075	2135			
				2175	2195			
				2195	2215			
				2195	2170			
			160	2000	2000			
				2000	2000			
							2100	

Well was not shot at _____ feet; well was shot at _____ feet.


Salt / fresh water at _____ feet; salt / fresh water at _____ feet.

Well was _____ producing hole.

SOUTH-WEST OIL COMPANY

John A. Davis well No. 6 - McStellan District, - Sedgwick County
Lease No. 9816 - 151 acres
On Waters of McElroy Creek
Elevation 1133
Scale 1" = 800'

3 4-5 W 3

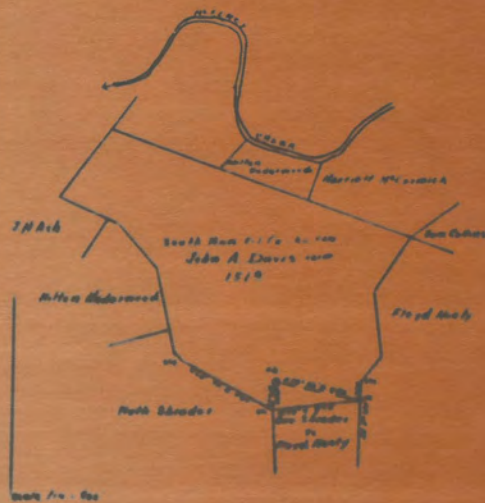

I, the undersigned hereby certify that this map is true and correct and shows all the information required by Oil & Gas Law, acts of 1905.

James J. [Signature]

**AFFIDAVIT IN TRIPPLICATE TO TIME AND MANNER OF
PLUGGING AND FILLING WELL**
WEST VIRGINIA DEPARTMENT OF MINES
OIL AND GAS SECTION

Sommers, Martin & Deakworth South Penn Oil Company
West Union, W. Va. P. O. Drawer 1888, Pittsburgh, Pa.
October 29, 1929
WELL AND LOCATION
McClallen District
Petersburg County
Well No. 6
John A. Davis Foreman

AFFIDAVIT

STATE OF WEST VIRGINIA,
County of Logan)
I, P. H. Imberger and L. B. McCall
being first duly sworn according to law depose and say that they are experienced in the work of plugging
and filling oil and gas wells and were employed by South Penn Oil Company, well foreman,
and participated in the work of plugging and filling the above well, that said work was commenced on the
21th day of October, 1929, and that the well was plugged and filled in
the following manner:

Manner in which well was plugged:

Filled with	From	To	Flng	Size	Kind	Depth Set
Cement	2190	2200	let.	3 3/16	Wood	2200
" "	2200	2175	"	"	"	2175
" "	2175	2140	"	3 3/8	"	2140
" "	2140	2100	"	"	"	2100

Manner in which well was plugged:

FILLED TO TOP OF SURFACE WITH NATIVE SAND
TOOLS RUN ON ALL FILLINGS.

Description of cement:

DEPARTMENT
OF MINES
NOV 15 1929

and that the work of plugging and filling said well was completed on the 29th day of October,
1929.

And further deposes that not.

Sworn to and subscribed before me this 29th day of October, 1929.

My Commission expires:

P. H. Imberger
L. B. McCall
Notary Public

WEST VIRGINIA DEPARTMENT OF MINES
OIL AND GAS SECTION
PRELIMINARY DATA SHEET NO. 1

File No. _____
South Penn Oil Company Company, of Pittsburgh, Pa.
on the John A. Davis Perm
containing _____ acres. Location
McClallen District, in Petersburg County, West Va.
The surface of the above land is owned by _____
of _____
Mineral rights are owned by John A. Davis
The oil and gas interests are held under _____
the above named company, and this well is drilled under _____
No. _____ issued to the West Virginia Department of Mines, and
has location _____
Elevation of surface at top of well, _____
The number of feet of the strata listed _____
_____ feet _____
100 feet 10" size, var. 2100 feet _____
100 feet 6" size, var. 2040 feet _____
210 feet 3 3/8" size, var. _____
_____ feet _____
_____ ft. casing set _____ feet _____
_____ ft. casing perforated at _____ feet _____
Coal was encountered at _____ feet, thickness _____ and at
_____ feet; thickness _____ and at
_____ inches.
Tools were used as follows: 10000 details

September 10, 1929. W.V.A.