

Latitude 39° 17' 30"

75'
+

80° 45' 00"

Longitude

Topo Location

7.5' Loc. 0.295 15' Loc. 3.175
0.64W (calc.) 0.64W

Company _____

Farm Charles Cheuvront Hrs

15' Quad West Union SE
(sec.)

7.5' Quad West Union

District West Union

WELL LOCATION PLAT

County 017 Permit 30039


Completion Data Sheet
 NO. 2
 FORMATION RECORD

Time	Depth	Formation	Remarks
10:00	100	Shale	
10:05	105	Shale	
10:10	110	Shale	
10:15	115	Shale	
10:20	120	Shale	
10:25	125	Shale	
10:30	130	Shale	
10:35	135	Shale	
10:40	140	Shale	
10:45	145	Shale	
10:50	150	Shale	
10:55	155	Shale	
11:00	160	Shale	
11:05	165	Shale	
11:10	170	Shale	
11:15	175	Shale	
11:20	180	Shale	
11:25	185	Shale	
11:30	190	Shale	
11:35	195	Shale	
11:40	200	Shale	
11:45	205	Shale	
11:50	210	Shale	
11:55	215	Shale	
12:00	220	Shale	

Company: *Union Trust Bldg., Pittsburgh, Pa.*
 Address: _____
 Date: _____
 Driller: *Henry H. Jones*
 Supervisor: _____
 Log Book No. _____



Tucker Hollow
J.B. Maxwell

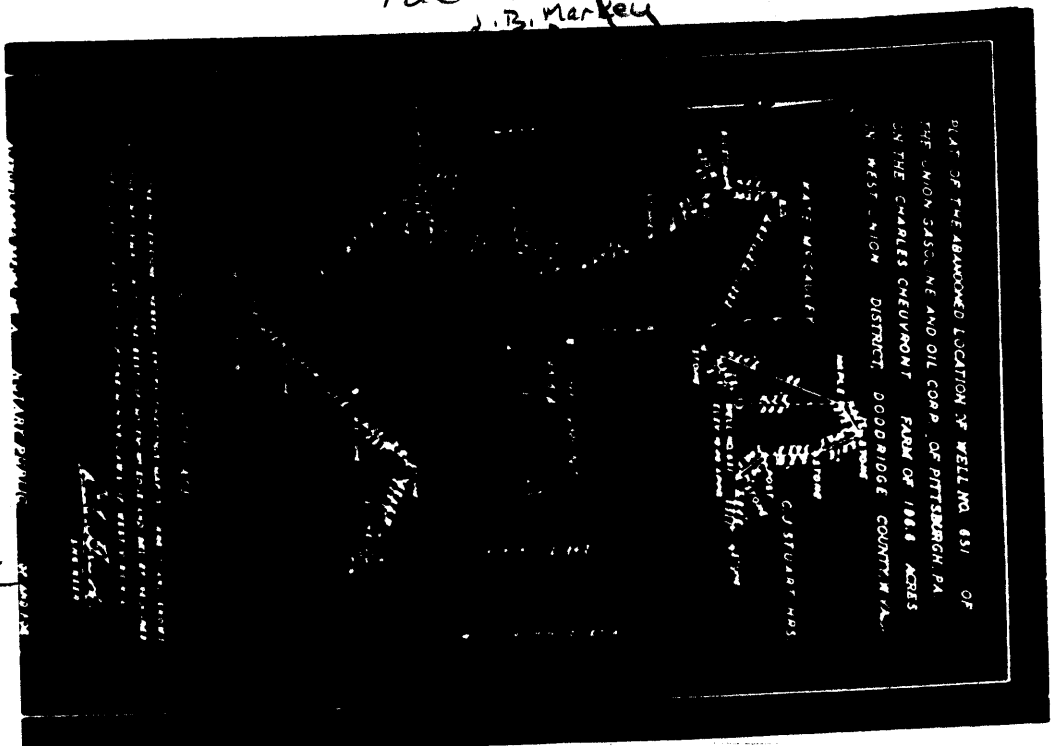

Louis Maxwell

WD GRIBBLE

651
Charles Chevront
196.6 acres

34

NOW. 30039

West Union District, Doddridge County, W. Va.
 By Union Gasoline & Oil Corp., 800 Union Trust Bldg., Pittsburgh, Pa.
 On 196.6 acres, surface owned by Charles and Harriett Cheuvront,
 West Union Bank, West Union, W. Va., and mineral rights by
 Union Gasoline & Oil Corp., Pittsburgh, Pa.
 Drilled prior to June 1, 1929.
 Elevation, 1040' L.
 14 x 13 conductor; 8 $\frac{1}{4}$ " casing, 1131'; 6-5/8", 1949'.
 Coal was encountered at 580-583'.
 Abandonment reported to Dept. of Mines July 8, 1931.

	Top.	Bottom.	Thickness.
Pittsburgh Coal	580	- 583	3
Murphy Sand	775	- 788	13
Little Dunkard Sand	1026	- 1057	31
Big Dunkard Sand	1131	- 1196	65
Gas Sand	1286	- 1343	57
First Salt Sand	1454	- 1500	46
Second Salt Sand	1538	- 1618	80
Third Salt Sand	1700	- 1727	27
Maxton Sand	1853	- 1869	16
Little Lime	1882	- 1898	16
Pencil Cave	1898	- 1905	7
Blue Monday Sand	1905	- 1920	15
Big Lime	1923	- 1992	69
Big Injun Sand	1992	- 2081	89
Gantz Sand	2225	- 2330	105
Lime shells	2618	- 2630	12
Gordon Stray Sand	2636	- 2641	5
Gordon Sand	2652	- 2653	1
Slate and shells	2763	- 2812	49
Slate	2812	- 2838	26
Slate and shells, to bottom	2838	- 2886	48

