

Latitude 39° 17' 30"

110° E, 85° S

Longitude

75°
+

Topo Location

7.5' Loc. 2.825 15' Loc. 5.705
0.25W (calc.) 2.48W

Company _____

Farm L. Smith #1

15' Quad West Union SC
(sec.)

7.5' Quad Pennsboro

District Central

WELL LOCATION PLAT

County O17 Permit 30081

Central District, Doddridge County, W. Va.

By J. C. Townsell, Parkersburg, W. Va.

On 6-3/4 acres.

Dodd. 81A

Elevation, 872' L.

13" conductor, 16'; 6-5/8" casing, 2010'.

No coal was encountered.

Abandonment reported to Dept. of Mines May 9, 1934.

Well was shot at 2107'.


Salt water at 1527'.

Producing hole.

	Top.	Bottom.	Thickness.
Little Dunkard Sand	1110	- 1145	35
Big Dunkard Sand	1225	- 1245	20
Gas Sand	1284	- 1345	61
First Salt Sand (water)	1538	- 1624	86
Second Salt Sand	1700	- 1813	113
Third Salt Sand	1920	- 1925	5
Maxton Sand	1952	- 1970	18
Little Lime	1970	- 1985	15
Pencil Cave	2000	- 2002	2
Big Injun Sand (gas and oil)	2001	- 2112	11
Total depth		2131	

COLLECTION DATA SHEET

FORMATION RECORD

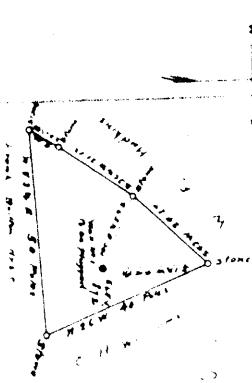

Plot of the location of Mr. Tammel. Spots to be measured.
or ~~and~~ corners. Wm. on the L. & the Smith farm. intersecting or 6th rd.
on Lagoon. Rm. Central District. DuPage County, Ill.

.....

*I, the undersigned, now by Certificate that this map is correctly
and shows all the information at the date of my knowledge and
belief, received by the O.I. and generation of the Mining laws*

Commissioned to form a History of DuPage County, 1836 or 1837. By Gideon Doolittle, Historian. My commission expires in May or June. 1840

Commissioned to file a Notice of Damage
County, this 9 day of May 1944
By G. Lyle Tolson Harry Tolson
My commission expires on the 6 day of May. 1940

