


Agave *arborescens* *gigantea*
Succulent plant growing 10-15 ft. tall, with a cluster of long, narrow, pointed leaves at the top of a thick stem.

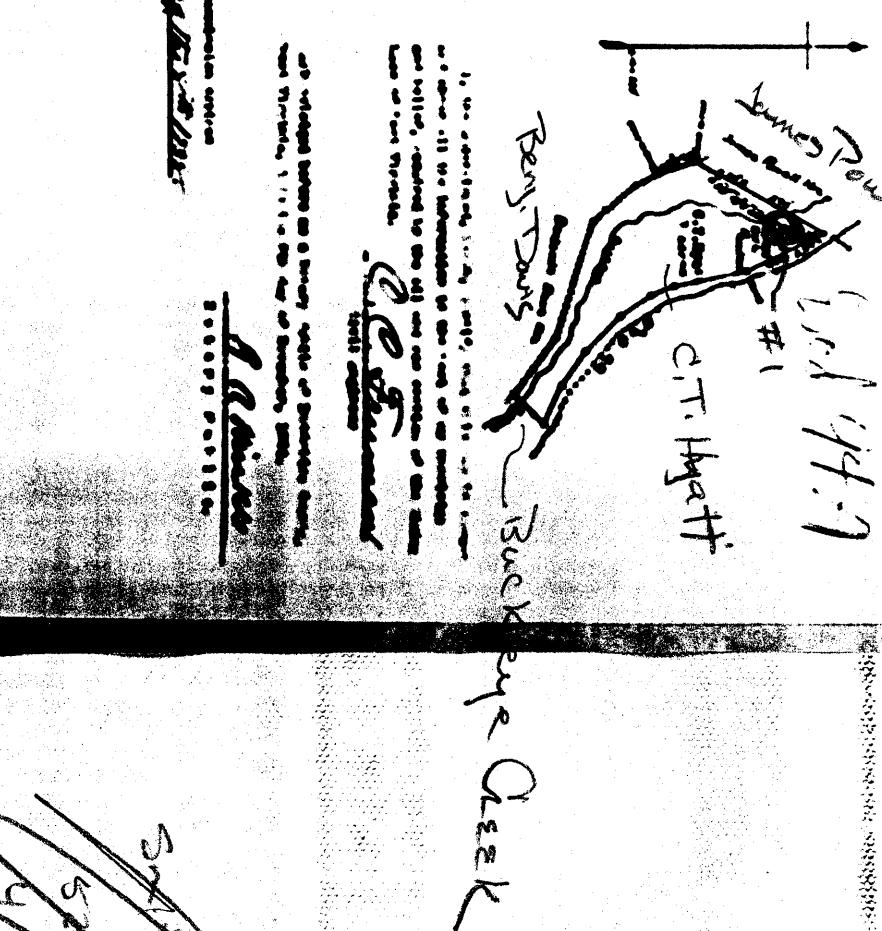

Can not
locate
near
524 0004
434700N

Did - 94-A

Grant District, Doddridge County, W. Va.
 By Lima Gas Co., Charleston, W. Va. (Clint Litton, Pres.)
 On 9 acres, surface owned by C. T. Hyatt, West Union, W. Va.
 Elevation, 855' B.
 10" casing, 323'; 6-5/8", 1640'.
 Coal was encountered at 31-35, 612-616, and 812-816'.
 Abandonment reported to Dept. of Mines Nov. 26, 1934.

Note: This record was not obtained from the original record book.
 It does not appear to be very correct in respect to the coal
 seams marked (?). This is the only well in this locality in
 which these seams are logged, and it is very doubtful if they
 were present. In the work order we have assumed they were
 present, but would like for the Department to change this if
 they think it probable these coal seams are not present.
 Producing hole.

	Top.	Bottom.
Coal, Mapletown (Sewickley) ?	31	35
Lime and sand	332	394
Coal (?)	612	616
Lime	616	685
Little Dunkard Sand	692	704
Coal (?)	812	816
Big Dunkard Sand	830	870
Lime	945	1018
Gas Sand	1050	1080
1st Salt Sand	1125	1240
3rd Salt Sand	1355	1420
Lime	1435	1505
Pink rock and lime	1505	1555
Little Lime	1584	1600
Pencil Cave	1600	1632
Big Lime	1632	1689
Big Injun Sand	1689	1795
Total depth		1825

WEST VIRGINIA DEPARTMENT OF MINES

WEST VIRGINIA DEPARTMENT OF MINES

PRELIMINARY DATA SHEET NO. 1

OPT. AND DAS DIVISION

Old Murphy "Top
Character, P. M.
August 9, 1938. 10.
Well and location
Dedication Day

110

卷之三

therefore only more convincing to her purpose and say that they are ~~excellent~~ ~~good~~ ~~useful~~ ~~books~~ ~~of~~ ~~learning~~.

He had a very bad cold, but he got well again, and then he and we played and had fun.

Lower to which end was placed. Determined from 6 to 11 and filled to bottom

Brick walls - wall number and operator shown on marker.

卷之三

And Justice Prevails

~~APRIL 24, 1960~~