

Latitude 39° 22' 30"

80° 31' 30"

Longitude

75
+

Topo Location

7.5' Loc. 1.095 15' Loc. 3.975
1.390 (calc.) 3.420

Company (483)

Farm V.L. Highland #4

15' Quad Centropunt C
(sec.)

7.5' Quad Smithburg

District McClellan

WELL LOCATION PLAT


County 017 Permit 30097

McClellan District, Doddridge County, W. Va.
By Carnegie Natural Gas Co., 962 Frick Bldg. Annex, Pittsburgh, Pa.
On 432 acres, surface and mineral rights owned by V. L. Highland
Heirs, Clarksburg, W. Va. Lease No. E-8462-15.
Drilled prior to June 1, 1929.
Elevation, 1155' B.
10" casing, 321'; 8 $\frac{1}{4}$ " 1240'; 6-5/8" 1932'; 2" tubing, 1988'.
Coal was encountered at 610' and 787-790'.
Abandonment reported to Dept. of Mines Jan. 28, 1935.
Well was shot at 1968-1978'.
Water not recorded.
Producing hole.

	Top.	Bottom.	Thickness.
Mapletown (Sewickley)?Coal	610		
Pittsburgh Coal	787 -	790	3
Little Dunkard Sand	1160 -	1170	10
Big Dunkard Sand	1240 -	1290	50
Gas Sand	1495 -	1515	20
1st Salt Sand	1535 -	1575	40
2nd Salt Sand	1680 -	1735	55
Maxton Sand (show of gas, 1970'; oil, 1974')	1910 -	1980	70
Total depth		1988	

NO. 2
 FORMATION RECORD

Station	Time	Remarks	Depth	Temperature	Direction	Speed	Current	Wind	Weather	State	Country
100	100										
200	200										
300	300										
400	400										
500	500										
600	600										
700	700										
800	800										
900	900										
1000	1000										

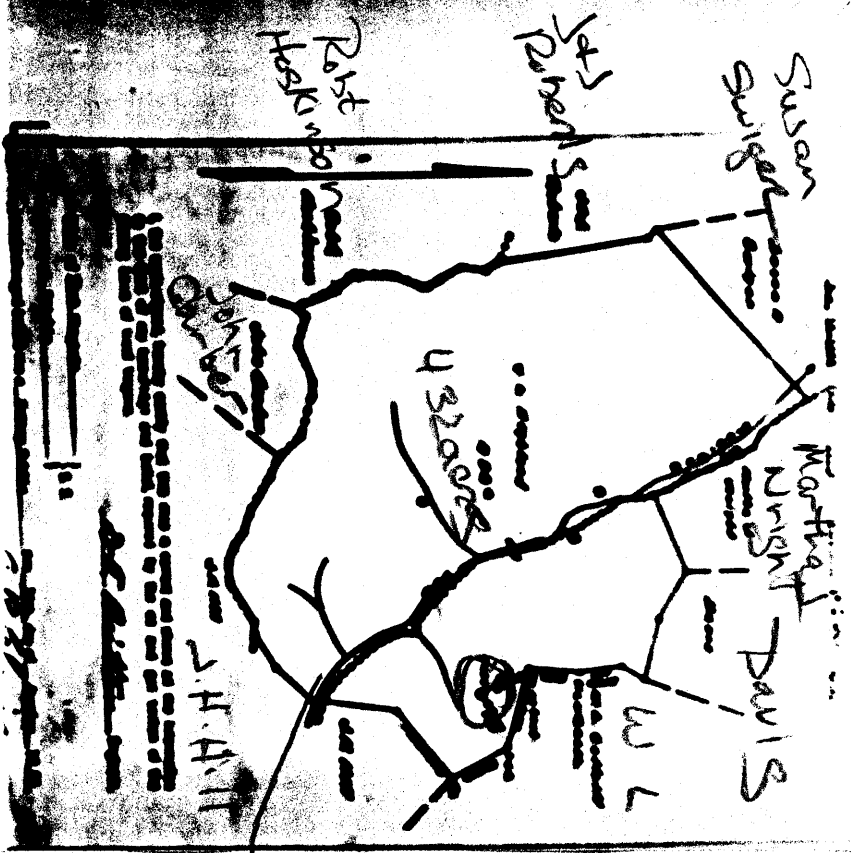

017-97A

Coteau 11
 #4 (483)

Pissins Run

