

Latitude 39°20' 00"

+ 75'

80°32'30"

Longitude

Topo Location

7.5' Loc. 0.53S 15' Loc. 0.53S
1.65W (calc.) 13.88W

Company C-1170

Farm E. G. Smith 1

15' Quad Centiput SE
(sec.)

7.5' Quad Salem

District McClellan

WELL LOCATION PLAT

County 017 Permit 30110

FORMATION RECORD


Name	Color	Character	Q.M. (lbs or Water)	Top	Bottom	Thickness	Total Depth	Remarks
Pittsburgh Coal				1180	1187	7'		
LITTLE SAND				1080	1080	10'		
BIG DUMMERY SAND				1004	1008	18'		
FIRST BALL SAND		Water - 1000		1008	1000	68'		
SECOND BALL SAND				9009	9000	41'		
THIRD BALL SAND				9007	9167	60'		
MASON SAND				9180	9200	70'		
LITTLE LIM				9200	9205	5'		
PENCIL COAL				9205	9205	10'		
BIG LIM				9205	9405	40'		
BIG INJAN SAND				9405	9505	110'		
FIFTY FOOT SAND				9505	9604	11'		
THIRTY FOOT SAND				9109	9126	18'		
GARDEN STONY SAND				9105	9104	31'		
GARDEN SAND				9012	9001	9'		
							3870	

Well was not shot at _____ feet; well was shot at 3177-3180-3219-3220 feet.

Salt _____ feet; Fresh water at 1000 feet; Fresh water at _____ feet.

Well was _____ producing hole. How exhausted. _____

Approved: J. M. Reed & Co. Miners
Date: _____

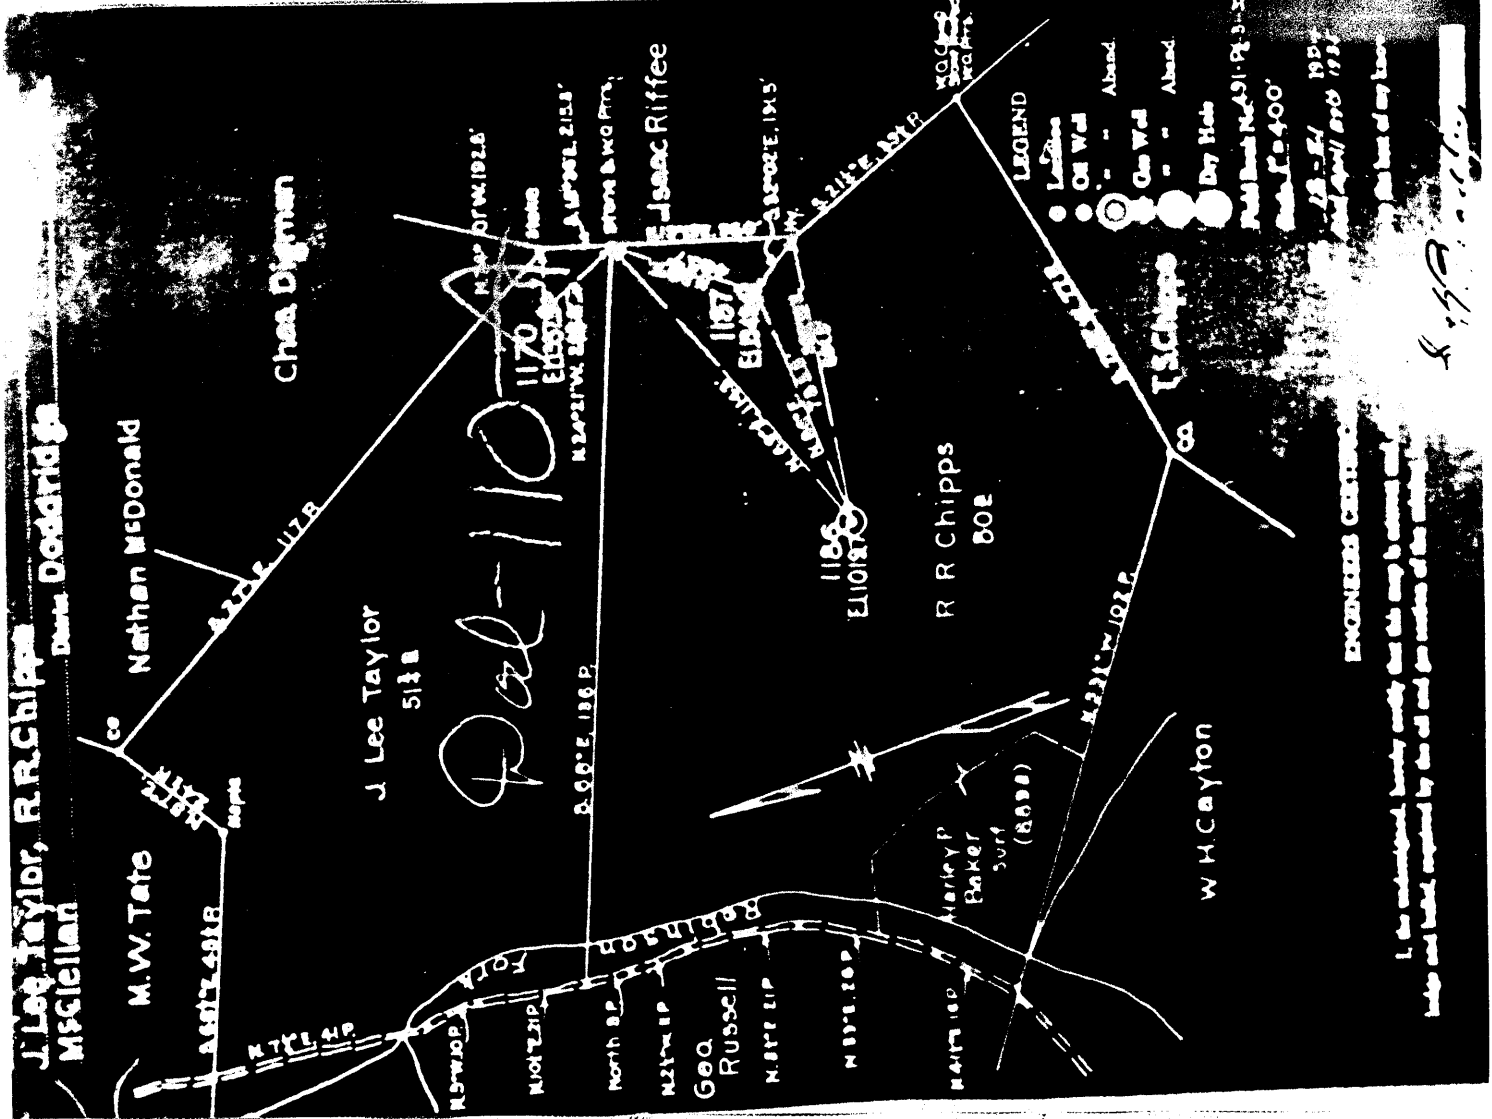

LEGEND
 ● Location
 ○ Oil Well
 ○ Gas Well
 ○ Dry Hole
 ○ Ahead
 ○ Ahead

Pub. Book No. 431-P-3-2
 Scale 1"=400'
 18-24 1914
 18-24 1914
 18-24 1914

ENGINEERS CERTIFICATE

I, the undersigned, hereby certify that this map is correct and that the location of the well is as shown on the map and that the same is in accordance with the laws of the State of West Virginia.

J. M. Reed & Co.

WEST VIRGINIA DEPARTMENT OF MINES

OIL AND GAS DIVISION

PRELIMINARY DATA SHEET NO. 1

Well No. Doa 110-A Well No. 1. (REDA/1190)
Company of Salem, T. Va.
on the J. Lee Taylor Farm
containing oil area. Location Doa Griggs District, in Doa Griggs County, West Virginia

The surface of the above tract is owned in fee by Edna O. Smith
of Salem, T. Va. address, and the mineral rights are owned by _____ of _____

The oil and gas privileges are held under lease by the above named company, and this well is drilled under permit No. _____ issued by the West Virginia Department of Mines, Oil and Gas Division _____

Elevation of surface at top of well _____ 1387 _____ Spirit _____

The number of feet of the different sized casings used in the well.

600	feet	10"	size, csg.	1667	feet	6"	size, csg.	Wood conductor.
9415	feet	6-5/8"	size, csg.	3870	feet	2"	size, csg.	
	feet		size, csg.		feet		size, csg.	
	feet		size, csg.		feet		size, csg.	
	feet		size, csg.		feet		size, csg.	
	feet		size, csg.		feet		size, csg.	

Coal was encountered at 1150 feet, thickness 84 inches, and at _____ feet; thickness _____ inches; and at _____ feet; thickness _____ inches.

Liners were used as follows: (Give details) _____

Date _____
Approved J. M. Reed & W. L. Jones _____
Owner _____

WEST VIRGINIA DEPARTMENT OF MINES

OIL AND GAS DIVISION

No Coal Oper. _____
DATE OF WELL _____
WELL NO. _____
WELL AND LOCATION _____
DISTRICT _____
COUNTY _____
WELL No. 1. (Formerly HARBRO-11120) _____
J. Lee Taylor _____
Farm _____

AFFIDAVIT

STATE OF WEST VIRGINIA, _____)
County of _____) s:
_____ and _____
being first duly sworn according to law depose and say that they are experienced in the work of plugging and filling oil and gas wells and were employed by _____ well operator, and participated in the work of plugging and filling the above well, that said work was commenced on the _____ day of _____ 1935, _____ and that the well was plugged and filled in the following manner:

Manner in which said well was plugged:
Removed 2" Tubing and filled _____ with clay to 3120' and
Placed wood plug and cement on top
Installed permanent bridge at 278'30" below big injun sand
and filled hole with clay to 1600' and _____ and placed
wood and cement plug and continued filling hole to 1390' Removed
1250' of 6 5/8 casing and continued filling hole to 1187'-20"
Manner in which said well was plugged: below Pittsburgh Coal Seam and filled
with cement to 1130'-20' above Coal seam, and from this
point to the top hole was filled with clay.

WAS NO OTHER CASING IN HOLE (JUST THE ONE STRING
6 5/8 ONLY)

Description of monument: CONCRETE MONUMENT HERE TO BE ERECTED WHEN
RIG REMOVED .

and that the work of plugging and filling said well was completed on the _____ day of _____ 1935.

And further deposes with net.
Burt Mitchell
Alfred Lister