Longitud

Topo Location

7.5' Loc. 2.045 15' Loc. 2.045

Company ____

Farm AC. Ballous #1
(59.3 acres)


15' Quad Juttont C (sec.)

7.5' Quad Center Point

District McClellan

WELL LOCATION PLAT

County 017 Permit 30117

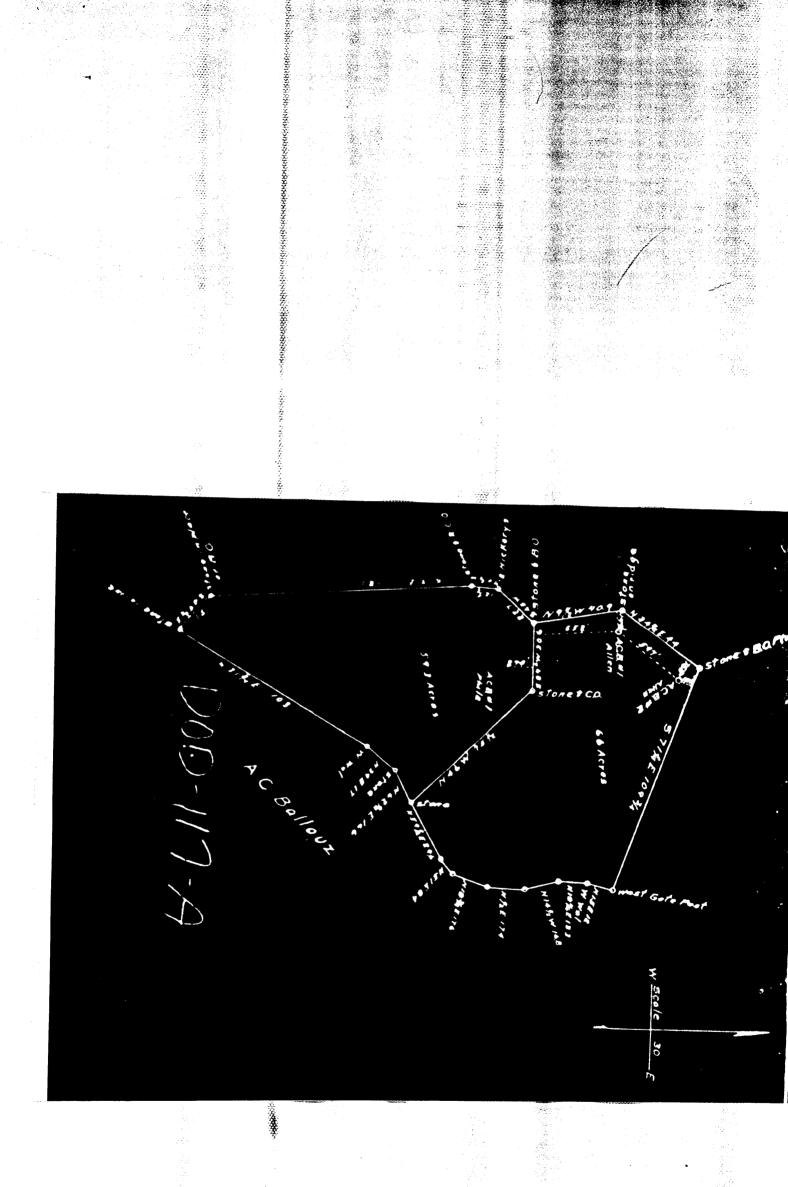

			2 2 5 6		8	Bollett
				2		
F 1001 - 1100						
7			8:85			
1			2 2 2	3	92 0	4
Caux A			21. 21.	¥ 8	826 826	COMPLETION DATA SHEET NO. 2 FORMATION RECORD
					• 1	MPLETION DATA SHE NO. 2 FORMATION RECORD
					11	ATA SH
	And the second s			•		

Notable Salis Sapanas Salis Sapanas

and will be present at the plugging of the three wells.

Liam was used as fellows: (Gire details). Home life, F. M. Yontor from whom I purchased two of the wells, is still pumping one well on this property

WEST VIRGINIA DEPARTMENT OF MINES

	_
10	91.
	=
	Z
	÷
	•
	•
	-
	î. A
	=
	=
	NOINION
	7
1.	3
	ž
0.00	

in easing perferried at		186 feet 10" stor. or.	Elevation of series at two of well.	The off and gas privileges are hald under bases by the above named company, and this well is defined. Leaved by the West Virginia Department of Mines. Off and	Some party	1	erre. Localies.	David Buby Company of	PRO No. De. C. 1115 P
				named company, and the well to defined water porter legists Department of Mines, Oil and Oas Division		A. 0. Ballons	Doddridge County. West Virginia	Bellaire, Ohie	Well No. 1

WEST VIRGINIA DEPARTMENT OF MINES OIL AND GAR DIVINION

WORK ORDER

Well to be planted and filled as follows

Fill with Clay from 2518 to 2295 feet. Tood Flug 2295 to 2292 feet. Occasi 2292 to 2287 feet.

Set a permanent bridge at 855 feet. 30 feet under coal. Clay 855 to 850 feet. Ceant 850 to 800 feet. Clay from 800 to 700 feet.

A marker will be erected as called for in the law.

TORE ODER THEE AND E. T.

Pillwith clay from the bottom 2210 to 2127 - 227 above the 310 Tajun prive wood plus from 2127 to 1100 Coment from 2169' to 21:9"

Combinue to fill with electric flow to 21.0% - 7% below the G-5/8% casing Drive word flug from 21.6% to 215% FULL 6-5/8% easing

SET A FERTANENT BRIEFI AT 1985 - TO THOM THE LAXON COMM.
Fill with clay from 1935 to 1920 - 20 above the Enxon Sand.
Comment from 1920 to 1910

SET A CALLET SHIPL AT 1000 a roul avolute olow the Salt Sanda Fill with oley from 1000; to 1725; Comput from 1725' to 1715'

Fill with clay from 1715' to 855' - 30' toles the Soul some Grant from 955' to 800'

To the Department of Mines, Errout n warker such as it described in Coef Owner or Operator, All to done in a werkman-like manner.

Lass or Property Owner. Fill with olay from 8.0' to the surface and Front a warker such as it described in Rule 18, 1931 Regulations

This "work order" is submitteed for your approval and enseurrence and unless notified of your disappreval or non-concurrence, the underwighed will proved with the plugging and filling of said well in the above described manner on the date stated in the notice of intention to plug and abandon the said well on eggs "e side of this shoet.

Yes train year.

Well Operator.

190 5

DEPARTMENT OF MINES
Of and One Division

NOTICE OF INTENTION TO PLUG AND ABANDON WELL

WEST VIRGINIA DEPARTMENT OF MINES

To THE DEPARTMENT OF MINES,

A. C. Tallous Furn	•
Well No. 070 59. 3644	-
Doddridge Comty	A. C. Bellous
Medlellan District	
FILT 10 SE ARANDOIRD 19. 85	COAL CEDATOR OF COAL CHINES
Bellaire, Ohio	
David Ruby	To est operations

The undersigned well operator is about to abandon the above described well and will commence the

due course should be received by the Department of Mines). (which date shall not be less than five days after the day on which this notice so mailed is received, or in werk of plugging and abandoning said well on the 2576 day of...

required by Section 10, Article 4, Chapter 22 of the Code and given in detail on the reverse side of this and filling of said well. You are further notified that whether you are represented or not sepressed the nation, in "Work Order." milernigned will proceed on that date, or shortly thereafter, to ping and fill said well in the manner This notice is given you in order that your respective representatives may be present at the plugging

This notice is being mailed by registered mail to each of you at the above addresses on the above date

sid-liked prior to Jame 1, 1929, a plat prepared by a competent on-th the tract of land is inested, the name and arrange of same, the booston of the about to be absorded well, deformined by survey, a two permanent points or landmarks on each tract, shall be exhaulted