

Latitude $39^{\circ} 25' 00''$

Long 83° 48' 00"

Longitude

75
+

Topo Location

7.5' Loc.	<u>1.74S</u>	15' Loc.	<u>1.74S</u>
	<u>1.72W</u>	(calc.)	<u>3.95W</u>

Company _____

Farm A.C. Ballous #2
(64 acres)


15' Quad Centrpt C
(sec.)

7.5' Quad Center Point

District McClellan

WELL LOCATION PLAT

County O17 Permit 30118

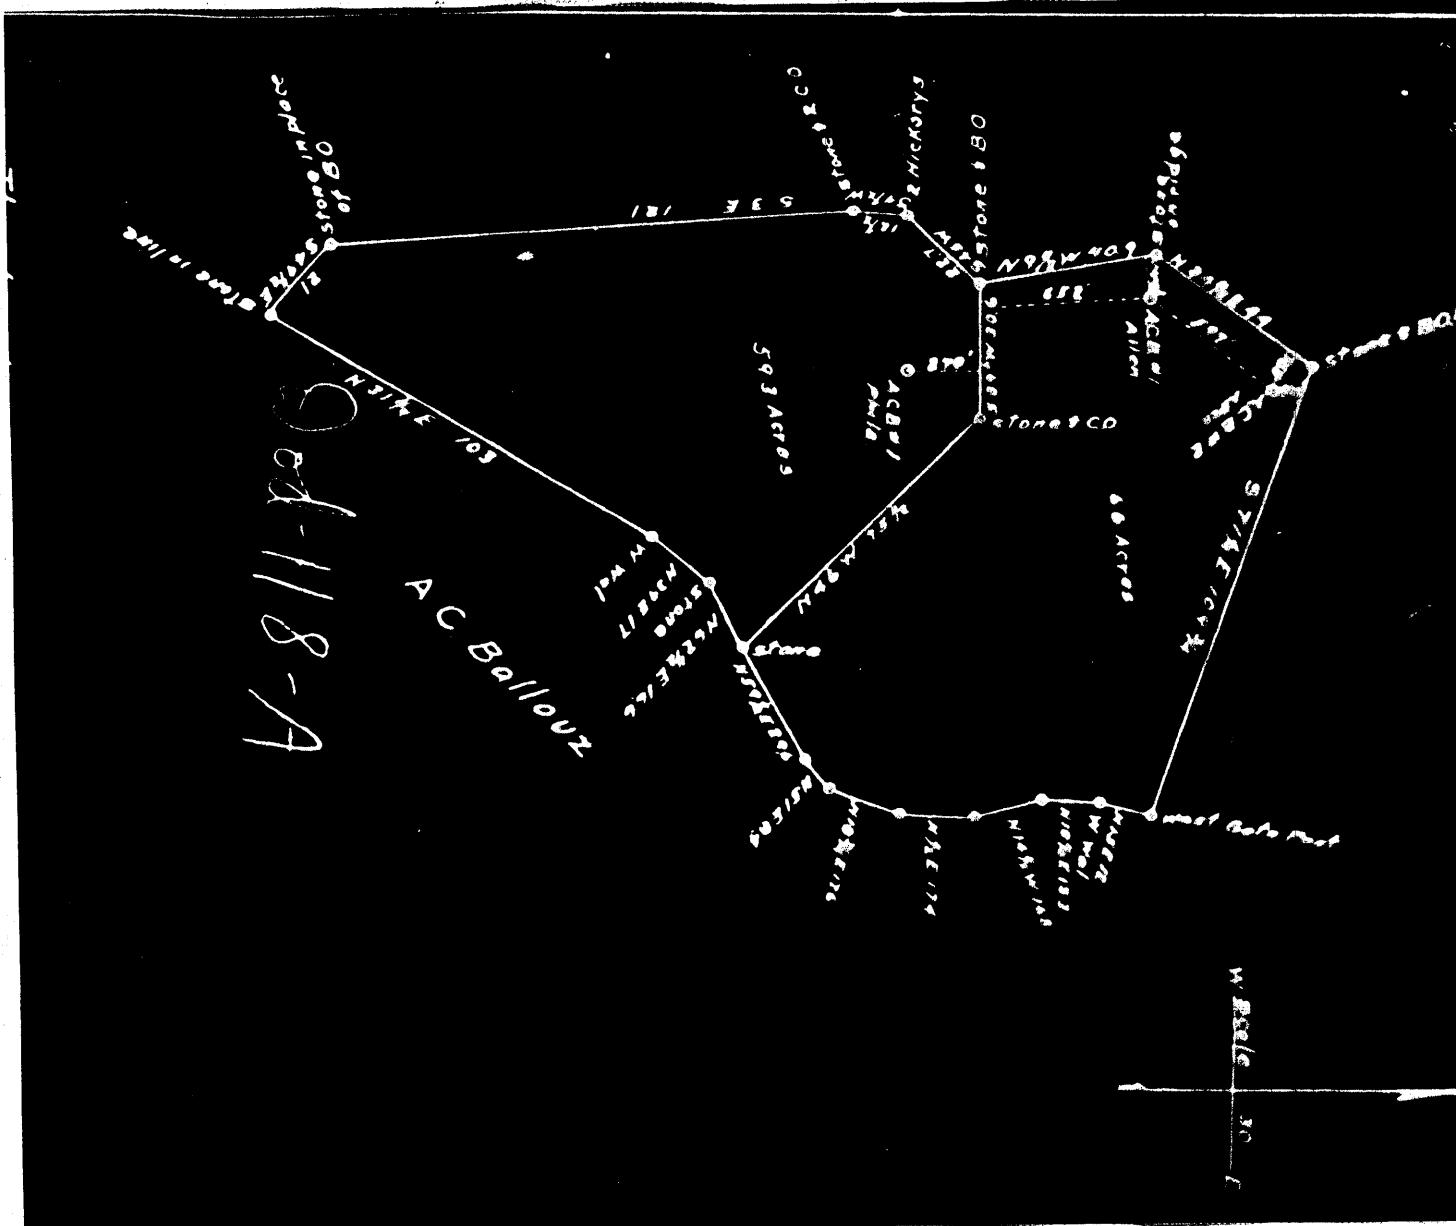

WEST VIRGINIA DEPARTMENT OF MINES

OIL AND GAS DIVISION

WORK ORDER

Well to be plugged and filled as follows:

**FILL WITH CLAY FROM 8350 TO 2800 FEET. NO PLUG 2850 TO 2877 FEET.
ABANDON SEAM TO BASE FLOOR.**

W.R. O.

W.R.O.

A marker will be erected as called for in the law.

To the Department of Mines,
Coal Owner or Operator,
Lessee or Property Owner.

This "work order" is submitted for your approval and concurrence and unless notified of your disapproval or non-concurrence, the undersigned will proceed with the plugging and filling of said well in the above described manner on the date stated in the notice of intention to plug and abandon the said well on opposite side of this sheet.

Very truly yours,

A. C. Bellous
W.R.O. Operator.

No objections have been filed by the coal owner or coal operator, or any available adjacent lease or property owner or lessee or operator by the Department of Mines to the manner herein described for the plugging and filling of the well above mentioned. Therefore, the same is hereby approved this 22nd day of JULY, 1955 for work to be done July 23, 1955.

DEPARTMENT OF MINES

NOTICE OF INTENTION TO PLUG AND ABANDON WELL

(Continued on reverse side of document)

WEST VIRGINIA DEPARTMENT OF MINES

OIL AND GAS DIVISION

To The Department of Mines,
Charleston, W. Va.

[Signature]

No coal operations <small>and no mining on coal owners</small>	David Ruby <small>name or title operator</small>
Coal operators on coal owners <small>and no mining on coal owners</small>	Belkire, Ohio <small>name or title operator</small>

July 18th, 19 55

WELL TO BE ABANDONED
name or title operator

McCollum District
name or title operator

Demarais County
name or title operator

Wall No. Two
name or title operator

A. C. Bellous Farm
name or title operator

Gentlemen:-

The undersigned well operator is about to abandon the above described well and will commence the

work of plugging and abandoning said well on the 26th day of JULY, 19 55,
(which date shall not be less than five days after the day on which this notice so mailed is received, or in due course should be received by the Department of Mines).

This notice is given you in order that your respective representatives may be present at the plugging and filling of said well. You are further notified that whether you are represented or not represented the undersigned will proceed on that date, or shortly thereafter, to plug and fill said well in the manner required by Section 10, Article 4, Chapter 22 of the Code and given in detail on the reverse side of this notice, in "Work Order."

This notice is being mailed by registered mail to each of you at the above addresses on the above date.

Very truly yours,

A. C. Bellous
W.R.O. Operator.