

Latitude 39°22'30"

7.5'  
+

100.0408

Longitude

Topo Location

7.5' Loc. 0.67S 15' Loc. 3.55S  
0.52W (calc.) 0.52W

Company \_\_\_\_\_

Farm Clara Dillie

15' Quad Centrepnt WC  
(sec.)

7.5' Quad Smithsburg

District McClellan

WELL LOCATION PLAT

County 017 Permit 30142

142-A

McClellan District, Doddridge County, W. Va.  
 By Carnegie Natural Gas Co., 962 Frick Bldg. Annex, Pittsburgh, Pa.  
 On 71 acres, surface owned by O. L. Dilley, Route 1, Morgansville,  
 W. Va., and mineral rights by Wm. A. Hogg Heirs, Uniontown, Pa.  
 Drilled before June, 1929. Lease No. E-4694-15.  
 Elevation, 1240' B.  
 6-5/8" casing, 2120'.  
 Coal was encountered at 527-532 and 780-785'.  
 Abandonment reported to Dept. of Mines Jan. 4, 1936.  
 Well was shot (depth not recorded).  
 Water not recorded.  
 Gas well.

	Top.	Bottom.	Thickness.
Coal	527	532	5
Pittsburgh Coal	780	785	
Little Dunkard Sand	1215	1255	40
Big Dunkard Sand	1350	1430	80
Salt Sand	1785	1835	50
Maxton Sand (show oil)	1905	2000	95
Pencil Cave	2080	2090	10
Big Lime	2110	2195	85
Big Injun Sand (gas, 2268')	2196	2297	102
Gantz Sand	2450	2500	50
50-Ft. Sand	2700	2720	20
30-Ft. Sand	2750	2800	50
Gordon Stray Sand	2840	2860	20
Gordon Sand (gas, 2915-2916')	2891	2917	26
Total depth		2943	

FORMATION RECORD


Name	Color	Character	Oil Gas or Water	Top	Bottom	Thickness	Total Depth	Remarks
Pittsburg Coal				527	532	5		
Little Washard				780	785	5		
Big Darbard				1212	1216	40		
Salt Sand				1360	1450	80		
Marston			Shr Oil.	1785	1835	50		
Pencil Core				1906	2000	95		
Big Live				2080	2090	10		
Big Injur				2110	2195	85		
Quartz			Gas - 2265	2195	2297	102		
50' Sand				2460	2500	50		
30' "				2700	2720	20		
Gordon Stray				2750	2800	50		
Gordon			Gas 2915-2917	2840	2860	20		
				2891	2917	26	2943	

about  
Well was abandoned at depth not recorded, feet; well was about at feet.

Salt  
Fresh water at Not Recorded feet; fresh water at salt  
producing hole.  
Well was dry

Approved \_\_\_\_\_ Date JANUARY 4, 1926.  
Owner CARNEGIE NATURAL GAS COMPANY

CARNegie NATURAL GAS COMPANY OF PENNSYLVANIA  
the ... Co. ...  
Located in ...  
West Virginia ...  
Scale 1 inch = 1000 feet

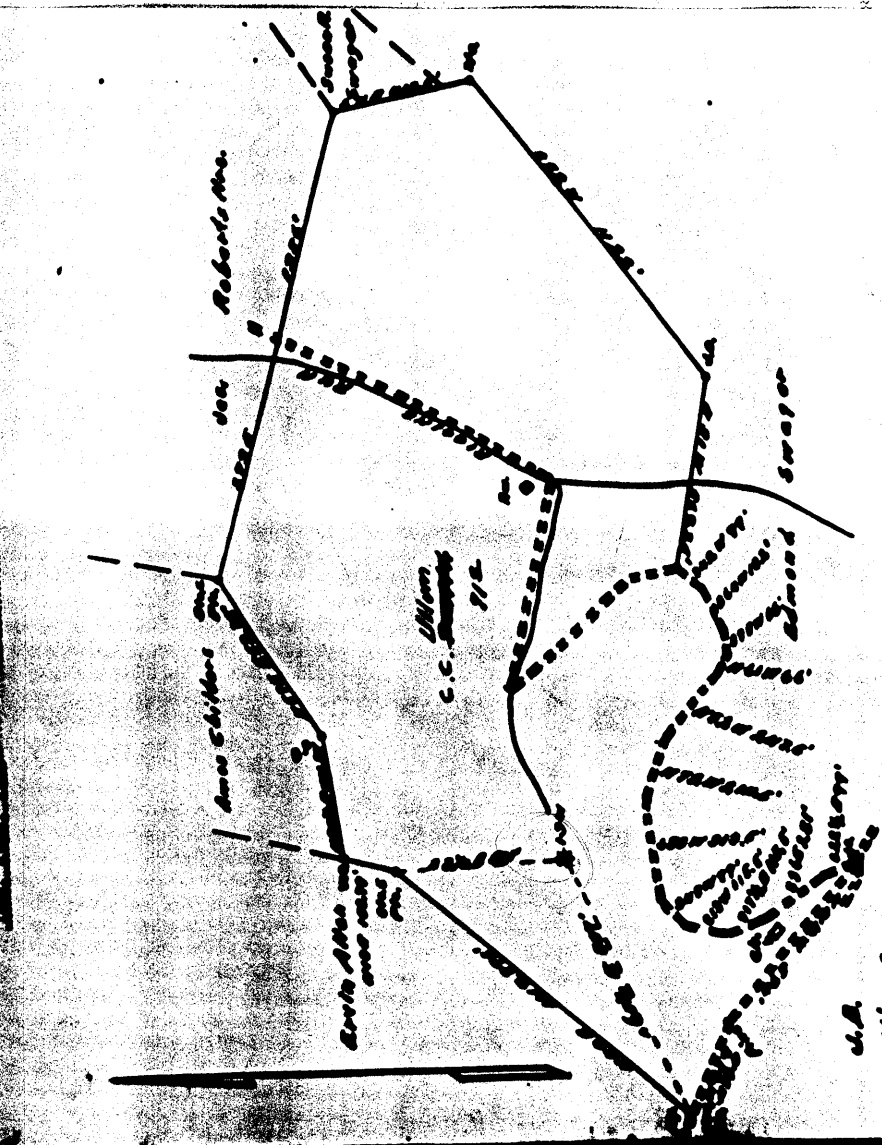

I, the undersigned, hereby certify that this map is correct and shows all the information to be had from my knowledge and belief, required by the oil and gas section of the Mining Law of West Virginia.

J. B. Williams  
Engineer

State of West Virginia  
County of Raleigh  
Acknowledged before me a Justice of the Peace this 19th day of December 1926

WEST VIRGINIA DEPARTMENT OF MINES

OIL AND GAS DIVISION

PRELIMINARY DATA SHEET NO. 1

Lease No. 5-1004-16.

Well No. 1-541.

File No. ... Company of ... on the ...

containing ... District, ... County, West Virginia

The surface of the above tract is owned in fee by ... address, and the mineral rights are owned by ...

The oil and gas privileges are held under lease by the above named company, and this well is drilled under permit ...

Drilled before June, 1929. Elevation of surface at top of well ... 1240' ...

The number of feet of the different sized casings used in the well.

Table with columns for casing size (e.g., 2 1/2 inch, 2 inch, 1 1/2 inch) and length in feet.

Coal was encountered at ... 527 feet, thickness 60 inches, and at ... 780 feet; thickness 60 inches; and at ...

Lines were used as follows: (Give details)

Date: JANUARY 4, 1936. Approved: CARNEGIE NATURAL GAS COMPANY. Owner: ...

PLUGGING AND FILLING WELL

WEST VIRGINIA DEPARTMENT OF MINES OIL AND GAS DIVISION

Dr. A. Egg Beds ... District ... County ... Well No. 1-541

DATE OF WORK ... AFFIDAVIT

STATE OF WEST VIRGINIA

County of ...

John Willard and ... being first duly sworn according to law depose and say that they are experienced in the work of plugging and filling oil and gas wells and were employed by ...

Manner in which sand was plugged:

Total depth of well 2945' Filled with clay to 2871' Set off Wood Plug at 2871' to 2885' Filled with Cement from 2885' to 2895' - Sealing Fourth Sand Filled with Clay to 2145' Set off Wood Plug at 2145' to 2160' Filled with Cement from 2160' to 2190' - Sealing Big Incon Sand Cement fill off casing - Set at 2190'

Layer of casing at 2000' - Cement set full - Filled with mud or clay. Layer of casing at 2040' - Cement set full - Filled with clay. Layer of casing at 2000' - Cement set full - Filled with clay. ...

Coal ...

and that the work of plugging and filling said well was completed on the ... day of ... 19 ...

And further depositions with not.

John Willard ...