

Latitude 39° 17' 30"

+ 75'

Longitude 80° 40' 00"

Longitude

Topo Location

7.5' Loc. 0.81S 15' Loc. 3.69S
0.79W (calc.) 0.79W

Company _____

Farm Hiram Heaton #1

15' Quad Centerpoint SW
(sec.)

7.5' Quad Switzburg

District Grant

WELL LOCATION PLAT

County 017 Permit 30149

Grant District, Doddridge County, W. Va.

By Doddridge County Std. Gas Co., West Union, W. Va. (W. J. Drop-
pleman, Gen. Mgr.) (Good Luck Oil & Gas Co. well?)On 5 acres, surface owned by A. G. Knotts, Morgansville, W. Va.,
and mineral rights by A. G. Knotts and Hiram Heaton, Morgans-
ville, W. Va.

No elevation given.

10" casing, 200' (pulled); 8 $\frac{1}{4}$ " 800' (pulled); 6-5/8" 1530';
16' conductor.

Steel shoe, 6-5/8", set at 1530'.

Abandonment reported to Dept. of Mines June 13, 1936.

Drilled in 1909?

Well was not shot.


No water.

Gas well.

	Top.	Bottom.	Thickness.
Pittsburgh Coal		231	Blossom
Little Dunkard Sand	740	- 750	10
Big Dunkard Sand	798	- 830	32
First Gas Sand	920	- 980	60
1st Salt Sand	1030	- 1130	100
2nd Salt Sand	1130	- 1215	85
3rd Salt Sand	1290	- 1326	36
Maxton Sand	1337	- 1400	67
Little Lime	1560	- 1570	10
Pencil Cave	1570	- 1598	28
Big Lime	1598	- 1620	22
Big Injun Sand (gas, 1634')	1620	- 1685	65
Total depth		1737	
Plugged back to		1685	

Plat of the location of well No. 1, of the Good Luck Oil & Gas Co. on the Farm of H. L. Heaton, (Now owned by - Knott's) consisting of 5 acres, Situate on Buckeyefork, in Grant District of Doddridge County, West Virginia.

Now owned by The Doddridge Standard Gas Co.

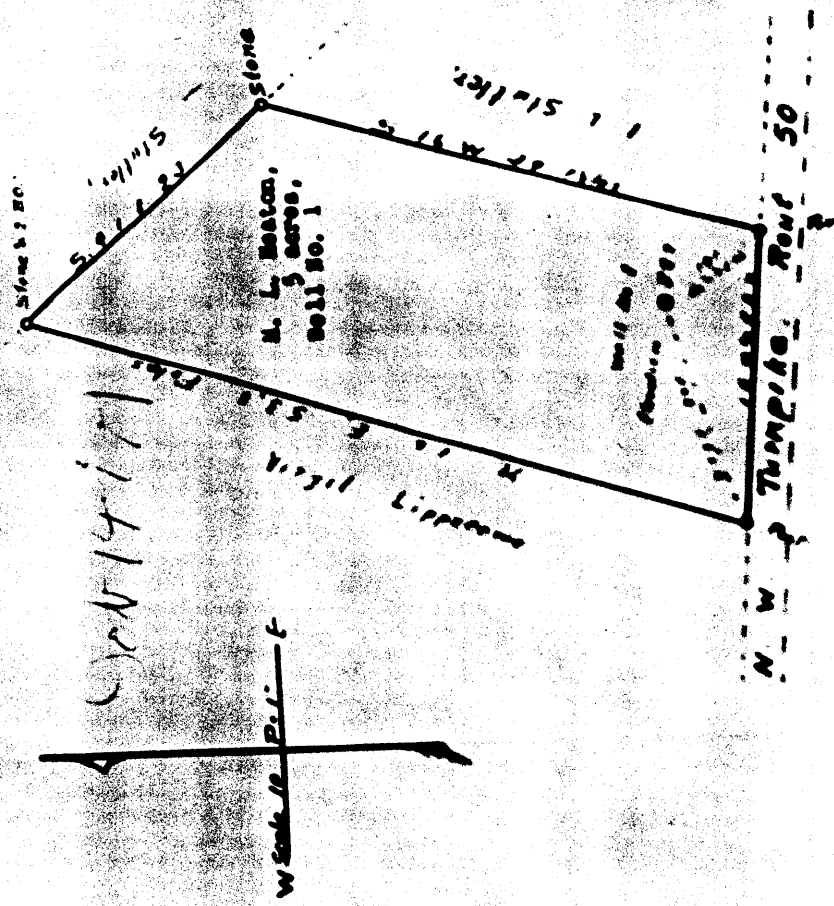

I, the undersigned, hereby certify that this map is correct and shows all the information to the best of my knowledge and belief, required by the Oil and Gas section of the mining laws of West Virginia. June 5th 1936. *J. M. Martin*, Engineer.

Acknowledged before me a Notary Public of Doddridge County, West Virginia, this 14 day of June, 1936. *Witness my hand and Notary Public.*

My commission expires on the 1. day of *July*, 1937.

COMPLETION DATA SHEET
NO. 2
FORMATION RECORD

West Union, West Virginia
Address
FARM HIRSH HEATON

Well No. 1

Name	Color	Character	Oil Gas or Water	Top	Bottom	Thickness	Total Depth	Remarks
Pgh. Coal					231	Lossion		
Little Dunkard				740	750	10		
Big Dunkard				798	830	32		200 ft. 10" CGG.
Gas Sand				920	960	40		
1st. Salt Sand				1090	1130	40		600 ft. 8"
2nd. Salt Sand				1130	1215	85		
3rd. Salt Sand				1390	1395	5		1000 ft. 6-8/8"
Maxon				1397	1400	3		
Little Lime			1434	1440	1970	10		Casing
Pencil Cove				1970	1998	28		
Big Lime				1978	1480	28		
Big Injun				1450	1468	18		
Gas							1468	

Oil well was drilled at 201 2801
 Oil well was drilled at 2000
 Oil well was drilled at 2000

June 13/36
W. L. Knott
 Notary Public
 Doddridge County - W. Va. Company

