

Latitude

39°15'00"

39°15'00"

Longitude

7.5'
+

Topo Location

7.5' Loc. 1.00S 15' Loc. 1.00S
1.55W (calc.) 1.55W

Company _____ #27

Farm Lewis Maxwell

15' Quad Halbrook NE
(sec.)


7.5' Quad OXFORD

District West Union

WELL LOCATION PLAT

County 017 Permit 30150

*Map of Lewis
C-32-A*

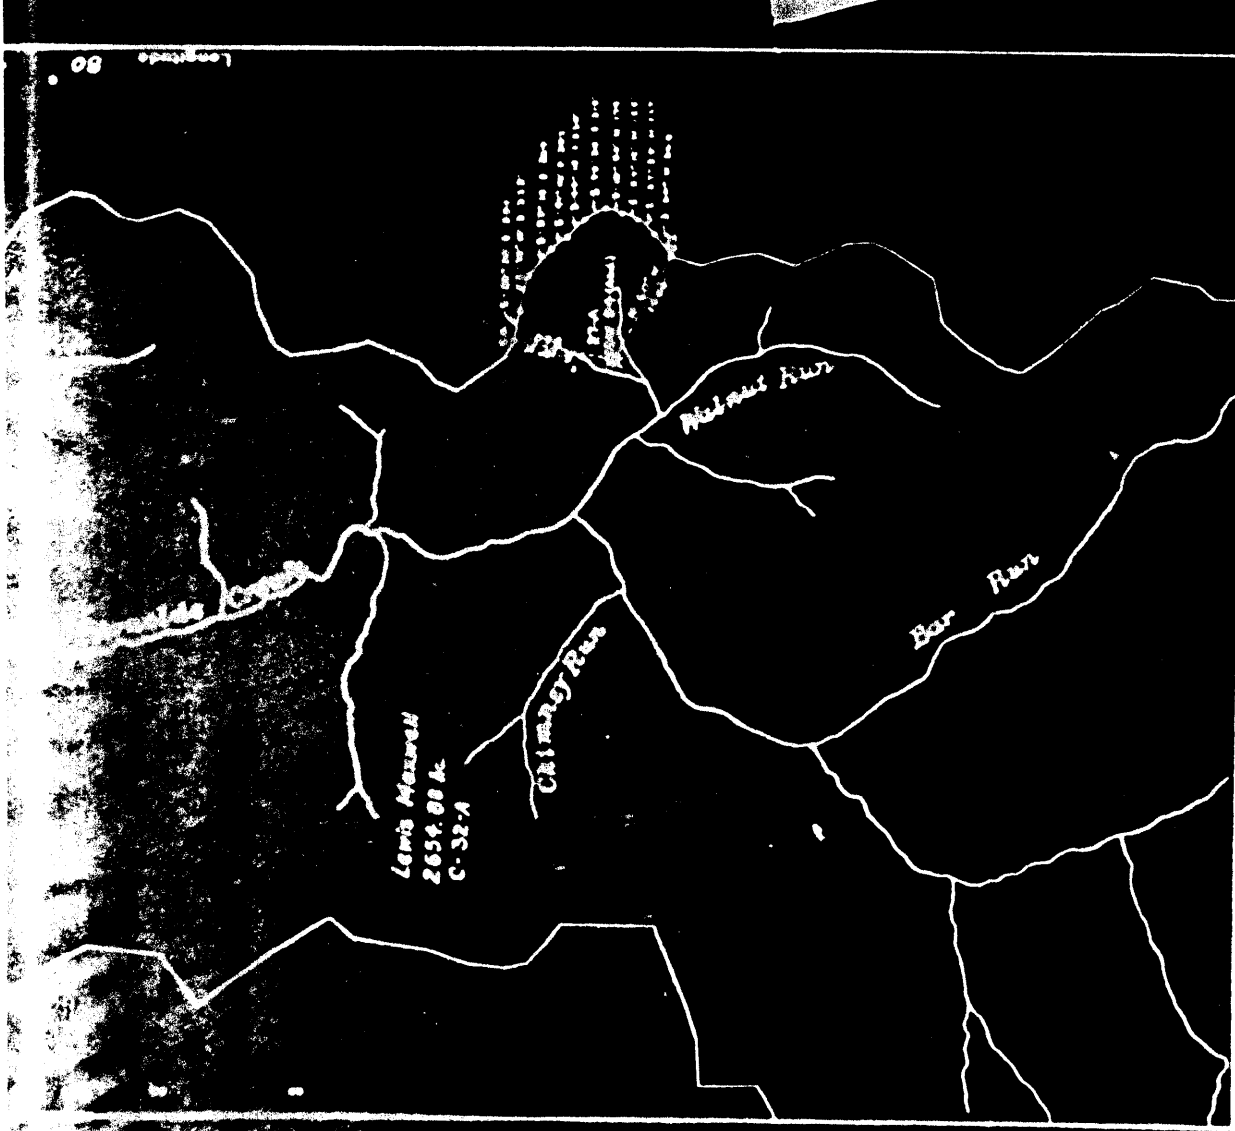

STATE OF WEST VIRGINIA
DEPARTMENT OF MINES
OIL AND GAS DIVISION
CHARLESTON

WELL LOCATION MAP
FILE NO. **DOD-150**

County Columbia Carbon Co.
 Address Bar Run Charleston, W. Va.
 Farm Lewis Maxwell
 Tract A Area 2554.88 Acres No. C-32
 Well (Farm) No. 27-A Bond No. 514.88
 Coalfields Northwest M.E.
 County Doddridge
 District West Union
 Engineer W. L. Brantley

♦ Shaded location of well on United States
 Topographic Map, scale 1 to 62,500, un-
 der file number being referred to.

Longitude

80

Well No. 27-A (07-04) Face Lewis Maxwell
 Doddridge County, W. Va.

FORMATION RECORD
 ELEVATION 956

Name	Color	Character	Top (1st Use or Water)	Bottom	Thickness	Total Depth	Remarks
Coal			196	204	6		
Coal			776	778	3		
Big Dubard Sand			856	816	15		
Sand			856	870	14		
Slate			856	858	43		
Int. Salt Sand Slate			860	860	12		
Sand			1048	1048	96		
Slate			1110	1110	62		
Sand			1110	1166	56		
Slate			1165	1180	15		
Slate			1180	1240	60		
Sand			1240	1315	75		
Slate & Shells			1315	1386	70		
Lime			1386	1396	10		
Sand			1396	1416	21		
Slate			1416	1431	15		
Lime			1431	1444	13		
Sand			1444	1486	41		
Slate			1486	1540	55		
Sand			1540	1580	10		
Lime			1580	1580	10		
Lime			1580	1574	14		
Fennell Cave Big Lime			1574	1584	10		
Big Injan Slate			1584	1673	69		
Lime & Shale			1673	1742	69		
Gentle Sand			1742	1790	48		
Slate & Shale			1790	1900	110		
Thirty Ft. Sand			1900	2042	142		
Gordon Sand			2042	2206	163		
			2206	2319	114		
			2319	2323	4		
TOTAL DEPTH				2331 ft.			
CASING RECORD:	10"	430 ft.					
	6-1/4"	1100 ft.					
	6-3/8"	1980 ft.					
	6-3/16"	125 ft.					

Well was not shot at. _____ feet; well was shot at _____ feet.
 Shot with _____ and
 Fresh water at _____ feet; fresh water at _____ feet.
 Well was _____ producing _____ bits.
 Well was _____

Approved: *[Signature]*
 COLUMBIAN CARBON COMPANY
 JUNE 22, 1919

Lewis Maxwell
 Box 1240
 Charleston, W. Va.
 COMPLETE ADDRESS

Columbian Carbon Company
 Box 1240
 Charleston, W. Va.
 COMPLETE ADDRESS

WELL AND LOCATION
 East Union District
 Doddridge County
 Well No. 27-A
 Lewis Maxwell Farm

AFFIDAVIT

STATE OF WEST VIRGINIA,
 County of Doddridge

I, R. R. Hoffmann, and Guy E. Jones
 being first duly sworn according to law depose and say that they are experienced in the work of plugging
 and filling oil and gas wells and were employed by Columbian Carbon Company, well operator,
 and participated in the work of plugging and filling the above well, that said work was commenced on the
 1st day of May, 1919, and that the well was plugged and filled in
 the following manner:

Manner in which well was plugged:
 Bridged 2 1/2" - 1590 ft.
 6-1/8" cas. perforated at 1980, 968 and 390 ft. 1980 - 390 ft.
 Cement (inside and outside of 6-5/8" cas.) 390 - 00 -
 Cement outside of 6-5/8" cas. 390 - 16 ft.
 Averaged inside of 6-5/8" cas. 16 - 00 -
 Cement inside of 6-5/8" cas. 16 - 00 -

Manner in which well was plugged:
 Description of cement: Left 6-5/8" casing on the casing.

and that the work of plugging and filling said well was completed on the 21 day of May, 1919.
 R. R. Hoffmann
 And further deposes with me.
[Signature]
 1237