


39° 25'

LATITUDE

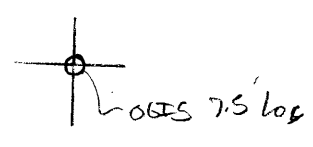

80° 37' 30"

LONGITUDE

7.5 OGIS topo location

7.5' loc.	<u>0.62 S</u>	15' loc	_____
	<u>0.82 W</u>	(calc.)	_____

Company _____

Farm _____

Quad Center Point

County _____

District McClellan

WELL LOCATION MAP

File No. 017-30161

WEST VIRGINIA DEPARTMENT OF MINES
OIL AND GAS DIVISION

131

WELL RECORD

OIL

Permit No. D60-161-~~61~~-A

Oil or Gas Well.....
(Kind)

SOUTH PENN OIL COMPANY				Casing and Tubing	Used in Drilling	Left in Well	Packers
Company	C. of C. Bldg., Pittsburgh, Pa.			Size			Kind of Packer
Address	W. E. George						Size of
Farm	Acres 5-3/8						Depth set
Location (waters)	Franks Run of McElroy Creek						Perf. top
Well No.	1115.						Perf. bottom
District	McClellan	County	Doddridge	16			Perf. top
The surface of tract is owned in fee by	Jas. B. Smith			13	430	430	Perf. bottom
Mineral rights are owned by	Smithfield, W. Va.			10	1390	1390	Perf. top
Drilling commenced	Address Bessie Smith et al			8 1/4	1780	1780	Perf. bottom
Drilling completed	West Union, W. Va.			6 5/8	2150	2150	Perf. top
Date shot	April 1, 1895	Depth of shot	--	5 3/16			Perf. bottom
Open Flow	/10ths Water in	--	Inch	3			
Volume	/10ths Merc. in	--	Inch	2			
Rock Pressure	--	--	Cu. Ft.	Liners Used			
Oil	110	bbls., 1st 24 hrs.					
Fresh water	--	feet					
Salt water	--	feet					


CASING CEMENTED.....SIZE.....No. FT.....Date Est.

COAL WAS ENCOUNTERED AT 808 FEET 60 INCHES

FEET.....INCHES.....FEET.....INCHES

FEET.....INCHES.....FEET.....INCHES

Formation	Color	Hard or Soft	Top	Bottom	Oil Gas or Water	Depth Found	Remarks
Pittsburgh Coal			808	813 (Est.)			
Big Injun Sand			2168		Oil	2257	
					2nd Pay	2266	
Total Depth				2284			

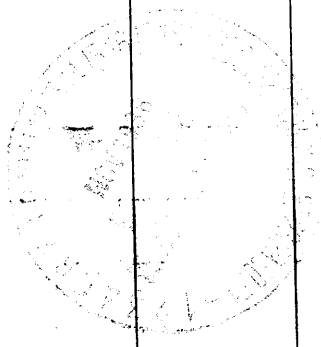

Formation	Color	Hard or Soft	Top	Bottom	Oil, Gas or Water	Depth Found	Remarks

Date November 10, 1936

APPROVED SOUTH PENN OIL COMPANY, Owner
 By Edwin Edging Land Agent.
 (Title)

McClellan District, Doddridge County, W. Va.
 By South Penn Oil Co., C. of C. Bldg., Pittsburgh, Pa.
 On 5-3/8 acres, on Franks Run of McElroy Creek; surface owned by
 Jas. B. Smith, Smithfield, W. Va., and mineral rights by
 Bessie Smith et al., West Union, W. Va.

Elevation, 1115' L.

Drilling commenced April 1, 1895; completed, July 2, 1895.

Shot 7-14-04; 2-21-06; and 5-13-06.

110 bbls. oil first 24 hrs.

10" casing, 430'; 8 1/4", 1390'; 6 5/8", 1780'; 5 3/8", 2150'.

Coal was encountered at 808 (est. 60" thick).

Oil well. Abandonment reported to Dept. of Mines Nov. 10, 1936.

Record to RCT from D.G. Courtney (Dept. of Mines) 5-5-37.

	Top.	Bottom.
Pittsburgh Coal	808	813 (Est.)
Big Injun Sand (oil, 2257'; 2nd pay, 2266')	2168	
Total depth		2284