


39° 22' 30"

LATITUDE

80° 45' 15"

LONGITUDE

2.70 S

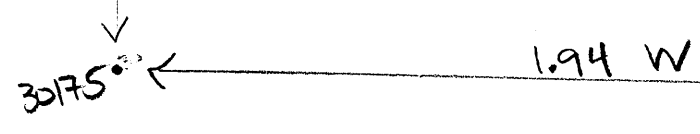

7'5 OGIS topo location

7.5' loc	<u>2.70 S</u>	15' loc	_____
	<u>1.94 W</u>	(calc.)	_____

Company _____

Farm TJ Smith 4

Quad WEST UNION

County Doddridge

District _____

WELL LOCATION MAP

File No. Dodd 30175

T. J. SMITH NO. 4 WELL.

No. 164 O.F.-Doddridge.

Dodd 175A

West Union District, Doddridge County, W. Va.

By Clifton Oil & Gas Co., R. A. Startzman, Gen. Mgr., Parkersburg, W. Va.

On 78 acres, on Nutters Fork.

Surface owned by T. J. Smith, R. F. D. No. 2, West Union, W. Va.

Elevation.....

13" casing, 59.5'; 10", 385' (pulled); 8 1/2", 941' (pulled); 6 3/8", 1693'.

Coal was encountered at 427-432'.

Well was shot 7-8-24, with 60 qts.; no record of depth.

No record of water.

Oil well. Abandonment reported to Dept. of Mines June 11, 1937.

Record to RCT from D. G. Courtney 2-1-38.

	Top.	Bottom.	Thickness.
Pittsburgh Coal	427	- 432	5
Big Dunkard Sand	935	- 957	22
First Salt Sand	1215	- 1350	135
Second Salt Sand	1395	- 1490	95
Maxton Sand	1540	- 1615	75
Little Lime	1648	- 1662	14
Pencil Cave	1662	- 1674	14
Big Lime	1683	- 1748	65
Big Injun Sand (oil at 1754-1768')	1748	- 1768	20
Total depth			1773