


M

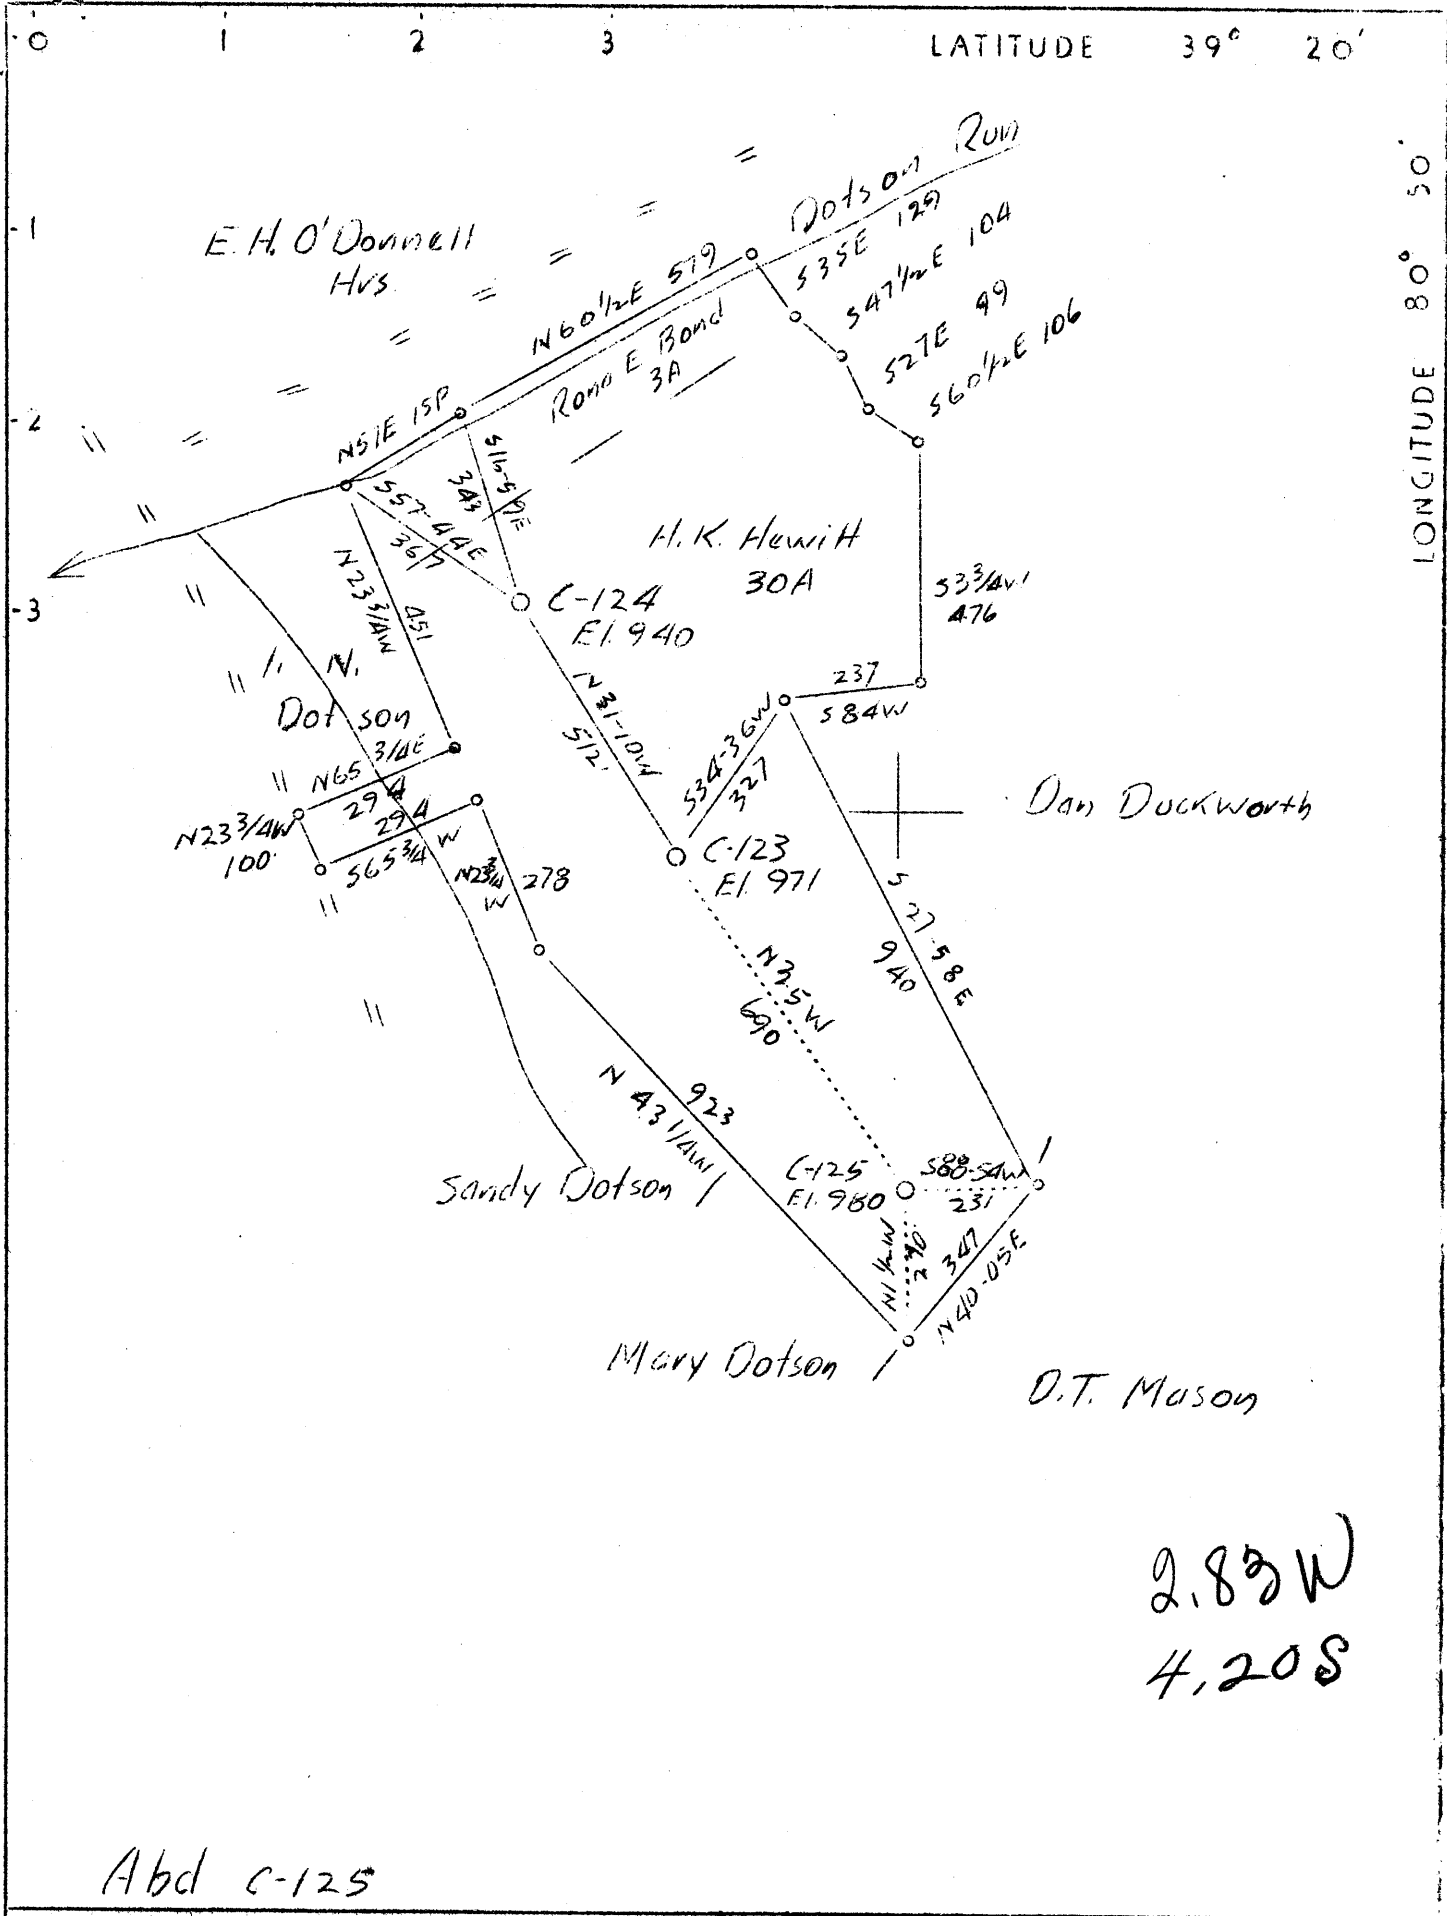

2.83 W
4.20 S

Abd C-125

Company	Hope Constr. & Ref. Co.
Address	Clarksburg, W.Va.
Farm	Henry K. Hewitt
Tract	Acres 30 Lease No. 23955
Well (Farm) No.	1-2-3 Serial No. C-125
Elevation (Spirit Level)	971-940-980
Quadrangle	West Union S.C.
County	Doddridge District Central
Engineer	J.A. Clark
Engineer's Registration No.	744
File No.	Drawing No.
Date	Jan. 6, 1938 Scale 1"-20P.

STATE OF WEST VIRGINIA
Department of Mines
OIL AND GAS DIVISION
CHARLESTON

WELL LOCATION MAP

File No. DOD-203A

+ Denotes location of well on United States Topographic Maps, scale 1 to 62,500, latitude and longitude lines being represented by border lines as shown.

— Denotes one inch spaces on border line of original tracing.