


M

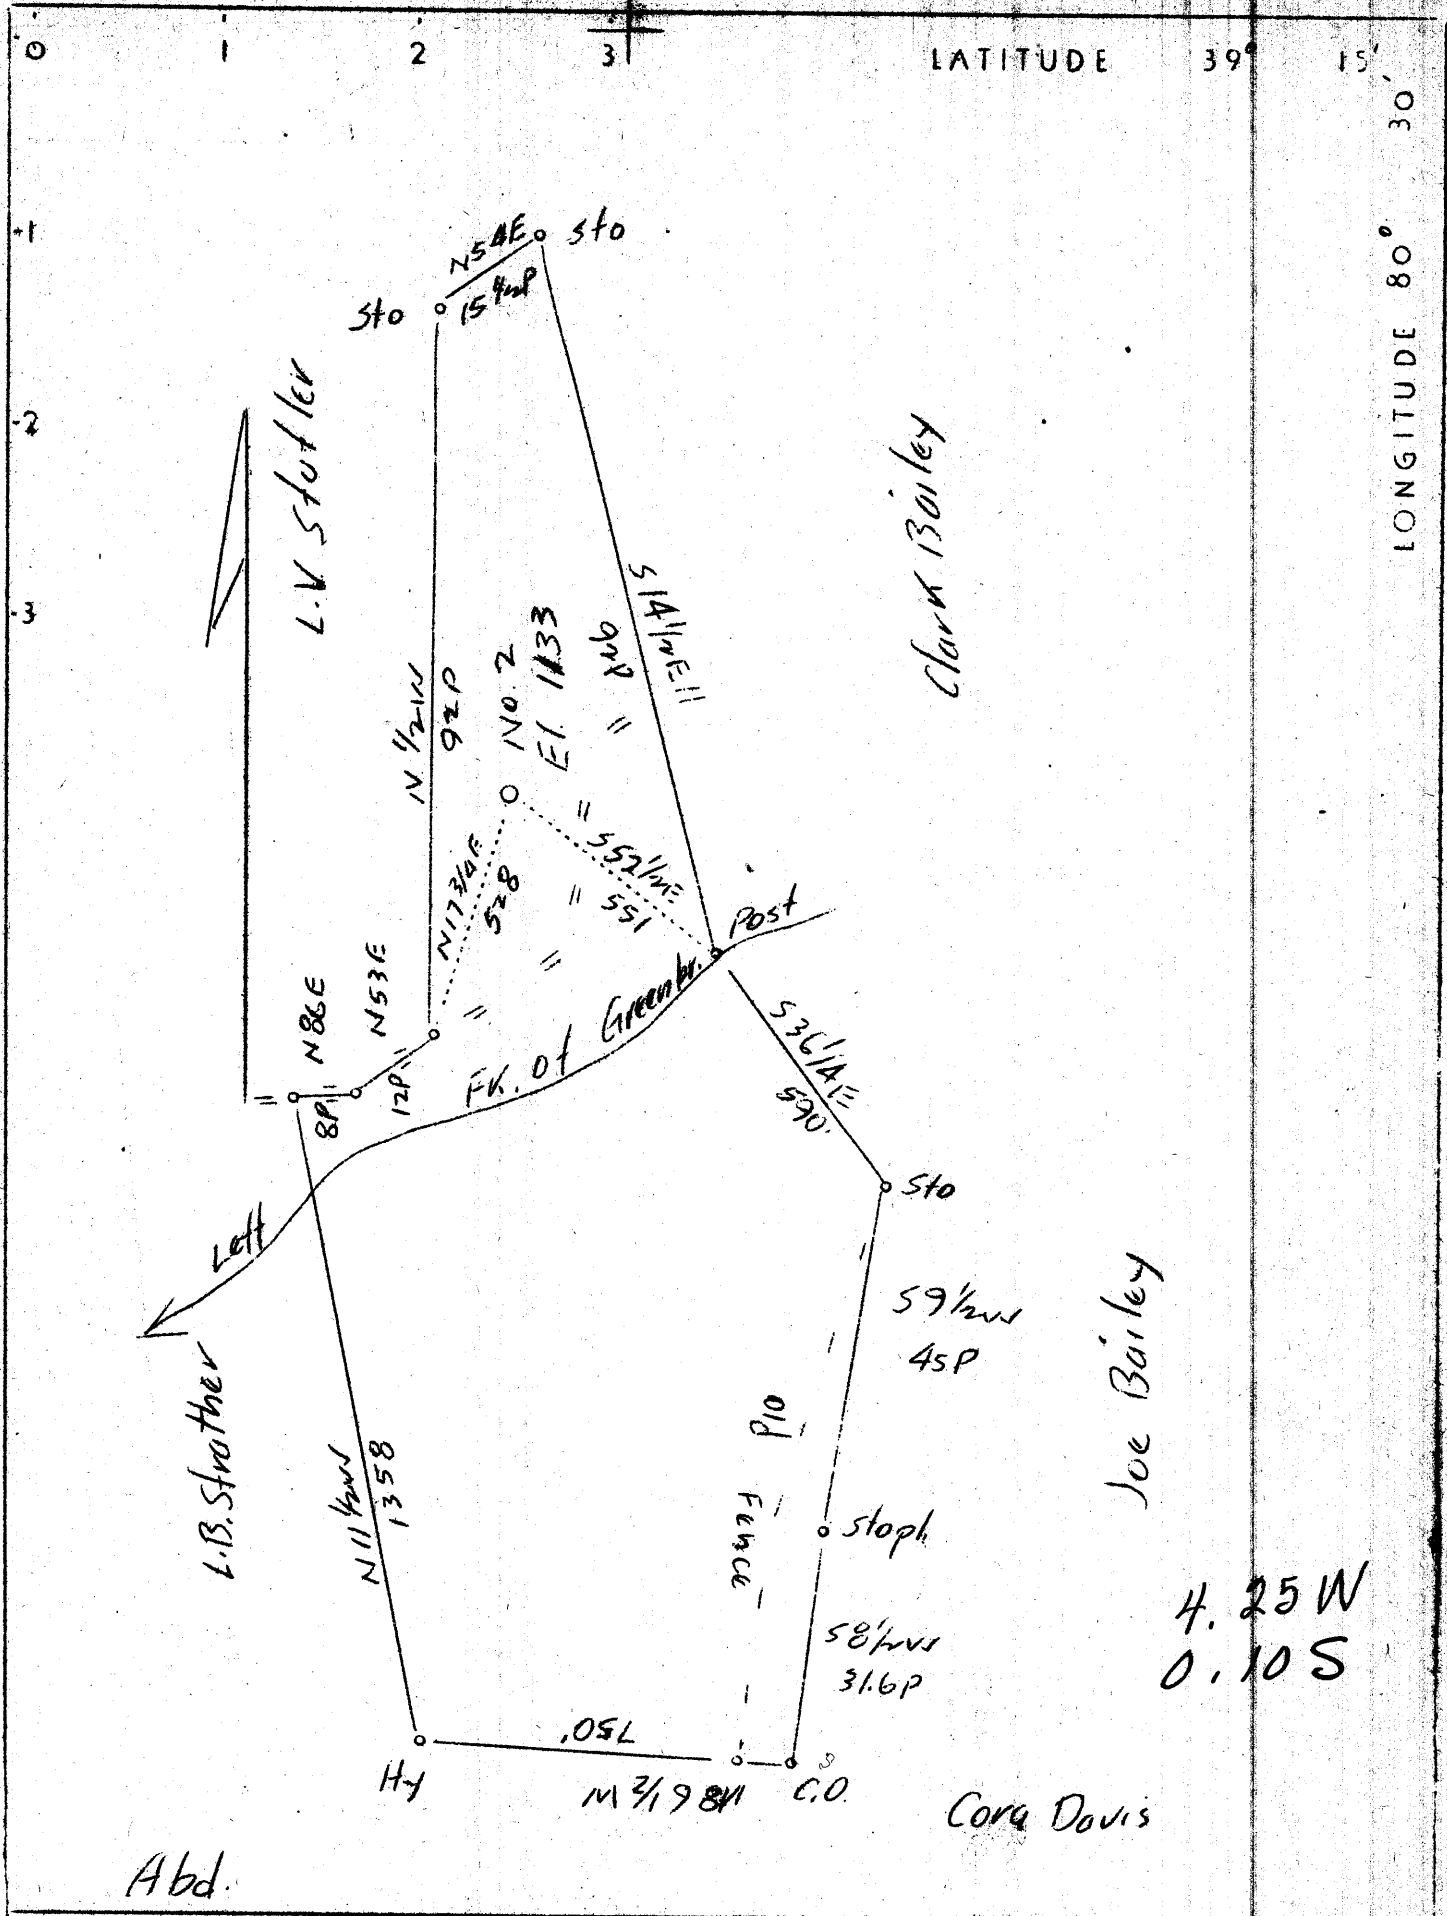

Abd.

Company	Reed and Moses
Address	Salem, W.Va.
Farm	Etta Bailey
Tract	Acres 47 Lease No.
Well (Farm) No.	2 Serial No.
Elevation ( Spirit Level)	1133
Quadrangle	Vadis 3 NAM
County	Doddridge District Greenbrier
Engineer	C.C. Fitts, C.E.
Engineer's Registration No.	818
File No.	XYZ Drawing No. 100
Date	Feb. 1, 1938 Scale 1"=400'

STATE OF WEST VIRGINIA  
 Department of Mines  
 OIL AND GAS DIVISION  
 CHARLESTON

WELL LOCATION MAP  
 File No. DOD-210A

+ Denotes location of well on United States Topographic Maps, scale 1 to 62,500, latitude and longitude lines being represented by border lines as shown.

— Denotes one inch spaces on border line of original tracing.