


LATITUDE 39° 10'

LONGITUDE 80° 40'

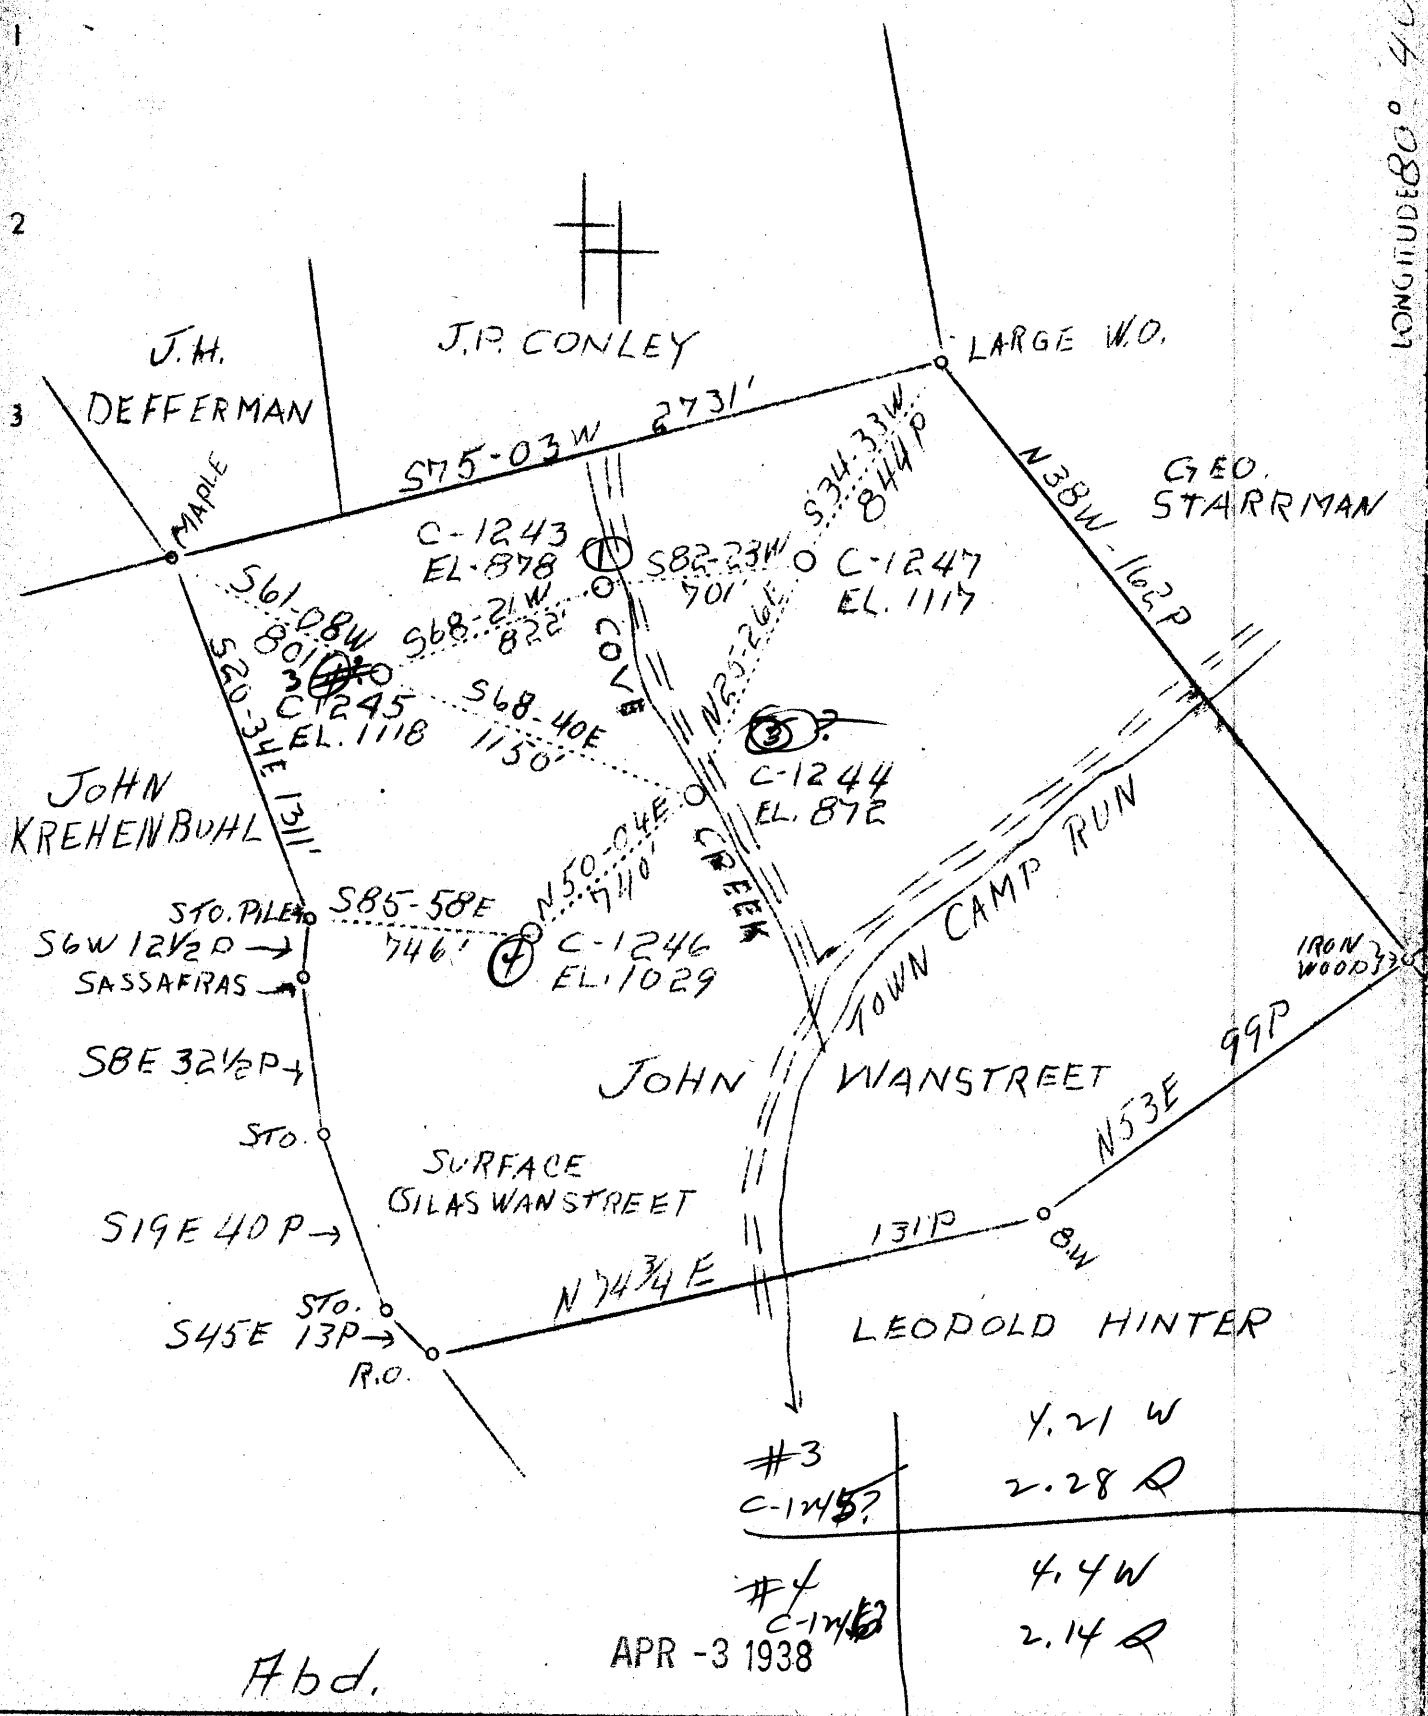

Company Hope Const'r & Ref. Co.
 Address Clarksburg, W.Va.
 Farm John Wanstreet
 Tract 1 Acres 215 Lease No. C-1245, C-1246
 Well (Farm) No. 3 & 4 Serial No. 1247, C-1246, 1244
 Elevation (Spirit Level) 1118, 878, 1029, 872, 1117
 Quadrangle Vadis
 County Doddridge District Cove
 Engineer W.M. Bowers
 Engineer's Registration No. 900
 File No. _____ Drawing No. _____
 Date Mar. 29 1938 Scale 1" = 40 Poles

STATE OF WEST VIRGINIA
 Department of Mines
 OIL AND GAS DIVISION
 CHARLESTON

WELL LOCATION MAP

File No. Dod-211-a & 212

Denotes location of well on United States Topographic Maps, scale 1 to 62,500, latitude and longitude lines being represented by border lines as shown.

Denotes one inch spaces on border line of original tracing.

WC