


LATITUDE 39° 15'

LONGITUDE 80° 40'

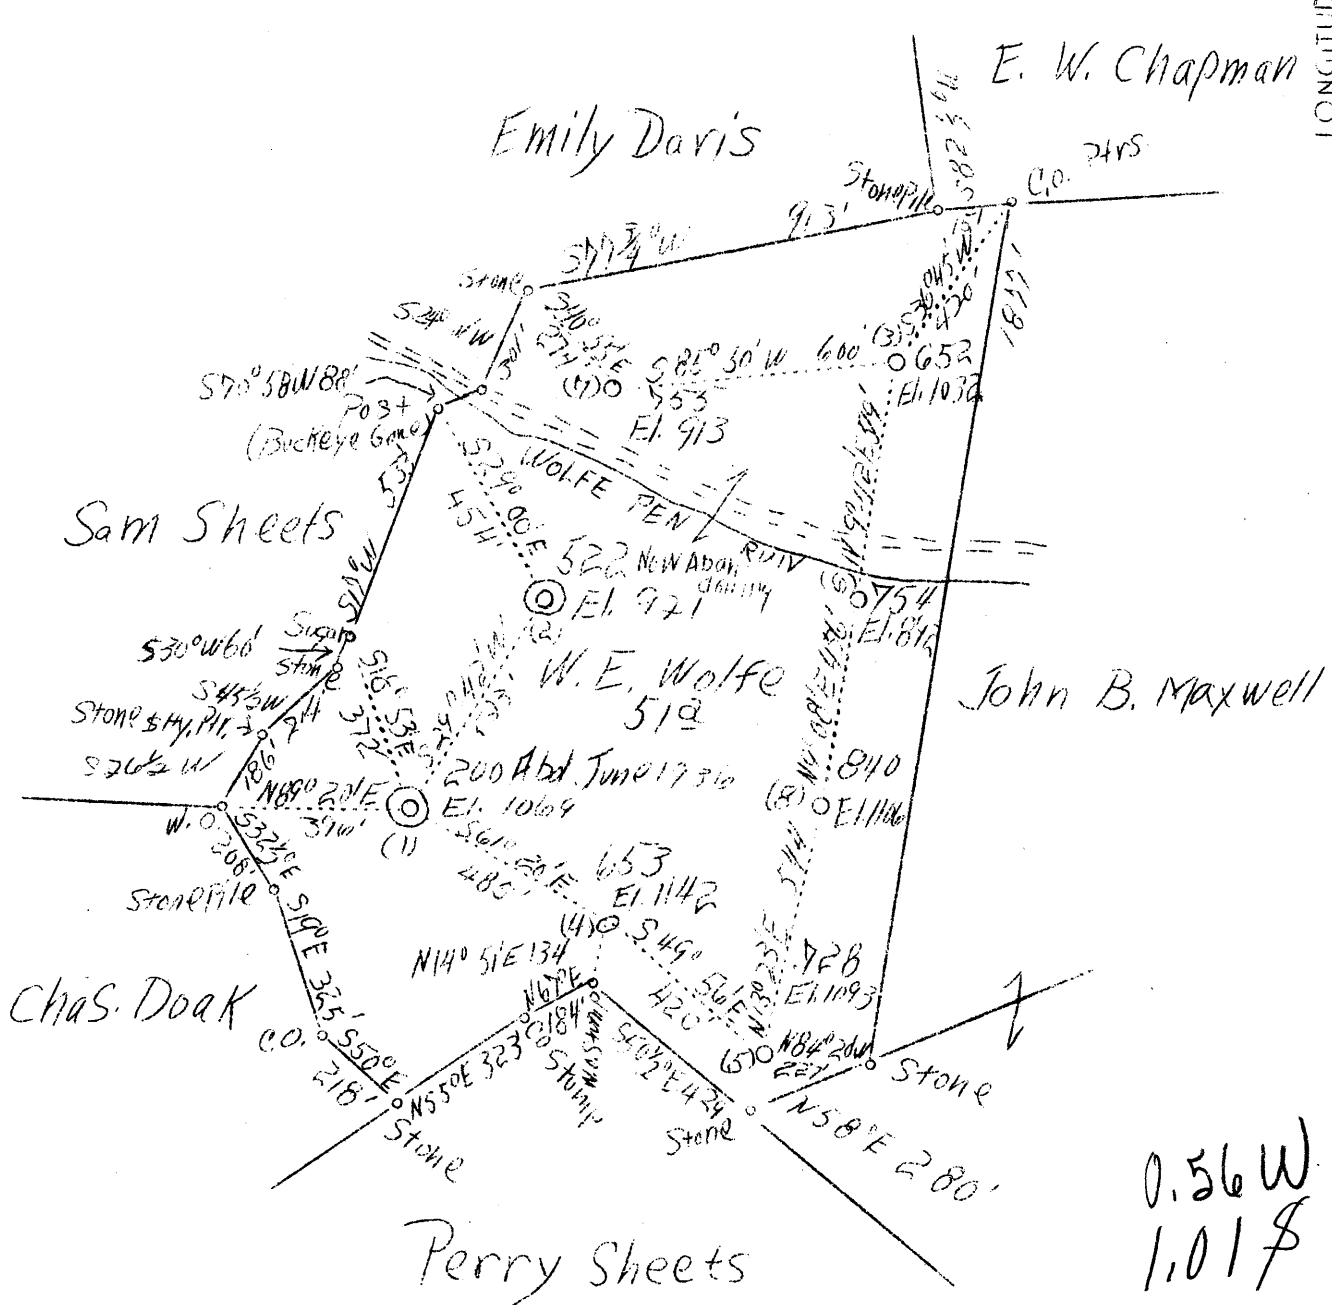

0.56 W
1.01 \$

Abd.

Company Hope Constr. & Ref. Co.	STATE OF WEST VIRGINIA Department of Mines OIL AND GAS DIVISION CHARLESTON
Address Clarksburg, W. Va.	
Farm W. E. Wolfe	WELL LOCATION MAP File No. <u>Dod-213-A</u>
Tract Acres 51 Lease No. 920	
Well No. (Farm) 4 Serial No. 652-653	Denotes location of well on United States Topographic Maps, scale 1 to 62,500, latitude and longitude lines being represented by border lines as shown.
Elevation (Spirit Level) 728, 754, 755, 840	
Quadrangle Vadis <u>N.W.</u> 892, 913, 1106	Denotes one inch spaces on border line of original tracing.
County Doddridge District New Milton	
Engineer W.M. Bowers	
Engineer's Registration No. 900	
File No. _____ Drawing No. _____	
Date Marc. 18, 1938 Scale 1"=400'	