


W

LATITUDE 39° 25'

LONGITUDE 80° 40'

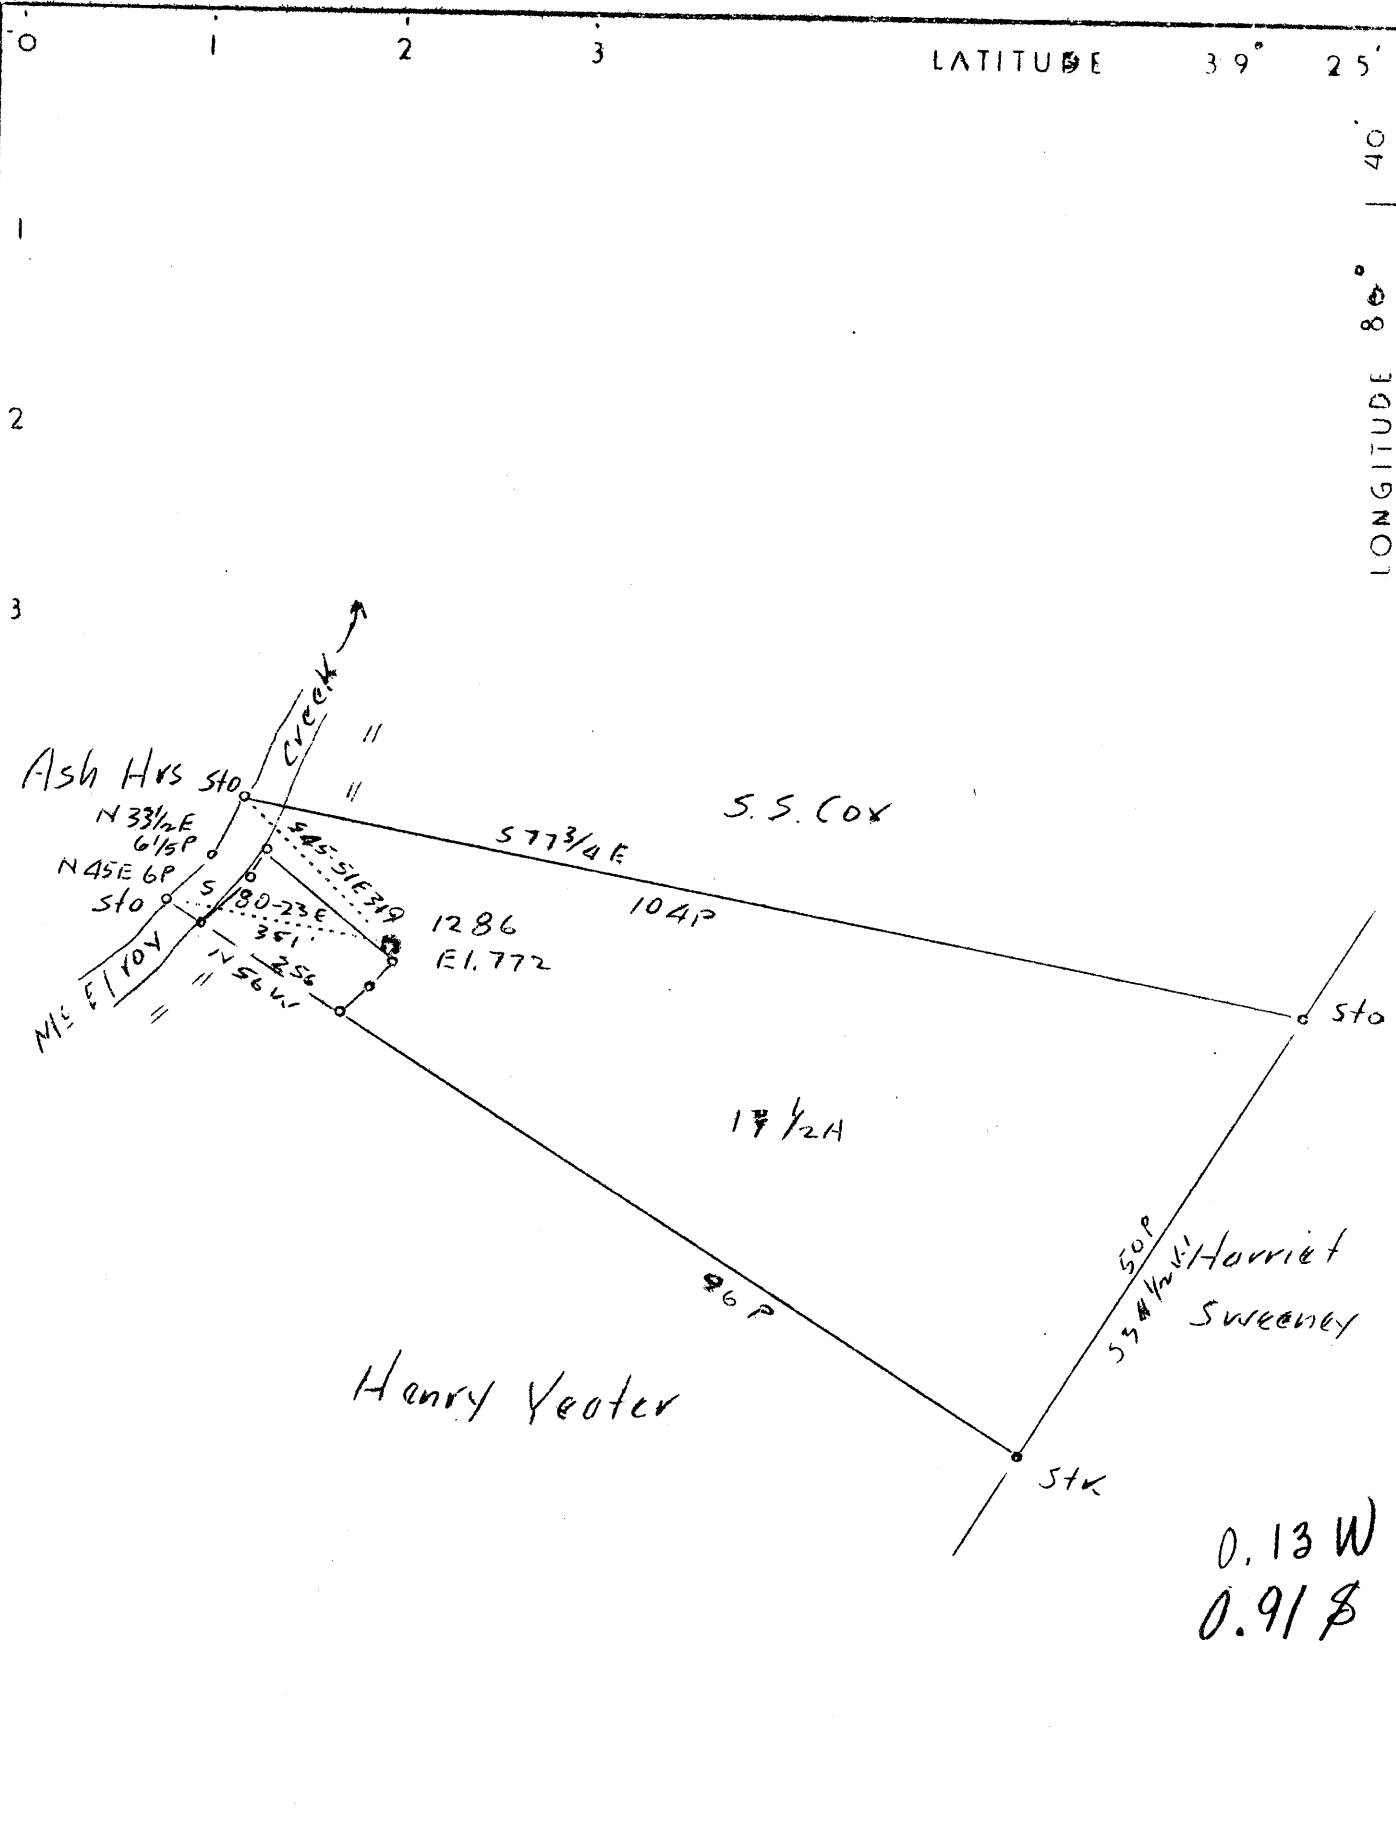

Abd.

F.B. 506 Pg 35-6

Company	Hope Constr. & Ref. Co.
Address	Clarksburg, W.Va.
Farm	Rebecca Williams
Tract	Acres 17 1/2 Lease No. 5659
Well (Farm) No.	1 Serial No. 1286
Elevation (Spirit Level)	772
Quadrangle	Centerpoint W.C.
County	Boydridge District McClellan
Engineer	J.W. Clark
Engineer's Registration No.	744
File No.	Drawing No.
Date	Apr. 5, 1938 Scale 1"=300'

STATE OF WEST VIRGINIA
 Department of Mines
 OIL AND GAS DIVISION
 CHARLESTON

WELL LOCATION MAP
 File No. DOD-215A

Denotes location of well on United States Topographic Maps, scale 1 to 62,500, latitude and longitude lines being represented by border lines as shown.

Denotes one inch spaces on border line of original tracing.