


M

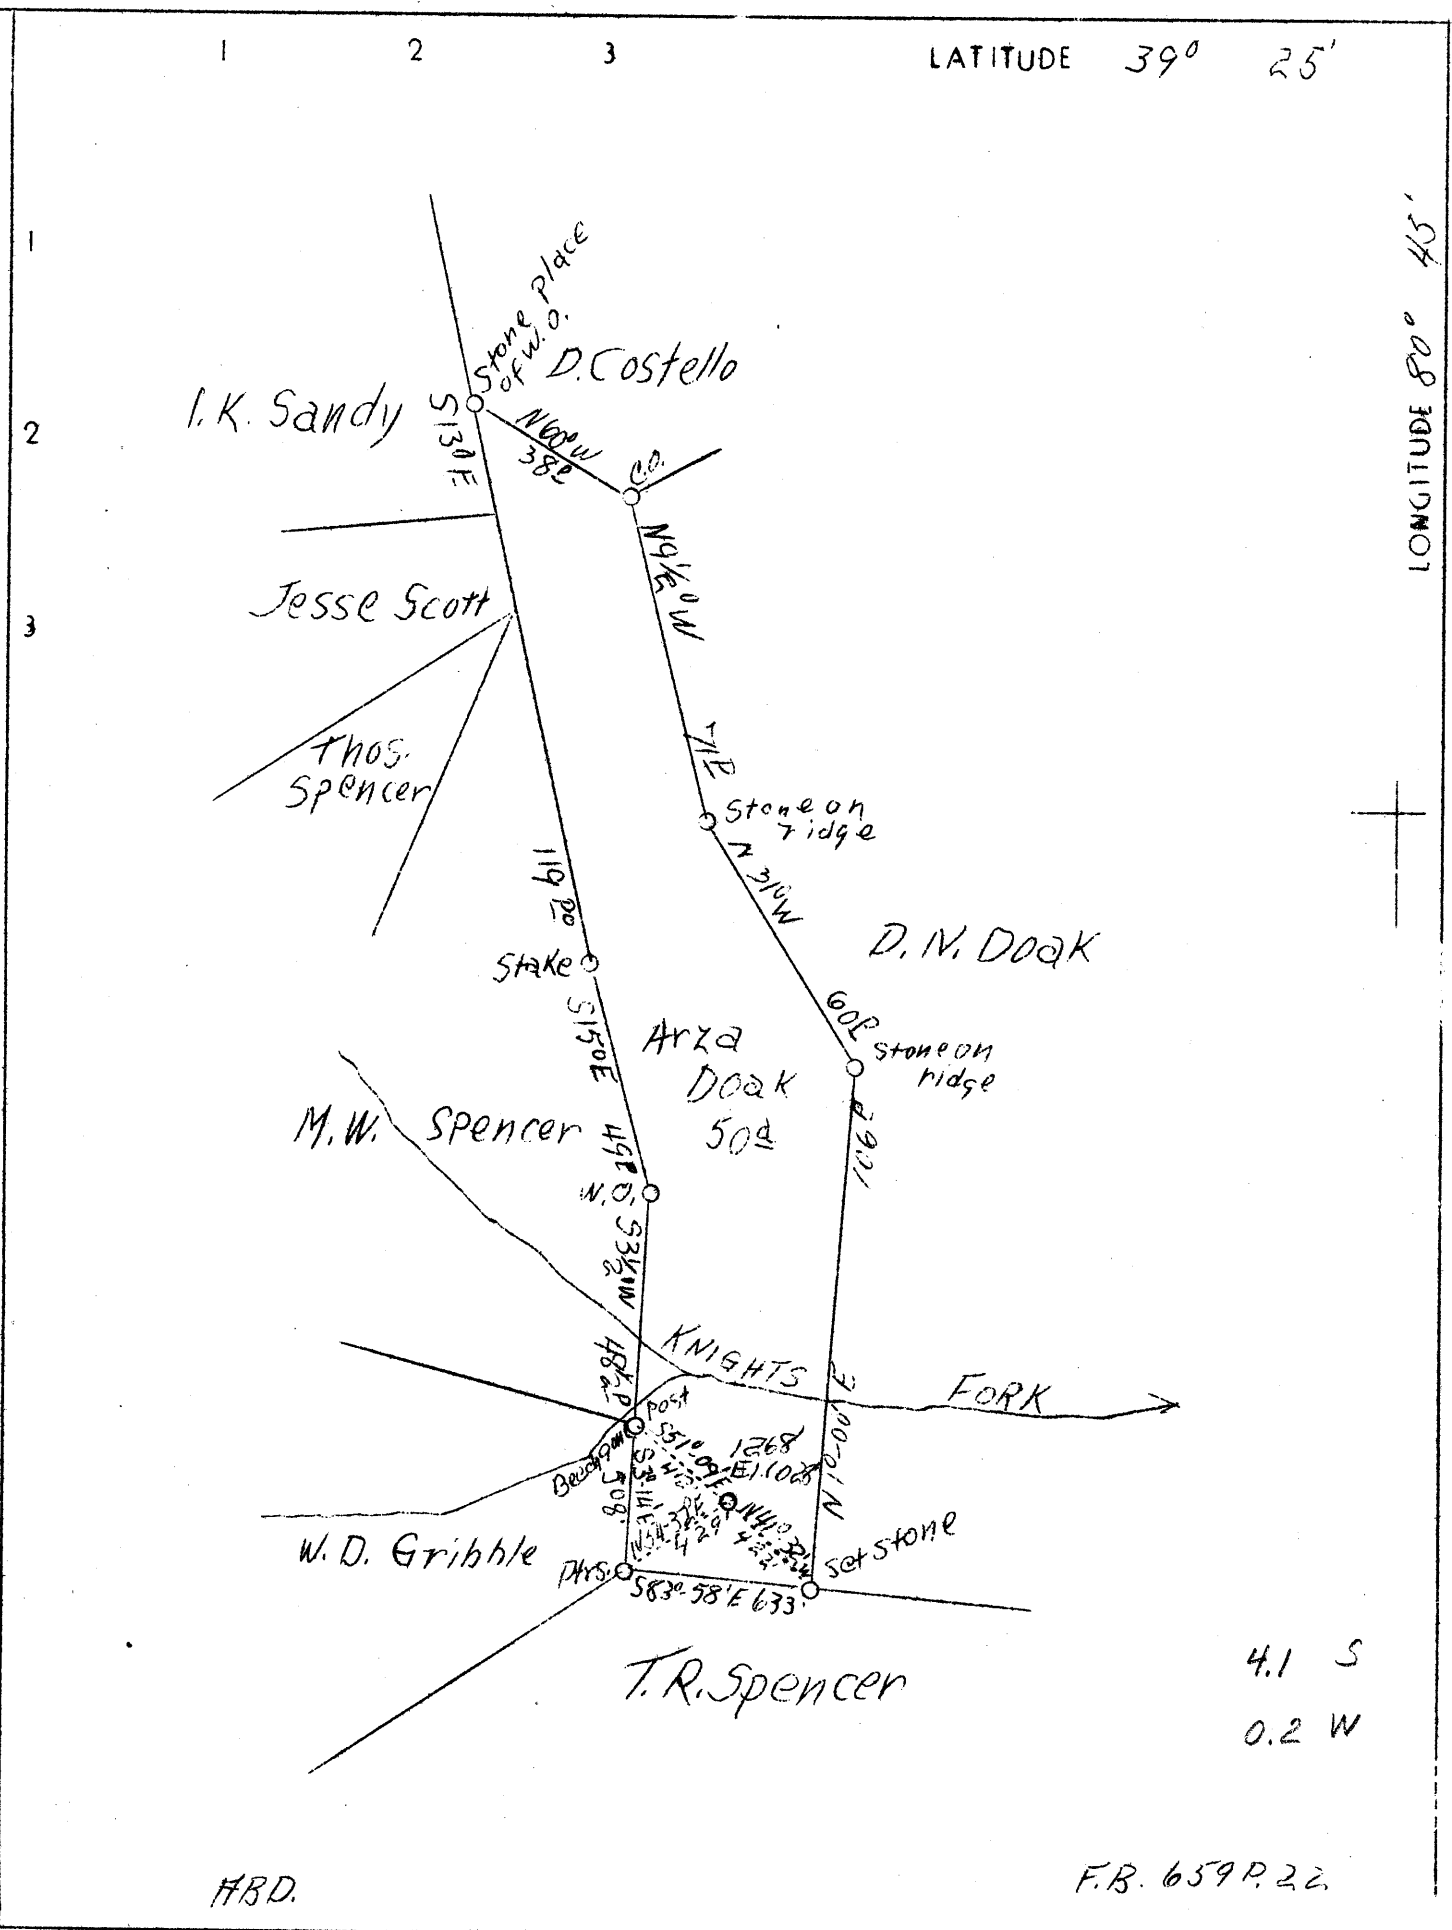

H.B.D.

F.B. 659 P. 22

Company	Hope Construction & Ref. Co.
Address	Clarksburg, W. Va.
Farm	Arza Doak
Tract	Acres 50 Lease No. 5650
Well (Farm) No.	Serial No. 1268
Elevation (Spirit Level)	1028
Quadrangle	West Union F.C.
County	Doddridge District Grant
Engineer	W.M. Bowers
Engineer's Registration No.	900
File No.	Drawing No.
Date	April 15, 1938 Scale 1"-40 P.

STATE OF WEST VIRGINIA  
 Department of Mines  
 OIL AND GAS DIVISION  
 CHARLESTON

WELL LOCATION MAP  
 File No. Dod-216-A

Denotes location of well on United States Topographic Maps, scale 1 to 62,500, latitude and longitude lines being represented by border lines as shown.

Denotes one inch spaces on border line of original tracing.