


39° 12' 30"

LATITUDE

80° 45'

LONGITUDE

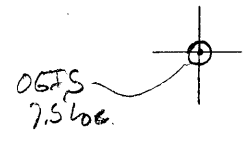

7.5 OGIS topo location

7.5' loc. 0.75S 15' loc. _____
 0.48W (calc.) _____

Company _____

Farm _____

Quad Oxford 1/2 _____

County _____

District Southwest _____

WELL LOCATION MAP

File No. 017 - 30222

WEST VIRGINIA DEPARTMENT OF MINES
OIL AND GAS DIVISION

177

WELL RECORD

Permit No. 222 A


Oil or Gas Well Oil
(Kind)

Company Hope Construction & Refining Company
 Address Clarksburg, W. Va.,
 Farm W. Minter Stout Acres 340
 Location (waters) South Fork Hughes River
 Well No. 1343 Elev. 1010
 District Southwest County Doddridge
 The surface of tract is owned in fee by _____
 Address _____
 Mineral rights are owned by _____
 Address _____
 Drilling commenced 9-30-1899
 Drilling completed 12-12-1899
 Date shot Last. 3-9-1933 Depth of shot In Gordon
 Open Flow /10ths Water in _____ Inch
 /10ths Merc. in _____ Inch
 Volume _____ Cu. Ft.
 Rock Pressure _____ lbs _____ hrs.
 Oil _____ bbls., 1st 24 hrs.
 Fresh water None recorded feet _____ feet
 Salt water None recorded feet _____ feet

Casing and Tubing	Used in Drilling	Left in Well	Packers
Size			
16			Kind of Packer
13			
10	300	Pulled	Size of
8 1/4	1000	Pulled	
6 5/8	1850	1850	Depth set
5 3/16			
3			Perf. top
2	2446	2446	Perf. bottom
Liners Used			Perf. top
			Perf. bottom

CASING CEMENTED _____ SIZE _____ No. FT. _____ Date _____
 Not cemented _____
 COAL WAS ENCOUNTERED AT _____ FEET _____ INCHES
 _____ FEET. No coal _____ FEET _____ INCHES
 _____ FEET _____ INCHES _____ FEET _____ INCHES

Formation	Color	Hard or Soft	Top	Bottom	Oil Gas or Water	Depth Found	Remarks
Red Rock Cave			750	950			
Cow Run Sand			1000	1025			
First Salt Sand			1200	1400	show oil	1200	
Maxon Sand			1590	1610			
Little Lime			None recorded				
Pencil Cave			1710	1715			
Big Lime			1715	1787			
Big Injun Sand			1787	1840	1850' - 6 5/8"		
Gordon stray sand			2400	2418			
Gordon Sand			2423	2428	Oil	2423	
Total depth			2446				

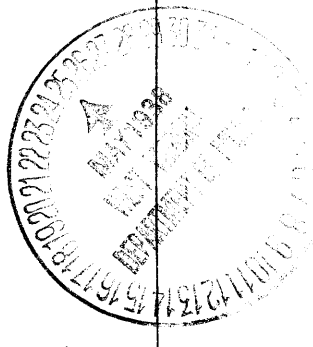

expl. 2204
W.M.S.

Southwest District, Doddridge County, W. Va.
 By Hope Construction & Refining Co., Clarksburg, W. Va.
 On 340 acres, on South Fork of Hughes River.
 Elevation, 1010' L.
 Drilling commenced 9-30-1899; completed, 12-21-1899.
 Last shot, 3-9-1933, in Gordon Sand.
 No water recorded.
 10" casing, 300' (pulled); 8 $\frac{1}{4}$ " , 1000' (pulled); 6 $\frac{5}{8}$ " , 1850';
 2" tubing, 2446'.
 Casing not cemented. No coal was encountered.
 Oil well. Abandonment reported to Dept. of Mines May 24, 1938.
 Record to RCT from Mrs. Griffith May 27, 1938.

	Top.	Bottom.
Red rock cave	750	950
Cow Run Sand	1000	1025
First Salt Sand (show oil, 1200')	1200	1400
Maxton Sand	1590	1610
Little Lime	None recorded	
Pencil Cave	1710	1715
Big Lime	1715	1787
Big Injun Sand	1787	1840
Gordon Stray Sand	2400	2418
Gordon Sand (oil, 2423')	2423	2428
Total depth		2446