

4.32 W
3.4 S

ABD. 1342

FB. 653 P 35436

Company	Hope Constr. & Ref. Co.
Address	Clarksburg, W. Va.
Farm	W. Minter Stout
Acres	340
Lease No.	6193
Well (Farm) No.	-
Serial No.	1301-1302-1343-1344-1345- <u>1347</u> -1349-1351
Elevation (SP)	1126-1149-1010-1273-1151- <u>1268</u> -1000-1108
Quadrangle	Vadis <i>NW</i>
County	Doddridge
District	Southwest
Engineer	W. M. Bowers - Reg. #900
Date	April 28, 1938
Scale	1" = 40 poles

STATE OF WEST VIRGINIA
Department of Mines
OIL & GAS DIVISION
Charleston

WELL LOCATION MAP

File No. Dod-239-A
WELL # 1347

x Denotes location of well on U. S. Topographic Maps, scale 1 to 62,500, latitude and longitude lines being represented by border lines as shown.

- Denotes one inch spaces on border line of original tracing.

WEST VIRGINIA DEPARTMENT OF MINES
OIL AND GAS DIVISION

192

WELL RECORD

AP Permit No. 239A


Oil or Gas Well...
(Kind)

Company Hope Construction & Refining Company
 Address Clarksburg, W. Va.
 Farm W. Minter Stout Acres 340
 Location (waters) South Fork Hughes River
 Well No. 1347 Elev. 1268
 District Southwest County Doddridge
 The surface of tract is owned in fee by W. Minter Stout
R #1. Address Blandville, W. Va.
 Mineral rights are owned by.....
 Address.....
 Drilling commenced April 13, 1901
 Drilling completed May 31, 1901
 Date shot 12-24-1908 Depth of shot Gordon
 Open Flow /10ths Water in..... Inch
 /10ths Merc. in..... Inch
 Volume..... Cu. Ft.
 Rock Pressure..... lbs..... hrs.
 Oil..... bbls., 1st 24 hrs.
 Fresh water None recorded feet..... feet
 Salt water 1400 feet..... feet

Casing and Tubing	Used in Drilling	Left in Well	Packers
Size			
16			Kind of Packer.....
13			
10	555	Pulled	Size of.....
8 1/4	1250	Pulled	
6 5/8	2020	2020	Depth set.....
5 3/16			
3			Perf. top.....
2	2697	2697	Perf. bottom.....
Liners Used.....			Perf. top.....
			Perf. bottom.....

CASING CEMENTED..... SIZE..... No. FT..... Date.....
Not cemented
 COAL WAS ENCOUNTERED AT..... FEET..... INCHES
No coal
 FEET..... INCHES..... FEET..... INCHES
 FEET..... INCHES..... FEET..... INCHES

Formation	Color	Hard or Soft	Top	Bottom	Oil Gas or Water	Depth Found	Remarks
Red Rock Cave			900	1200			
Cow Run Sand			1250	1285			
Salt Sand			1400	1500	Water	1400	
Maxon Sand			1825	1850			
Big Lime			1965	2040			
Big Injun Sand			2040	2130	Gas	2058	
Gordon Sand			2673	2678	Oil	2673	
			<u>Total Depth</u>	2698			

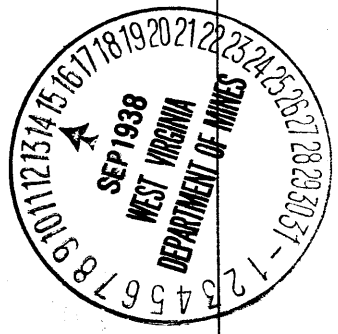

Southwest District, Doddridge County, W. Va.
 By Hope Construction & Refining Co., Clarksburg, W.Va.
 On 340 acres, on South Fork of Hughes River.
 Elevation, 1268' L.
 Surface owned by W. Minter Stout, Route 1, Blandville, W. Va.
 Drilling commenced April 13, 1901; completed, May 31, 1901.
 Shot Dec. 24, 1908, in Gordon Sand.
 No fresh water recorded. Salt water at 1400'.
 10" casing, 555' (pulled); 8 $\frac{1}{4}$ " , 1250' (pulled); 6 $\frac{5}{8}$ " , 2020';
 2" tubing, 2697'.
 Casing not cemented. No coal was encountered.
 Oil well. Abandonment reported to Dept. of Mines Sept. 13, 1938.
 Record to RCT from Mrs. Griffith Sept. 22, 1938.

	Top.	Bottom.
Red rock cave	900	- 1200
Cow Run Sand	1250	- 1285
Salt Sand (water, 1400')	1400	- 1500
Maxton Sand	1825	- 1850
Big Lime	1965	- 2040
Big Injun Sand (gas, 2058')	2040	- 2130
Gordon Sand (oil, 2673')	2673	- 2678
Total depth		2698