


39° 12' 30"

LATITUDE

53.02

LONGITUDE

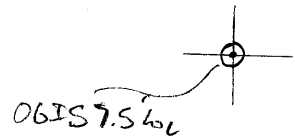

7'5 OGIS topo location

7.5' loc 2.40 S 15' loc _____
 ' 0.41 W (calc.) _____

Company _____

Farm _____

Quad Oxford 7.5' _____

County _____

District Southwest _____

WELL LOCATION MAP

File No. 017-30241

WEST VIRGINIA DEPARTMENT OF MINES
OIL AND GAS DIVISION

188

WELL RECORD

Permit No. 900-241-A


Oil or Gas Well 011
(Kind)

Company Hope Construction & Refining Company
Address Clarksburg, W. Va.
Farm S. W. Stout Acres 1427
Location (waters) South Fork Hughes River
Well No. 1322 Elev. 1124
District Southwest County Doddridge
The surface of tract is owned in fee by S. W. Stout
Address Parkersburg, W. Va.
Mineral rights are owned by _____
Address _____
Drilling commenced 3-13-1900
Drilling completed 4-30-1900
Date shot 11-8-1928 Depth of shot 2661-2671
Open Flow /10ths Water in _____ Inch
/10ths Merc. in _____ Inch
Volume _____ Cu. Ft.
Rock Pressure _____ lbs. _____ hrs.
Oil _____ bbls., 1st 24 hrs.
Fresh water None recorded feet _____ feet
Salt water None recorded feet _____ feet

Casing and Tubing	Used in Drilling	Left in Well	Packers
Size			Kind of Packer
16			
13			
10	600	Pulled	Size of
8 1/4	1230	Pulled	
6 5/8	1965	1965	Depth set
5 3/16			
3			Perf. top
2	2691	2691	Perf. bottom
Liners Used	650	650	Perf. top
			Perf. bottom

CASING CEMENTED _____ SIZE _____ No. FT. _____ Date _____
Not cemented
COAL WAS ENCOUNTERED AT _____ FEET _____ INCHES
No coal
_____ FEET _____ INCHES _____ FEET _____ INCHES
_____ FEET _____ INCHES _____ FEET _____ INCHES

Formation	Color	Hard or Soft	Top	Bottom	Oil Gas or Water	Depth Found	Remarks
Red Rock Cave			900	1200			
Cow Run Sand			1230	1280			
Salt Sand			1450	1650			
Maxon Sand			1840	1865			
Big Lime			1965	2040			
Big Injun Sand			2040	2135			
Gordon Stray Sand			2645	2649			
Gordon Sand			2664		011	2664	
Total Depth				2696			

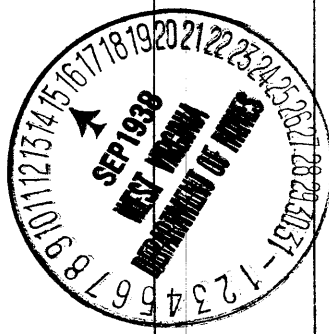

Formation	Color	Hard or Soft	Top	Bottom	Oil, Gas or Water	Depth Found	Remarks

Date.....September 14,....., 19..38

APPROVED Hope Construction & Refining Co., Owner

By.....*[Signature]*..... Asst. General Supt.
 (Title) *[Signature]*

Southwest District, Doddridge County, W. Va.
 By Hope Construction & Refining Co., Clarksburg, W. Va.
 On 1427 acres, on South Fork of Hughes River.

Elevation, 1124' L.

Surface owned by S. W. Stout, Parkersburg, W. Va.

Drilling commenced 3-13-1900; completed, 4-30-1900.

Shot 11-5-1926, at 2661-2671'.

No water recorded.

10" casing, 600' (pulled); 8 $\frac{1}{2}$ " 1230' (pulled); 6 $\frac{3}{8}$ " 1965';
 4" 650'; 2" tubing, 2691'.

Casing not cemented.

No coal was encountered.

Oil well. Abandonment reported to Dept. of Mines Sept. 14, 1938.

Record to ROT from Mrs. Griffith Sept. 22, 1938.

	Top.	Bottom.
Red rock cove	900	- 1200
Cow Run Sand	1230	- 1280
Salt Sand	1450	- 1650
Maxton Sand	1840	- 1865
Big Line	1965	- 2040
Big Injun Sand	2040	- 2135
Gordon Stray Sand	2645	- 2649
Gordon Sand (oil, 2664')	2664	-
Total depth		2696