

LATITUDE 39° 15'


LONGITUDE 80° 45'

BRUCE BARNETT

L. W. PEARCY HRS.

R. H. BARNETT

JAS. MAXWELL

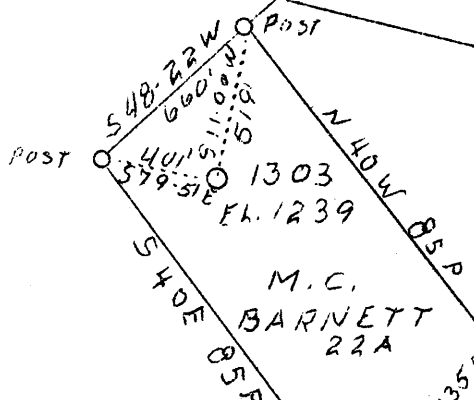

BARNETT HRS.

S. W. STOUT

B. A. COPLIN

G. W. WATSON

12 W
4.525

ABD.

F. O. 655 P 34, 35

Company	Hope Const. & Ref.
Address	Clarksburg, 7.Va.
Farm	M.C. Barnett
Tract	2
Acres 2	22
Lease No.	5669
Serial No.	1303
Elev. (Spirit Level)	1239
Quadrangle	Holbrook N.E.
County	Doddridge
District	Southwest
Eng.	W.M. Bowers
Eng. Reg. No.	900
Date	2 - 15 - 38
Scale	1" - 40 Po.

STATE OF WEST VIRGINIA
 Department of Mines
 OIL AND GAS DIVISION
 Charleston

x Denotes location of well on U. S. Topographic Maps, scale 1 to 62,500, latitude and longitude lines being represented by border lines as shown.

- Denotes one inch spaces on border line of original tracing.

WEST VIRGINIA DEPARTMENT OF MINES
OIL AND GAS DIVISION

195

WELL RECORD

AD 244-A
Permit No. 244-A

Oil or Gas Well Oil
(Kind)

Company Hope Construction & Refining Company
 Address 445 West Main Str. Clarksburg, W. Va.
 Farm M.C. Barnett Acres 22
 Location (waters) SF Hughes River
 Well No. 1303 Elev. 1339
 District Southwest County Doddridge
 The surface of tract is owned in fee by.....
 Address.....
 Mineral rights are owned by.....
 Address.....
 Drilling commenced March 29, 1900
 Drilling completed May 28, 1900
 Date shot April 27, 1927 Depth of shot 40
 Open Flow /10ths Water in..... Inch
 /10ths Merc. in..... Inch
 Volume..... Cu. Ft.
 Rock Pressure..... lbs..... hrs.
 Oil..... bbls., 1st 24 hrs.
 Fresh water None recorded feet..... feet
 Salt water None recorded feet..... feet

Casing and Tubing	Used in Drilling	Left in Well	Packers
Size			
16			Kind of Packer
13			
10	620'	Pulled	Size of
8 1/4	1285'	Pulled	
6 5/8	1665'	1665'	Depth set
5 3/16	2270'	2270'	
3			Perf. top
2	2791'	2791'	Perf. bottom
Liners Used			Perf. top
			Perf. bottom

Not Cemented
 CASING CEMENTED..... SIZE..... No. FT..... Date.....
No Coal
 COAL WAS ENCOUNTERED AT..... FEET..... INCHES
 FEET..... INCHES..... FEET..... INCHES
 FEET..... INCHES..... FEET..... INCHES

Formation	Color	Hard or Soft	Top	Bottom	Oil Gas or Water	Depth Found	Remarks
Red Rock			950	1200			
First Cow Run			1285	1325			
First Salt Sand			1550	1665			
Maxon Sand			1900	1925			
Big Lime			2030	2125			
Big Injun Sand			2125	2225	Gas	2125	
Gordon Stray			2753	2763			
Gordon Sand			2764	2771	Oil	2764	
Total Depth				2791			

