


LATITUDE 39° 15'

LONGITUDE 80° 40'

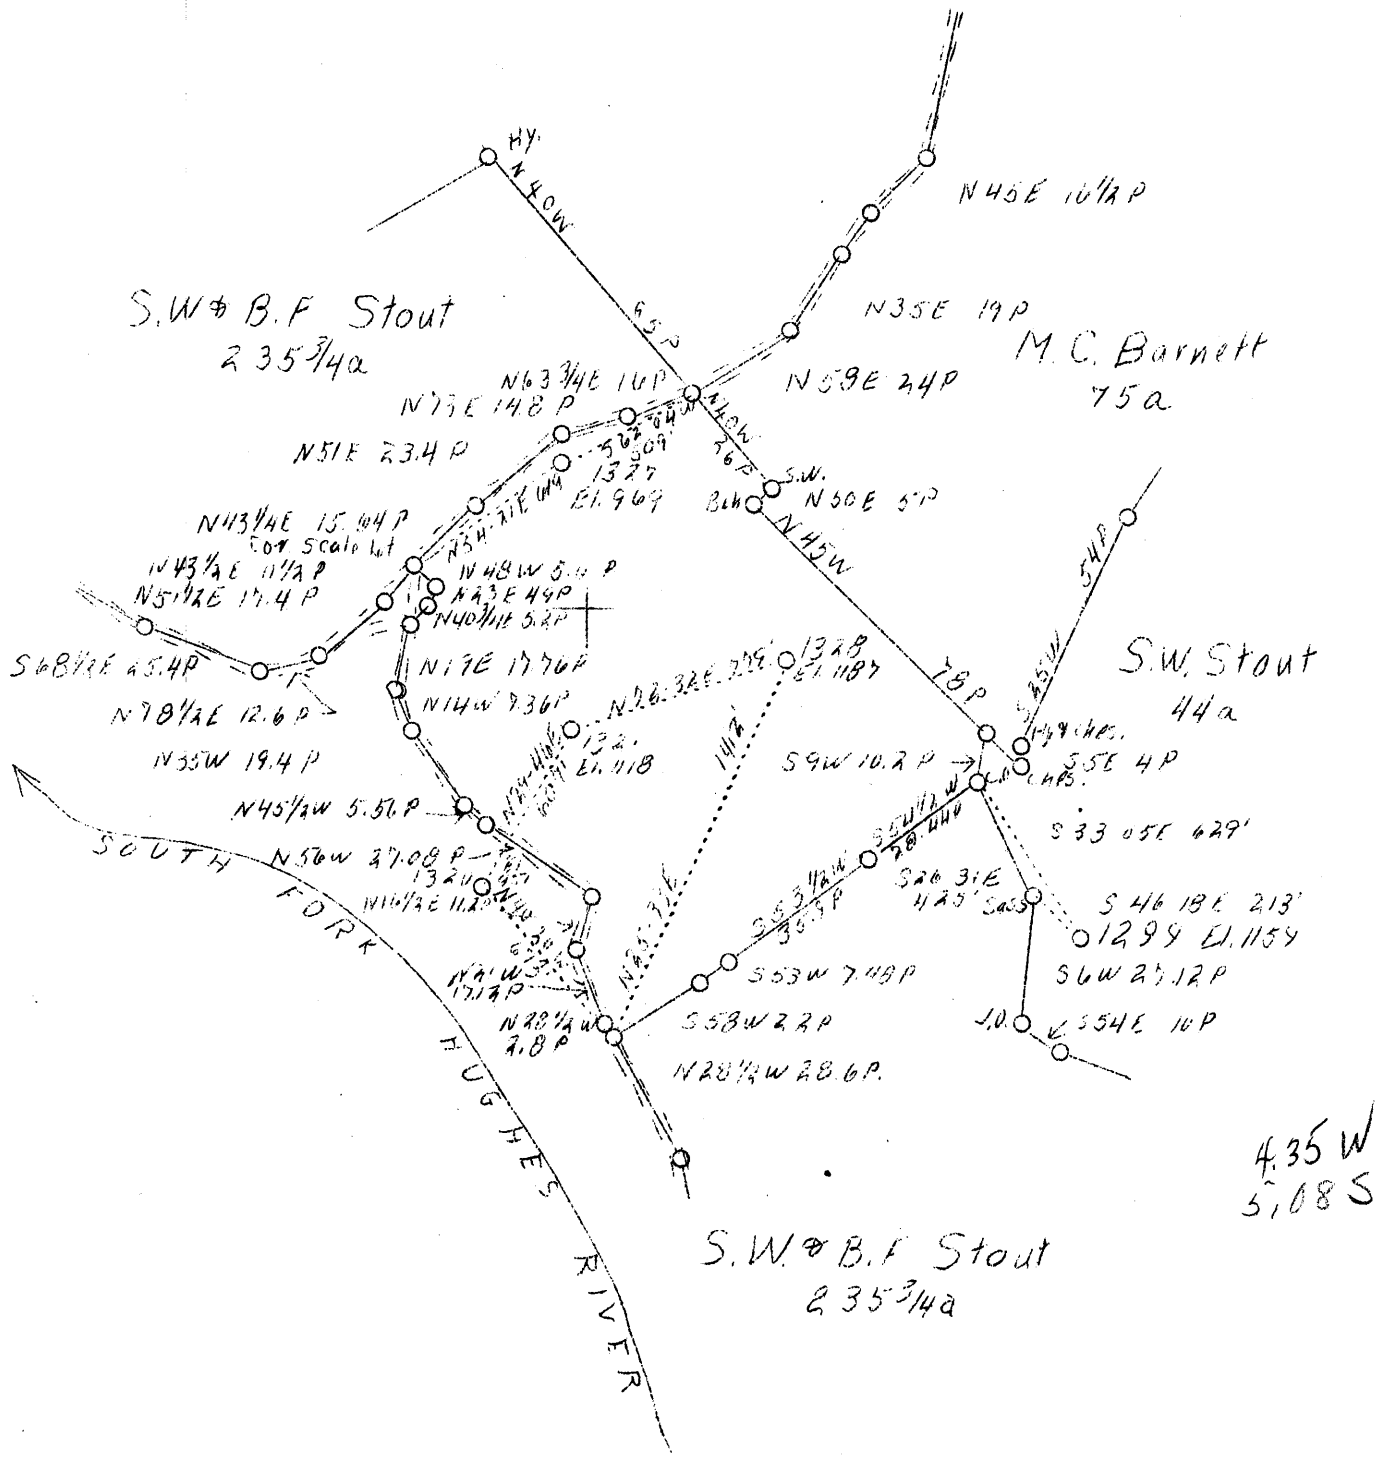

ABD. 1299

F.B. 665 P 19 S 19 WB 54.68

Company	Hope Const. & Ref. Co.
Address	Clarksburg, W. Va.
Farm	S. W. Stout
Acres	1427
Lease No.	C-6197
Well (Farm) No.	39
Serial No.	1299-1327-1328
Elevation (SP)	Shown above <i>NW</i>
Quadrangle	Vadis
County	Doddridge
District	New Milton
Engineer	W. M. Bowers
Eng. Reg. No.	900
Date	Sept. 15, 1938
Scale	1" - 40 poles

STATE OF WEST VIRGINIA
 Department of Mines
 OIL & GAS DIVISION
 Charleston

WELL LOCATION MAP

File No. Dod-249-A

x Denotes location of well on U. S. Topographic Maps, scale 1 to 62,500, latitude and longitude lines being represented by border lines as shown.

- Denotes one inch spaces on border line of original tracing.