


LATITUDE 39°20'

LONGITUDE 80°50'

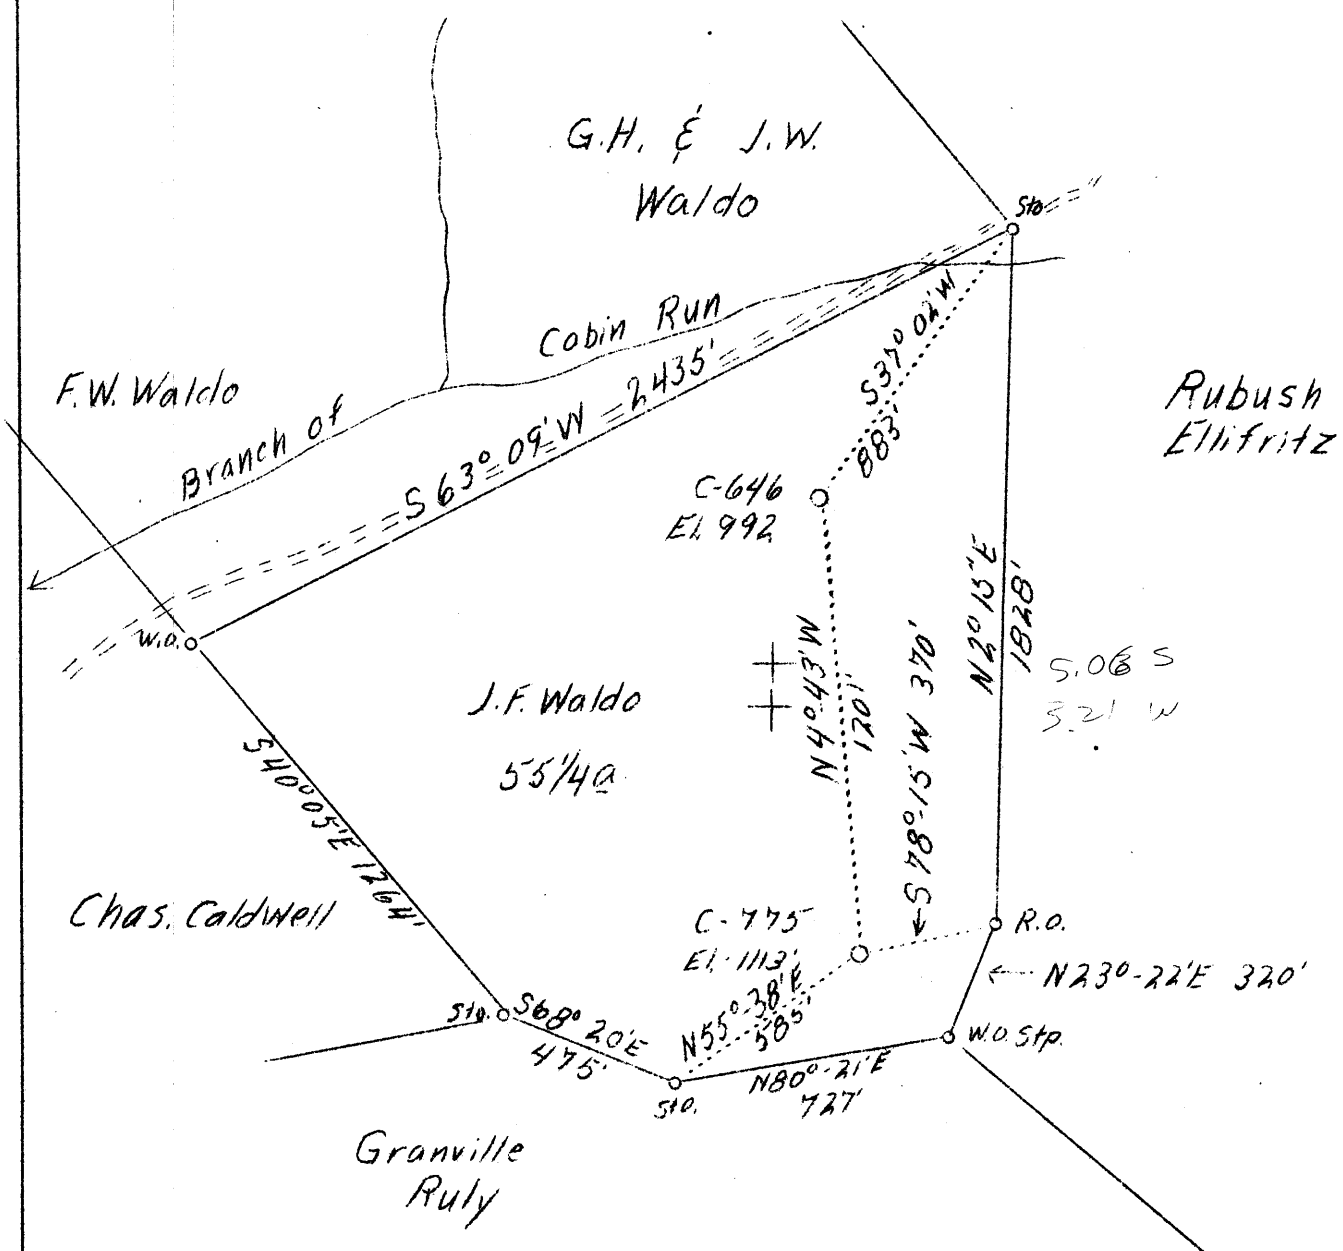

ABD.

C-646

FB 665 P 32-33

| | |
|-----------------|------------------------|
| Company | Hope Const. & Ref. Co. |
| Address | Clarksburg, W. Va. |
| Farm | J. F. Waldo |
| Acres | 55-1/4 |
| Well (Farm) No. | 1-2 |
| Serial No. | C-646 and C-775 |
| Elevation (SL) | See Above |
| Quadrangle | West Union |
| County | Doddridge |
| District | Central |
| Engineer | W. M. Bowers |
| Eng. Reg. No. | 900 |
| Date | March 20, 1939 |
| Scale | 1" = 500' |

STATE OF WEST VIRGINIA
 Department of Mines
 OIL & GAS DIVISION
 Charleston

WELL LOCATION MAP

File No. Mod-279-A

x Denotes location of well on U. S. Topographic Maps, scale 1 to 62,500, latitude and longitude lines being represented by border lines as shown.

- Denotes one inch spaces on border line of original tracing.