

New Location
 Drill Deeper
 Abandonment

Company William Moses
 Address Salem, W. Va.
 Farm Porter Maxwell
 Tract Part Acres 1400 Lease No. _____
 Well (Farm) No. _____ Serial No. _____
 Elevation (Spirit Level) Well 37 Elev. 984 Well 40 Elev. 1100 Well 41 Elev. 1172
 Quadrangle Vadis N.W.
 County Doddridge District New Milton
 Engineer J. M. Martin
 Engineer's Registration No. 84
 File No. _____ Drawing No. _____
 Date Mar 28 1940 Scale 60 Poles 1 inch

STATE OF WEST VIRGINIA
 DEPARTMENT OF MINES
 OIL AND GAS DIVISION
 CHARLESTON

WELL LOCATION MAP
 FILE NO. DOD-310A-311A, 312A
WELLS 37 40 41

+ Denotes location of well on United States Topographic Maps, scale 1 to 62,500, latitude and longitude lines being represented by border lines as shown.
 - Denotes one inch spaces on border line of original tracing.

STATE OF WEST VIRGINIA
DEPARTMENT OF MINES
OIL AND GAS DIVISION

259

WELL RECORD

Permit No. 312A

Oil or Gas Well (Kind)

Company Wm. Moses
 Address 189 W. High St., Salem, W. Va.
 Farm Porter Maxwell Acres 1400
 Location (waters)

Well No. 41 Elev. 1172'
 District New Milton County Doddridge
 The surface of tract is owned in fee by Porter Maxwell
 Address West Union, W. Va.
 Mineral rights are owned by

Drilling commenced

Drilling completed

Date shot

Open Flow /10ths Water in Inch
 /10ths Merc. in Inch


Volume Cu. Ft.
 Rock Pressure lbs. hrs.
 Oil bbls., 1st 24 hrs.
 Fresh water feet feet
 Salt water feet feet

Casing and Tubing	Used in Drilling	Left in Well	Packers
Size			
16			Kind of Packer
13			
10			Size of
8 1/4			
6 5/8		1973'	Depth set
5 3/16			
3			Perf. top
2		2650'	Perf. bottom
Liners Used			Perf. top
			Perf. bottom

CASING CEMENTED SIZE No. Ft. Date

COAL WAS ENCOUNTERED AT 612 FEET INCHES
 FEET INCHES FEET INCHES
 FEET INCHES FEET INCHES

Formation	Color	Hard or Soft	Top	Bottom	Oil, Gas or Water	Depth Found	Remarks
Pittsburgh Coal			612	619			
Little Dunkard			992	1010			
Big Dunkard			1081	1123			
Gas Sand			1138	1200			
Salt Sand			1280	1365			
Maxon Sand			1765	1798			
Little Lime			1818	1842			
Pencil Cave			1845	1853			
Blue Monday			1893	1901			
Big Lime			1915	19 85			
Big Injun			2005	2068	Gas Oil	2035 2048	
50 Foot Sand			2437	2446			
Gordon Stray			2568	2586	Oil	2573	
Gordon Sand			2606	2621			
Total Depth		2655'					

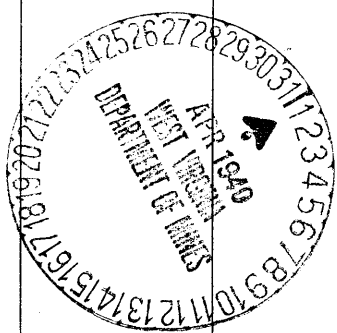

New Milton District, Doddridge County, W. Va.
 By Wm. Moses, 189 W. High St., Salem, W. Va.
 Abandoned under permit no Dod- 312-A.
 On 1400 acres.
 Elevation 1172'L.
 Surface owned by Porter Maxwell, West Union, W. Va.
 6-5/8" casing, 1973'; 2", 2650'.
 Coal encountered at 612'.

312A

Well. Abandonment reported with Dept. of Mines April 1, 1940.
 (Not Dated).

Record to RCT from Mrs. Griffith July 15, 1940.

	Top.	Bottom.
Pittsburgh Coal	612	- 619
Little Dunkard	992	- 1010
Big Dunkard	1081	- 1123
Gas Sand	1138	- 1200
Salt Sand	1280	- 1365
Maxton Sand	1765	- 1798
Little Lime	1818	- 1842
Pencil Cave	1845	- 1853
Blue Monday	1893	- 1901
Big Lime	1915	- 1985
Big Injun (Gas at 2035 & Oil at 2048)	2005	- 2068
50 Foot Sand	2437	- 2446
Gordon Stray (Oil at 2573)	2568	- 2586
Gordon Sand	2606	- 2621
Total Depth		2655.