


771

Latitude 39 20

Longitude 80 45

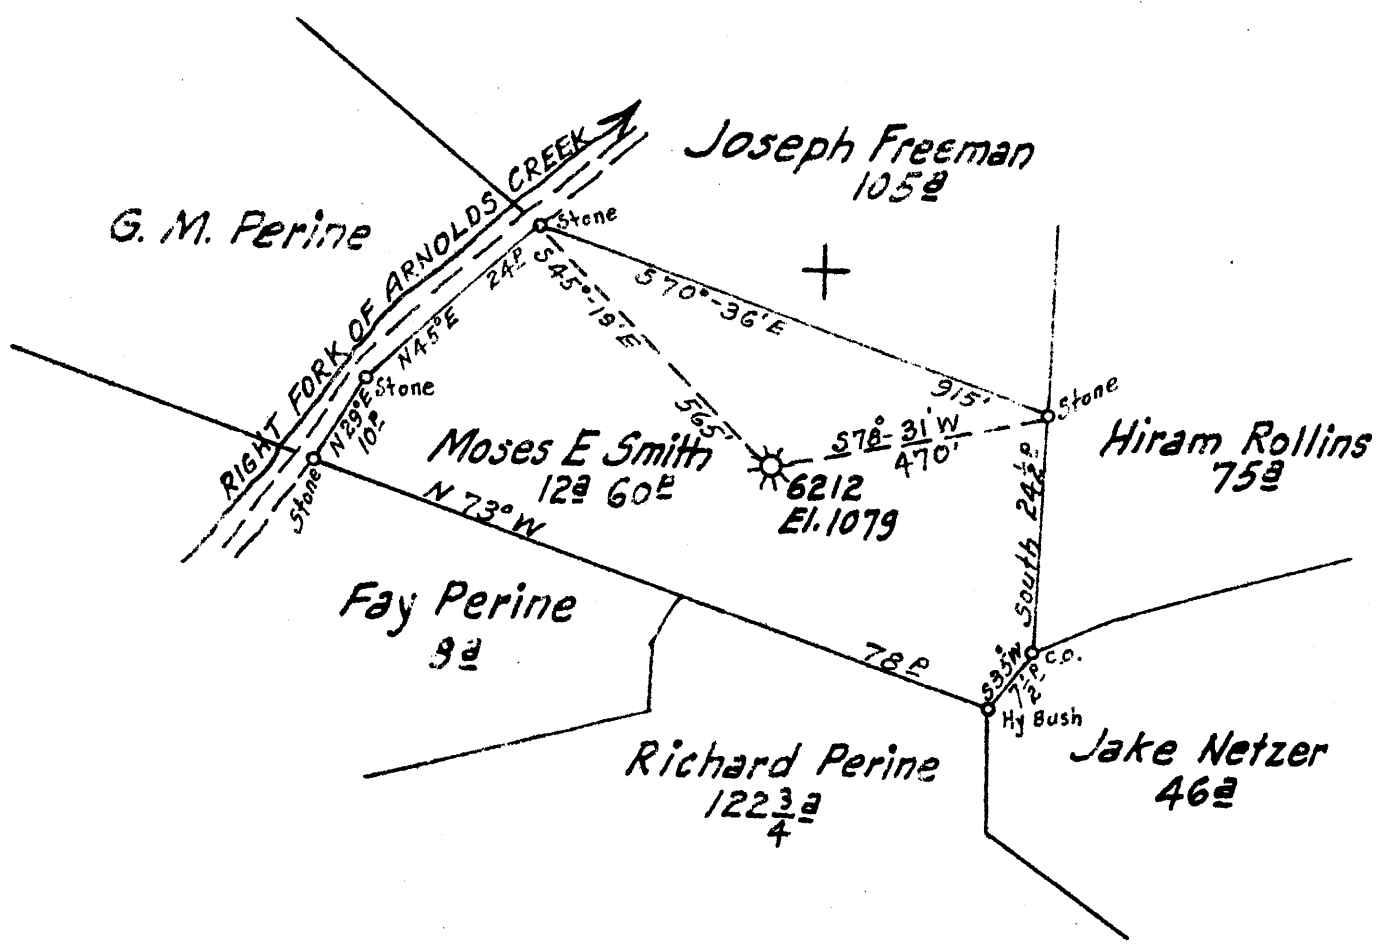

3.02 W.
4.79 S.

New Location
Drill Deeper
Abandonment X

S13 W11 F.B. 688 P-26

Company Hope Natural Gas Co.
 Address Clarksburg, W. Va.
 Farm Moses E. Smith
 Tract Acres 12^a 60^a Lease No. 34604
 Well (Farm) No. Serial No. 6212
 Elevation (Spirit Level) 1079
 Quadrangle West Union
 County Doddridge District West Union
 Engineer W. M. Bowser
 Engineer's Registration No. 900
 File No. Drawing No.
 Date Aug. 1, 1944 Scale 1" = 20'

STATE OF WEST VIRGINIA
DEPARTMENT OF MINES
OIL AND GAS DIVISION
CHARLESTON

WELL LOCATION MAP
FILE NO. DOD-325A

+ Denotes location of well on United States Topographic Maps, scale 1 to 62,500, latitude and longitude lines being represented by border lines as shown.

- Denotes one inch spaces on border line of original tracing.

STATE OF WEST VIRGINIA
DEPARTMENT OF MINES
OIL AND GAS DIVISION

264

AB 325-A
Permit No.

WELL RECORD

Oil or Gas Well Gas
(KIND)


Company Hope Natural Gas Company
Address Clarksburg, W. Va.
Farm Moses W. Smith Acres _____
Location (waters) _____
Well No. 6212 Elev. 1079
District West Union County Doddridge
The surface of tract is owned in fee by _____
Address _____
Mineral rights are owned by _____
Address _____
Drilling commenced 10-18-1922
Drilling completed 11-14-1922
Date shot 11-17-1922 Depth of shot Injun
Open Flow /10ths Water in _____ Inch
/10ths Merc. in _____ Inch
Volume _____ Cu. Ft.
Rock Pressure _____ lbs. _____ hrs.
Oil _____ bbls., 1st 24 hrs.
Fresh water 500 feet _____ feet
Salt water None recorded feet _____ feet

Casing and Tubing	Used in Drilling	Left in Well	Packers
Size			Kind of Packer
16			
13			
10	573	Pulled	Size of
8 1/4	1152	1152	
6 3/4	1949	1949	Depth set
5 3/16			
3			Perf. top
2	2097	Pulled	Perf. bottom
Liners Used			Perf. top
			Perf. bottom

CASING CEMENTED _____ SIZE _____ No. Ft. _____ Date _____
Not cemented

COAL WAS ENCOUNTERED AT 625 FEET 24 INCHES
_____ FEET _____ INCHES _____ FEET _____ INCHES
_____ FEET _____ INCHES _____ FEET _____ INCHES

Formation	Color	Hard or Soft	Top	Bottom	Oil, Gas or Water	Depth Found	Remarks
Murry Up Sand			475	533	Water	500	
Pittsburgh Coal			625	627			
Little Dunkard Sand			990	1002			
Big Dunkard Sand			1095	1124			
Gas Sand			1254	1264			
First Salt Sand			1285	1365			
Second Salt Sand			1400	1445			
Sand			1545	1574			
Maxon Sand			1793	1815	Show oil	1808	
Little Lime			1890	1905			
Pencil Cave			1905	1908			
Big Lime			1939	2017			
Big Injun Sand			2017	2079	Gas	2032-2036-2073-2079	
Total Depth				2097			

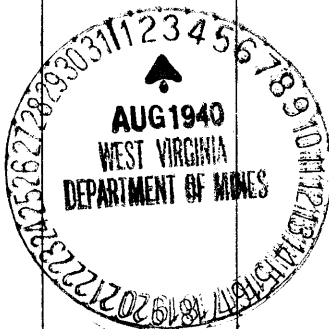

Formation	Color	Hard or Soft	Top	Bottom	Oil, Gas or Water	Depth Found	Remarks

Date August 1, 1940. 194

APPROVED Hope Natural Gas Company Owner

By [Signature] General Supt.
(Title)