


39 12 30

LATITUDE

80 35

LONGITUDE

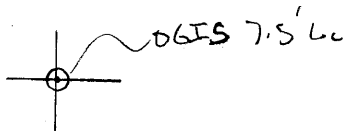

7.5 OGIS topo location

7.5' loc,	<u>2.00 S</u>	15' loc	_____
	<u>1.77 W</u>	(calc.)	_____

Company _____

Farm _____

Quad BIG ISAAC 7.5'

County _____

District Greenbrier

WELL LOCATION MAP

File No. 017-339A

STATE OF WEST VIRGINIA
DEPARTMENT OF MINES
OIL AND GAS DIVISION

277

WELL RECORD

Permit No. 000-339-A

Oil or Gas Well Oil
(Kind)

Company <u>William Moses</u>	Casing and Tubing	Used in Drilling	Left in Well	Packers
Address <u>Salem, W. Va.</u>	Size			
Farm <u>W. A. McClain</u> Acres <u>26a-21p.</u>	16			Kind of Packer
Location (waters)	13			Size of
Well No. <u>3585</u> Elev. <u>1000</u>	10		<u>1380</u>	Depth set
District <u>Greenbrier</u> County <u>Doddridge</u>	8 1/4		<u>1961</u>	Perf. top
The surface of tract is owned in fee by <u>Hope Construction & Refining Co.</u> Address <u>Clarksburg, W. Va.</u>	6%			Perf. bottom
Mineral rights are owned by <u>Wilbur Coal & Coke Co.</u> Address <u>South Bethlehem Pennsylvania.</u>	5 3/16		<u>2057</u>	Perf. top
Drilling commenced	3			Perf. bottom
Drilling completed	2			
Date shot	Liners Used			
Open Flow /10ths Water in				
/10ths Merc. in				
Volume	CASING CEMENTED	SIZE	No. Ft.	Date
Rock Pressure				
Oil	COAL WAS ENCOUNTERED AT <u>565</u>	FEET	INCHES	
Fresh water		FEET	INCHES	
Salt water		FEET	INCHES	

Formation	Color	Hard or Soft	Top	Bottom	Oil, Gas or Water	Depth Found	Remarks
No Coal operations							
Pittsburgh Coal			565	570			
Little Dunkard			1000				
Big Dunkard			1032	1072			
First Salt			1363	1380			
Second Salt			1400	1430			
Third Salt			1560	1660			
Maxon			1800	1815			
Little Lime			1918	1935			
Pencil Cave			1935	1959			
Big Lime			1959	2025			
Big Injun			2025	2055			

Greenbrier District, Doddridge County, W. Va.

By William Moses, Salem, W. Va.

On 26 ac. 21 p.

Elevation, 1000' L.

Surface owned by Hope Construction & Refining Co., Clarksburg, W. Va.,

and minerals by Wilbur Coal & Coke Co., South Bethlehem, Pa.

8 1/2" casing, 1380'; 6 3/8", 1961'; 2" tubing, 2057'; all left in.

Coal was encountered at 565-570'.

Oil well. Abandonment reported to Dept. of Mines (not dated).

Record to RCT from Mrs. Griffith September 28, 1940.

	Top.	Bottom.
Pittsburgh Coal	565	- 570
Little Dunkard Sand	1000	-
Big Dunkard Sand	1072	- 1072
First Salt Sand	1363	- 1380
Second Salt Sand	1400	- 1430
Third Salt Sand	1560	- 1660
Maxton Sand	1800	- 1815
Little Lime	1918	- 1935
Fencil Cave	1935	- 1959
Big Lime	1959	- 2025
Big Injun Sand	2025	- 2055
Total depth		2055