


Latitude 39° 25'

Longitude 80° 40'

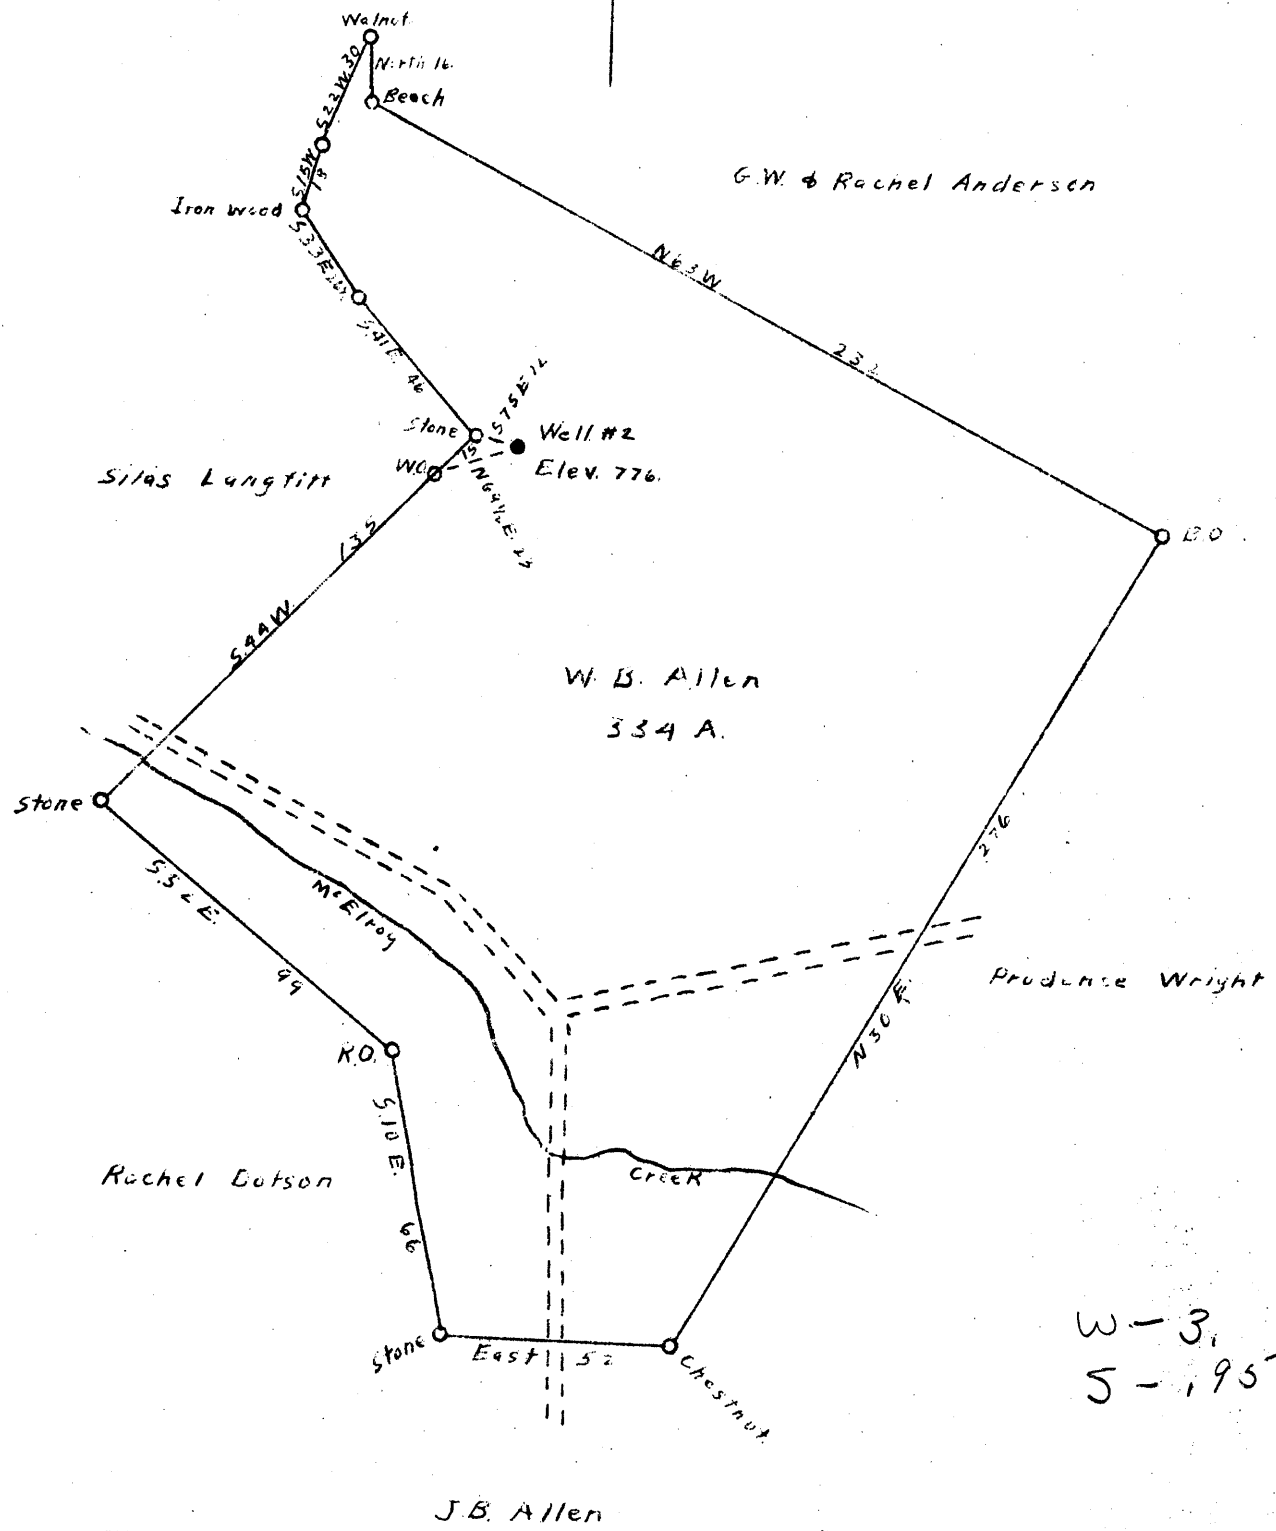

W-3,
5-195

- New Location
- Drill Deeper
- Abandonment

Company William Messes
 Address 189 W Main St. Sylem W. Va.
 Farm W. B. Allen
 Tract _____ Acres 334 Lease No. _____
 Well (Farm) No. Two Serial No. _____
 Elevation (Spirit Level) 776
 Quadrangle Centerpoint W
 County Doddridge District M^cClurg
 Engineer A. R. Wintzell
 Engineer's Registration No. Surveyor, Public Co.
 File No. _____ Drawing No. _____
 Date Sept. 2 1945 Scale 1" = 50 Feet

STATE OF WEST VIRGINIA
 DEPARTMENT OF MINES
 OIL AND GAS DIVISION
 CHARLESTON

WELL LOCATION MAP
 FILE NO. DOD-351A

- + Denotes location of well on United States Topographic Maps, scale 1 to 62,500, latitude and longitude lines being represented by border lines as shown.
- Denotes one inch spaces on border of original tracing.

STATE OF WEST VIRGINIA
DEPARTMENT OF MINES
OIL AND GAS DIVISION

281

WELL RECORD

Ab 351-A
Permit No. 351-A

Oil or Gas Well Oil
(Kind)

Company William Moses
Address Salem, W. Va. (189 W. Main St.)
Farm W. B. Allen Acres 334
Location (waters).....
Well No. Two Elev. 776
District McClellan County Doddridge
The surface of tract is owned in fee by Murphy Oil Co.
Philadelphia Address Pennsylvania
Mineral rights are owned by Underwood Heirs, % Collie
Underwood, Star Route, West Union, W. Va.
Drilling commenced.....
Drilling completed.....
Date shot..... Depth of shot.....
Open Flow /10ths Water in..... Inch
/10ths Merc. in..... Inch
Volume..... Cu. Ft.
Rock Pressure..... lbs..... hrs.
Oil..... bbls., 1st 24 hrs.
Fresh water..... feet..... feet
Salt water..... feet..... feet

Casing and Tubing	Used in Drilling	Left in Well	Packers
Size			
16.....			Kind of Packer.....
13.....			Size of.....
10.....			Depth set.....
8 1/4.....		1322	
6%.....		2218	
5 3/16.....			
3.....			Perf. top.....
2.....		2247	Perf. bottom.....
Liners Used.....			Perf. top.....
			Perf. bottom.....

CASING CEMENTED SIZE..... No. Ft..... Date.....
COAL WAS ENCOUNTERED AT 785 FEET..... INCHES
..... FEET..... INCHES..... FEET..... INCHES
..... FEET..... INCHES..... FEET..... INCHES

Formation	Color	Hard or Soft	Top	Bottom	Oil, Gas or Water	Depth Found	Remarks
Pitts. Coal		785	791				
L. Dunkard		1217					
B. Dunkard		1289	1289				
Maxon		2017	2032				
Little Lime		2135	2152				
Pencil Cave		2152	2177				
Big Lime		2177	2218				
Big Injun		2218	2240				
Total Depth		2247					
No Coal operations in this area.							