

Company Hope Natural Gas Co  
 Address Clarksburg, W. Va.  
 Farm Joshua Beverlin  
 Tract \_\_\_\_\_ Acres 65 Lease No. 23542  
 Well (Farm) No. \_\_\_\_\_ Serial No. 4615  
 Elevation (Spirit Level) 850  
 Quadrangle Centerpoint  
 County Doddridge District McClellan  
 Engineer W. M. Bowers  
 Engineer's Registration No. 900  
 File No. \_\_\_\_\_ Drawing No. \_\_\_\_\_  
 Date Dec 26, 1940 Scale 1" = 30'

STATE OF WEST VIRGINIA  
 DEPARTMENT OF MINES  
 OIL AND GAS DIVISION  
 CHARLESTON  
**WELL LOCATION MAP**  
 FILE NO. DOD-355A  
 + Denotes location of well on United States Topographic Maps, scale 1" to 62,500, latitude and longitude lines being represented by border lines as shown  
 - Denotes one inch spaces on border line of original tracing.

STATE OF WEST VIRGINIA  
DEPARTMENT OF MINES  
OIL AND GAS DIVISION

789

WELL RECORD


AD 355-A  
Permit No. ....

Oil or Gas Well Gas  
(KIND)

Company <u>Hope Natural Gas Company.</u>	Casing and Tubing	Used in Drilling	Left in Well	Packers
Address <u>445 West Main St. Clarksburg, W. Va.</u>	Size			
Farm <u>Joshua Beverlin</u> Acres <u>80</u>	16.....			Kind of Packer.....
Location (waters) <u>Talkington Fork</u>	13.....			
Well No. <u>4615</u> Elev. <u>850'</u>	10.....	<u>240</u>	<u>Pulled</u>	Size of.....
District <u>McClellan</u> County <u>Doddridge</u>	8 1/4.....	<u>1150</u>	<u>1150</u>	Depth set.....
The surface of tract is owned in fee by.....	6%.....	<u>1868</u>	<u>1866</u>	
Address.....	5 3/16.....	<u>2351</u>	<u>2351</u>	
Mineral rights are owned by.....	3.....			Perf. top.....
Address.....	2.....	<u>2646</u>	<u>Pulled</u>	Perf. bottom.....
Drilling commenced <u>Jan. 8, 1917</u>	Liners Used.....			Perf. top.....
Drilling completed <u>Mar. 14, 1917</u>				Perf. bottom.....
Date shot..... Depth of shot.....				
Open Flow /10ths Water in..... Inch				
/10ths Merc. in..... Inch				
Volume..... Cu. Ft.				
Rock Pressure..... lbs..... hrs.				
Oil..... bbls., 1st 24 hrs.				
Fresh water <u>None recorded</u> feet..... feet				
Salt water <u>None recorded</u> feet..... feet				

CASING CEMENTED Not cemented SIZE..... No. Ft..... Date.....  
COAL WAS ENCOUNTERED AT 454 FEET 72 INCHES  
..... FEET..... INCHES..... FEET..... INCHES  
..... FEET..... INCHES..... FEET..... INCHES

Formation	Color	Hard or Soft	Top	Bottom	Oil, Gas or Water	Depth Found	Remarks
Native Coal			70	71			
Pittsburgh Coal			454	460			
Little Dunkard			890	920			
Big Dunkard			1010	1022			
Gas Sand			1050	1105			
First Salt Sand			1180	1230			
Second Salt Sand			1340	1410			
Maxon Sand			1675	1685			
Little Lime			1735	1745			
Pencil Cave			1745	1750			
Big Lime			1750	1818			
Big Injun Sand			1818	1955	Gas	1902-1906	
Berea Sand			2073	2078			
Gantz Sand			2121	2200			
Fifty Foot			2322	2354			
Gordon Stray			2538	2553			
Gordon Sand			2590	2605	Gas	2596-2598	
Fourth Sand			2618	2623	Gas	2620	
Total Depth				2646			

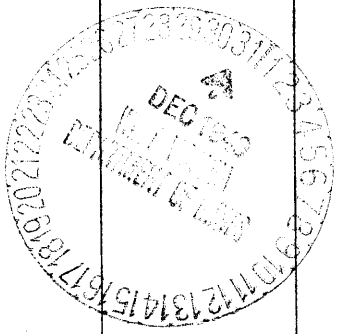

Formation	Color	Hard or Soft	Top	Bottom	Oil, Gas or Water	Depth Found	Remarks

Date Dec. 28, 1940, 194

APPROVED Hope Natural Gas Company., Owner

By *[Signature]* Gen. Sup't.  
(Title)